

O.D.O.T. DISTRICT 2 SURVEY OFFICE (USE ONLY)

PERSONNEL

REFERENCE NO. 157

SHEET 4 OF 25

NOTES VAN DUSEN

DATE 8/14/00

ROUTE SR 163

H.C. ROUSOS

WEATHER CLOUDY

COUNTY OTTAWA

R.C. ADAM B.

TEMP. 70°

TOWNSHIP DANBURY

DWG BY MILLER

PID PVTRAIN

SECTION 6

T 6 N R 18 E

TYPE MONUMENT P.K. NAIL

ON SURFACE - ~~BELOW~~ ON

OFFSET 0.5' LT : ~~RT~~

9.4 TO LT EDGE PAVEMENT

STATION: 2112+98


HORZ.DATUM: NAD83 2011

GEOID: NAVD88 2012A

GRID: NORTHING: 673319.050


EASTING: 1904240.379

NOTE:
THIS MAP IS FOR ODOT PURPOSES ONLY.
TO INDEX REFERENCE TIES, AND DOES NOT
REPRESENT TRUE LAND SUBDIVISION.

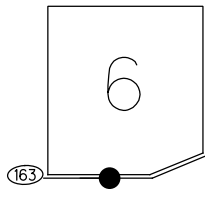

RECORD:
FD P.K.NAIL
8/14/00, BVD
SET P.K./WASHER
4/3/01, BVD
DNF-CALC
REF157
9/18/18, JFO
2/8/19, JFO

SR 163/CR 135

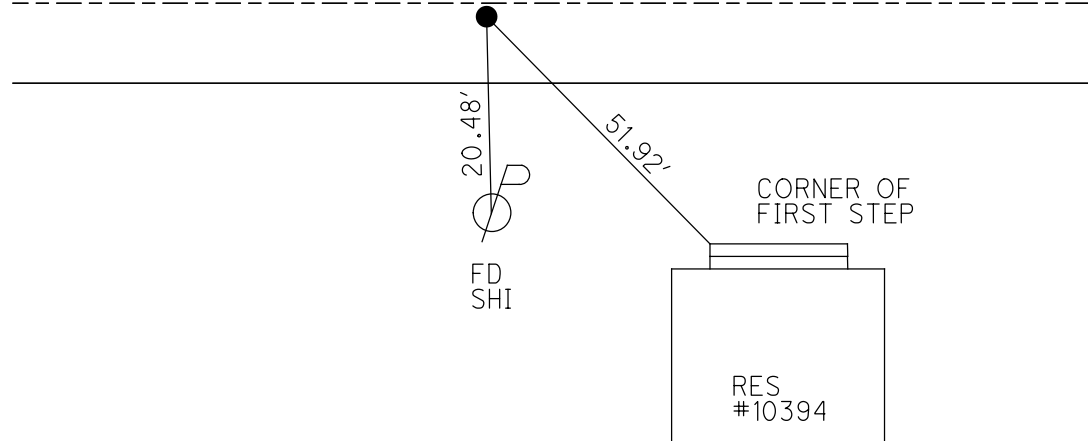


O.D.O.T. DISTRICT 2 SURVEY OFFICE (USE ONLY)

PERSONNEL _____ REFERENCE NO. 157 SHEET 4 OF 25
 NOTES VAN DUSEN DATE 8/14/00 ROUTE SR 163
 H.C. ROUSOS WEATHER CLOUDY COUNTY OTTAWA
 R.C. ADAM B. TEMP. 70° TOWNSHIP DANBURY
 DWG BY MILLER PID NO PID SECTION 6
 T 6 N R 18 E

TYPE MONUMENT P.K. NAIL
 ON SURFACE - ~~BELOW~~ ON _____
 OFFSET C PAVEMENT 0.5 LT : ~~RT~~
9.4 TO LT EDGE PAVEMENT
 STATION: 2112+98


HORZ. DATUM: NAD83 2011 GEOID: NAVD88 2012A
 GRID: NORTHING: 673319.050 EASTING: 1904240.379

NOTE:
THIS MAP IS FOR ODOT PURPOSES ONLY
TO INDEX REFERENCE TIES, AND DOES NOT
REPRESENT TRUE LAND SUBDIVISION.

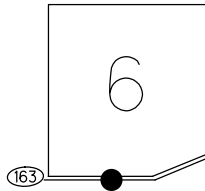

RECORD:
 FD P.K.NAIL
 8/14/00, BVD
 SET P.K./WASHER
 4-3-01, BVD
 DNF-CALC
 REF157
 9-18-18, JFO

C SR 163/CR 135

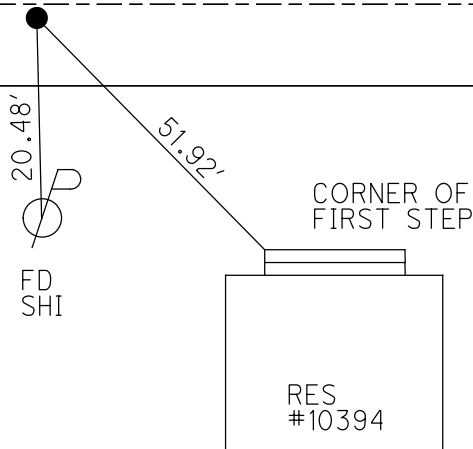

O.D.O.T. DISTRICT 2 SURVEY OFFICE

PERSONNEL

REFERENCE NO. 157

SHEET 3 OF 22

NOTES VAN DUSEN

H.C. Rousos

R.C. ADAM B.

DATE 8-14-00

WEATHER CLOUDY

TEMP. + 70°F

ROUTE 163

COUNTY OTTAWA

TOWNSHIP DANBURY

SECTION 1

T. 6 N. R. 18 E.


TYPE MONUMENT PK NAIL

ON SURFACE - BELOW YES

LEFT - & PAW'T. - RIGHT 0.5

9.4 TO LT. EDGE PAVEMENT

S.L.M. 2112+98

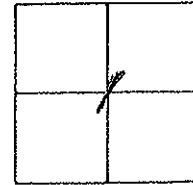

SET PK & WASHER
4-3-01
B.V.D.

