


O.D.O.T. DISTRICT 2 SURVEY OFFICE (USE ONLY)

PERSONNEL _____ REFERENCE NO. 158 SHEET 5 OF 25
 NOTES RHOADES DATE 9/18/18 ROUTE SR 163
 H.C. O'DONNELL WEATHER SUNNY COUNTY OTTAWA
 R.C. MILLER TEMP. 80° TOWNSHIP DANBURY
 DWG BY NIESE PID PVTRAIN SECTION 6
 T 6 N R 18 E


TYPE MONUMENT MAG NAIL
 ON SURFACE - ~~BELOW~~ ON
 OFFSET Q PAVEMENT 1.5' LT : ~~RT~~
8.0' TO LT EDGE PAVEMENT
 STATION: 2120+45

HORIZ.DATUM: NAD83 2011 GEOID: NAVD88 2012A
 GRID: NORTHING: 673311.193 EASTING: 1903496.436

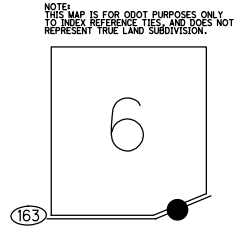

RECORD:
 FD P.K.NAIL
 8/14/00, BVD
 SET P.K./WASHER
 4-3-01, BVD
 FD MAG NAIL
 REF158
 9-18-18
 2/8/19, JFO
 2/7/22, JFO

Q SR 163/CR 135

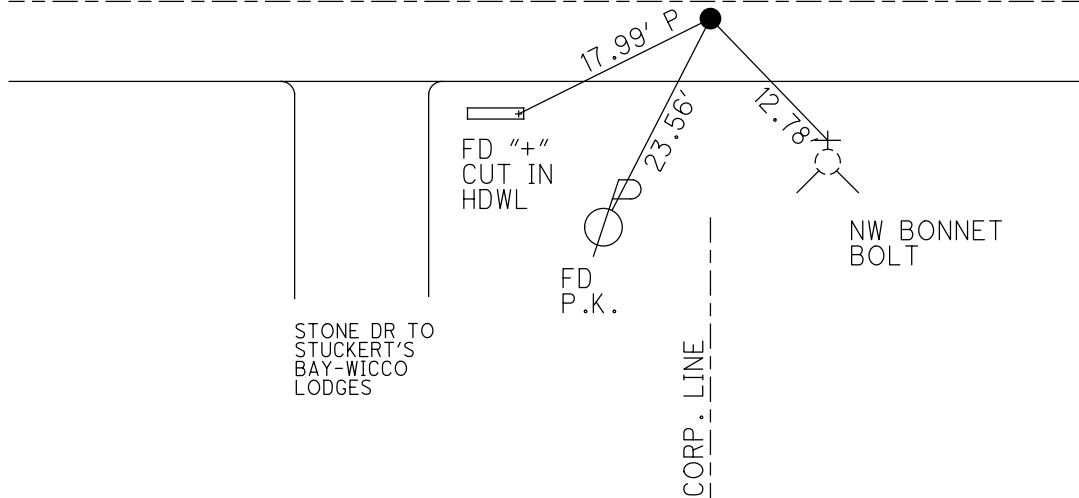


O.D.O.T. DISTRICT 2 SURVEY OFFICE (USE ONLY)


PERSONNEL _____ REFERENCE NO. 158 SHEET 5 OF 25
 NOTES RHOADES DATE 9/18/18 ROUTE SR 163
 H.C. O'DONNELL WEATHER SUNNY COUNTY OTTAWA
 R.C. MILLER TEMP. 80° TOWNSHIP DANBURY
 DWG BY MILLER PID NO PID SECTION 6
 T 6 N R 18 E

TYPE MONUMENT MAG NAIL
 ON SURFACE - ~~BELOW~~ ON _____
 OFFSET \varnothing PAVEMENT 1.5' LT : ~~RT~~
8.0' TO LT EDGE PAVEMENT
 STATION: 2120+45

HORIZ.DATUM: NAD83 2011 GEOID: NAVD88 2012A
 GRID: NORTHING: 673311.193 EASTING: 1903496.436

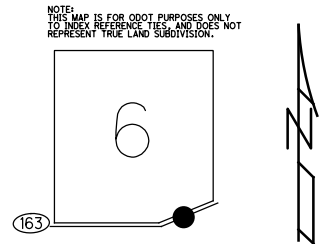

RECORD:
 FD P.K.NAIL
 8/14/00, BVD
 SET P.K./WASHER
 4-3-01, BVD
 FD MAG NAIL
 REF158
 9-18-18
 2/8/19, JFO

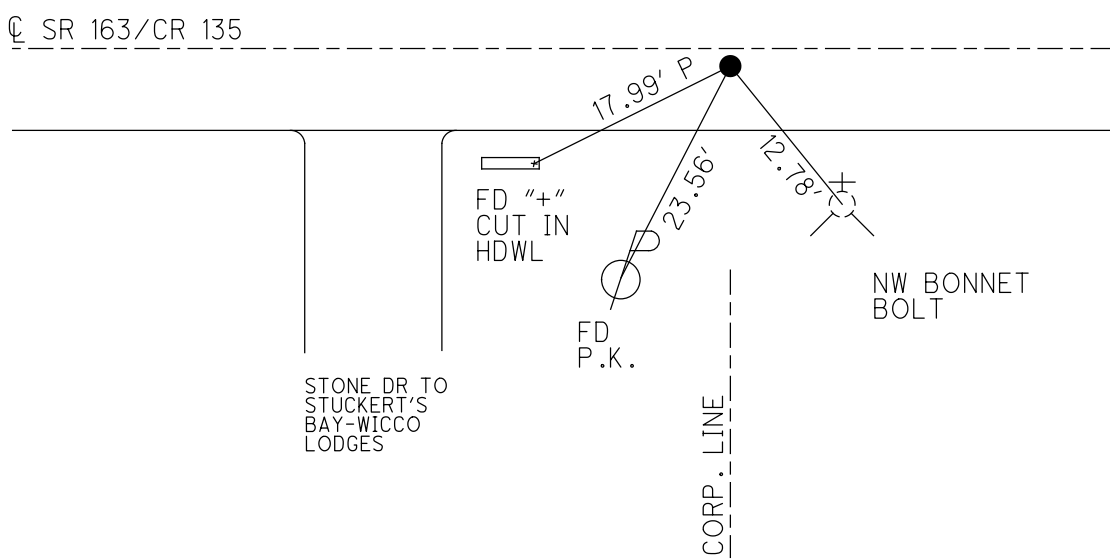

O.D.O.T. DISTRICT 2 SURVEY OFFICE

PERSONNEL

REFERENCE NO. 158

SHEET 4 OF 22

NOTES VAN DUSEN

H.C. Rousos

R.C. ADAM B.

DATE 8-14-00

WEATHER Cloudy

TEMP. +70°F

ROUTE 163

COUNTY OTTAWA

TOWNSHIP DANBURY

SECTION 1

T. 6 N. R. 18 E.


TYPE MONUMENT P.K. NAIL

ON SURFACE - BELOW YES

LEFT - & PAW'T. - RIGHT 2.0'

8.0' TO LT. EDGE PAVEMENT

S.L.M. 2120+45

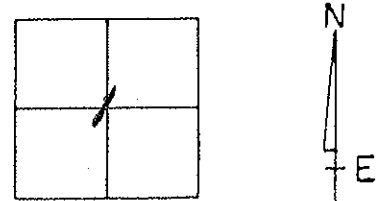

SET PK& WASHER
4-3-01
BUR

