



O.D.O.T. DISTRICT 2 SURVEY OFFICE (USE ONLY)

PERSONNEL _____ REFERENCE NO. 159 SHEET 6 OF 25
 NOTES RHOADES DATE 9/19/18 ROUTE SR 163
 H.C. MILLER WEATHER SUNNY COUNTY OTTAWA
 R.C. O'DONNELL TEMP. 68° TOWNSHIP DANBURY
 DWG BY NIESE PID PVTRAIN SECTION 6
 T 6 N R 18 E


TYPE MONUMENT P.K./WASHER
 ON SURFACE - ~~BELOW~~ ON
 OFFSET 9.5 TO LT EDGE PAVEMENT
 STATION: 2127+75

HORIZ.DATUM: NAD83 2011 GEOID: NAVD88 2012A
 GRID: NORTHING: 673305.076 EASTING: 1902770.206

NOTE:
THIS MAP IS FOR ODOT PURPOSES ONLY
TO INDEX REFERENCE TIES, AND DOES NOT
REPRESENT TRUE LAND SUBDIVISION.

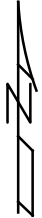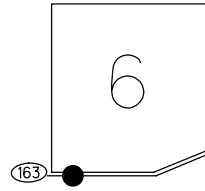

RECORD:
 FD P.K./WASHER
 8/14/00, BVD
 SET P.K./WASHER
 4/3/01, BVD
 FD P.K./WASHER
 REF159
 9/19/18, JFO
 2/7/22, JFO

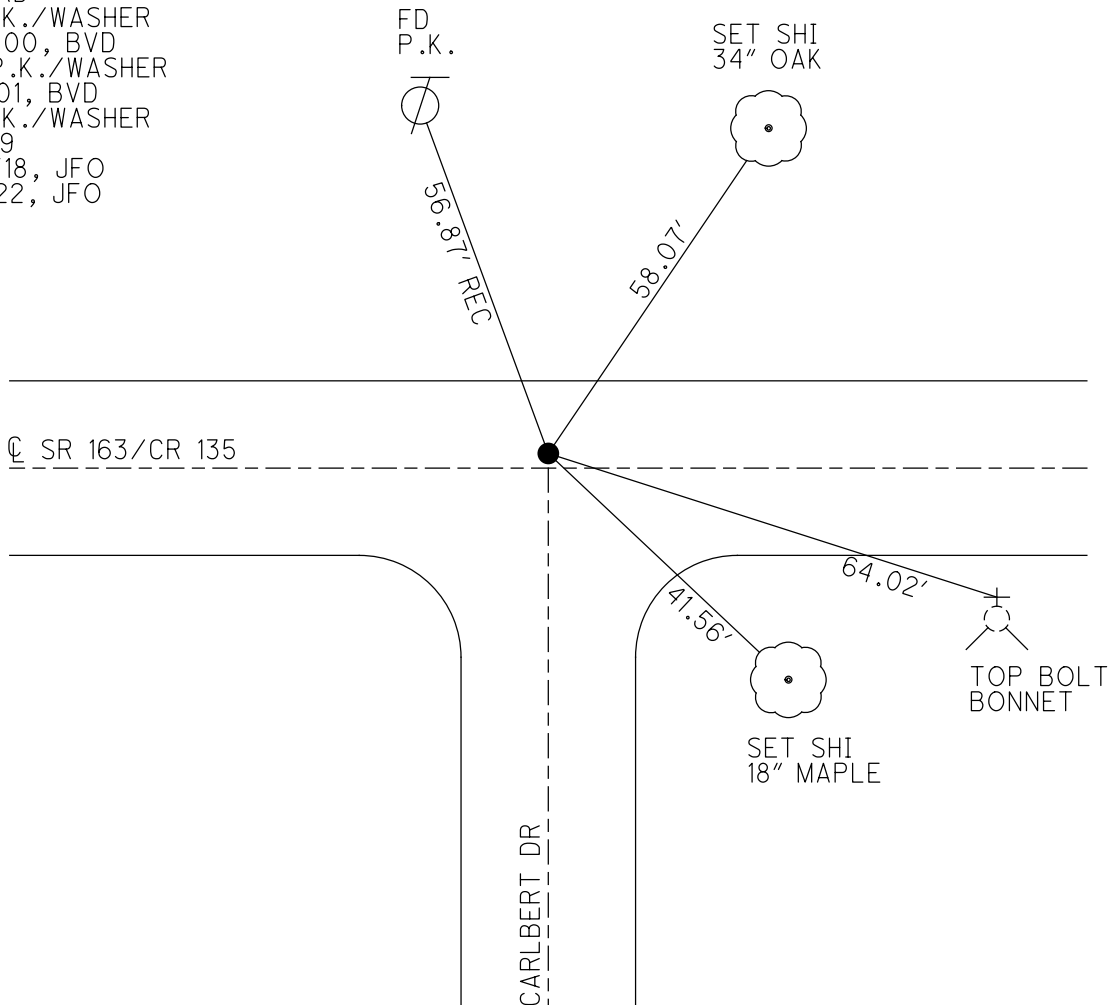


O.D.O.T. DISTRICT 2 SURVEY OFFICE (USE ONLY)

PERSONNEL _____ REFERENCE NO. 159 SHEET 6 OF 25
 NOTES RHOADES DATE 9/19/18 ROUTE SR 163
 H.C. MILLER WEATHER SUNNY COUNTY OTTAWA
 R.C. O'DONNELL TEMP. 68° TOWNSHIP DANBURY
 DWG BY MILLER PID NO PID SECTION 6
 T 6 N R 18 E


TYPE MONUMENT P.K./WASHER
 ON SURFACE - ~~BELOW~~ ON _____
 OFFSET \odot PAVEMENT 1' ~~LT~~ : RT
9.5 TO LT EDGE PAVEMENT
 STATION: 2127+75

HORZ. DATUM: NAD83 2011 GEOID: NAVD88 2012A
 GRID: NORTHING: 673305.076 EASTING: 1902770.206

NOTE:
THIS MAP IS FOR ODOT PURPOSES ONLY.
IT IS NOT TO BE USED AS A REFERENCE, TIES, AND DOES NOT
REPRESENT TRUE LAND SUBDIVISION.

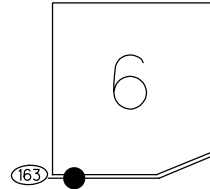

RECORD:
 FD P.K./WASHER
 8/14/00, BVD
 SET P.K./WASHER
 4-3-01, BVD
 FD P.K./WASHER
 REF159
 9-19-18, JFO

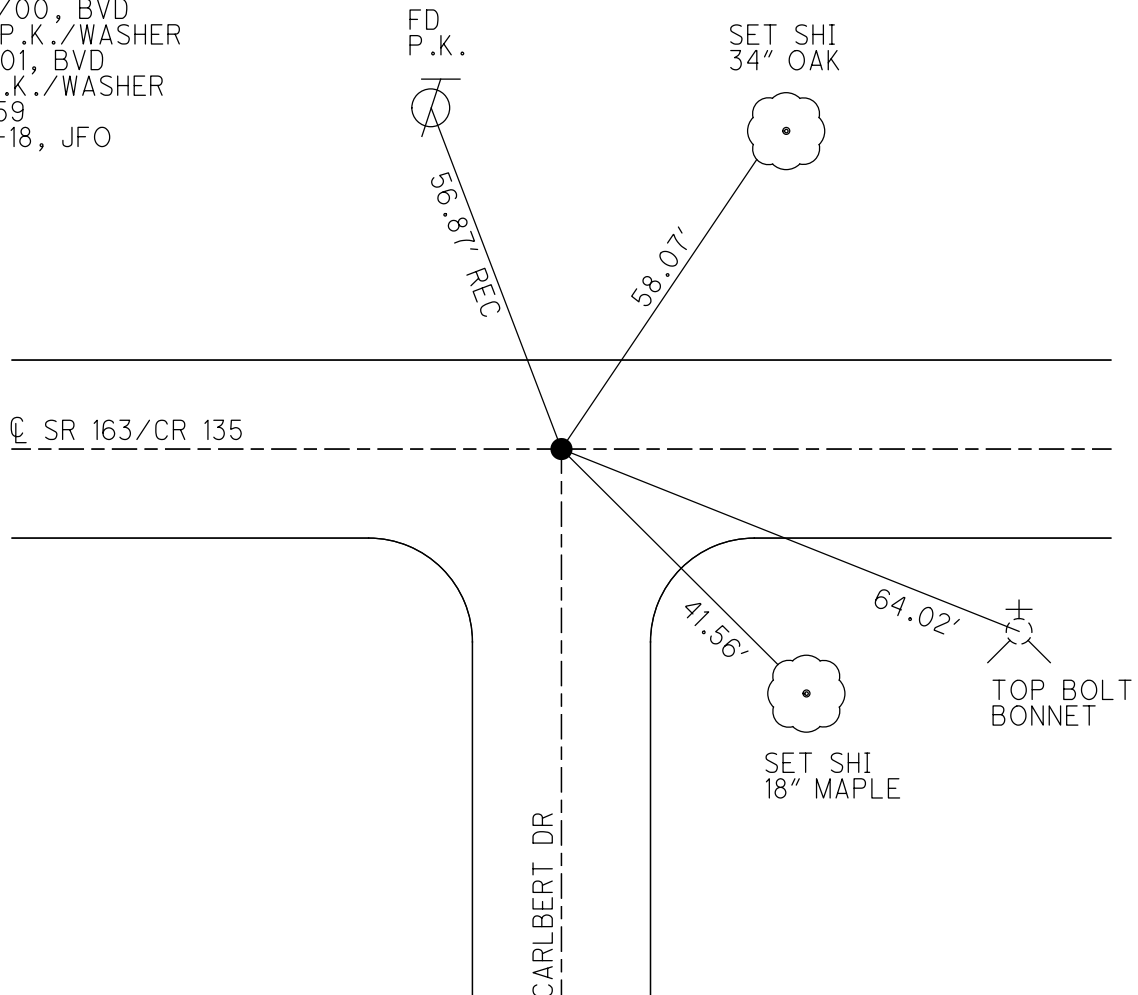

O.D.O.T. DISTRICT 2 SURVEY OFFICE

PERSONNEL

REFERENCE NO. 159

SHEET 5 OF 22

NOTES VAN DUSEN

H.C. Rousos

R.C. ADAM B.

DATE 8-14-00

WEATHER CLOUDY

TEMP. +20° F

ROUTE 163

COUNTY OTTAWA

TOWNSHIP DANBURY

SECTION 1

T. 6 N. R. 18 E


TYPE MONUMENT P.K. & WASHER

ON SURFACE - BELOW YES


LEFT - & PAV'T. - RIGHT YES

9.5 TO RT. EDGE PAVEMENT

S.L.M. 2127+75

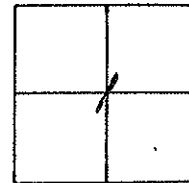

SET PK & WASHER
4-3-01
B.V.R.

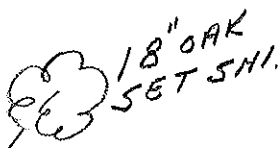

PAV'T S.R.
EAST BAYSHARE
(C.R. 135)

ROAD 163

CARLBERT DR.
(PRIVATE)

