


O.D.O.T. DISTRICT 2 SURVEY OFFICE (USE ONLY)


PERSONNEL \_\_\_\_\_ REFERENCE NO. 160 SHEET 7 OF 25  
 NOTES RHOADES DATE 9/19/18 ROUTE SR 163  
 H.C. MILLER WEATHER SUNNY COUNTY OTTAWA  
 R.C. O'DONNELL TEMP. 68° TOWNSHIP DANBURY  
 SECTION 6  
 DWG BY MILLER PID PVTRAIN T 6 N R 18 E

TYPE MONUMENT LG. R.R SPIKE  
 ON SURFACE - ~~BELOW~~ ON  
 OFFSET ☉ PAVEMENT 1.0' ~~RT~~ : RT  
8.7' TO LT EDGE PAVEMENT  
 STATION: 2131+35

HORZ.DATUM: NAD83 2011 GEOID: NAVD88 2012A  
 GRID: NORTHING: 673300.541 EASTING: 1902413.172

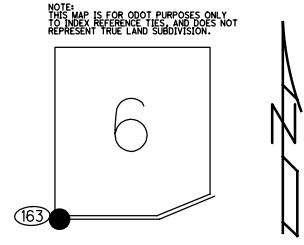

RECORD: P.I.  
 STA.285+83.62  
 FD P.K.NAIL  
 8/14/00, BVD  
 SET P.K./WASHER  
 4/3/01, BVD  
 FD LG.R.R.SPIKE  
 REF160  
 9/19/18, JFO  
 2/8/19, JFO  
 2/7/22, JFO

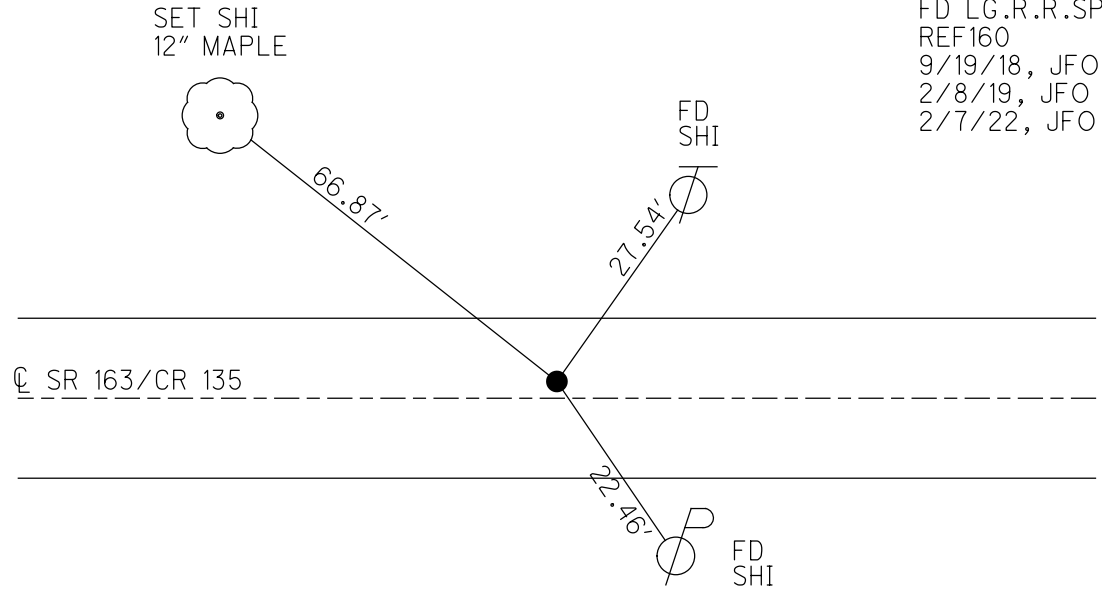

O.D.O.T. DISTRICT 2 SURVEY OFFICE (USE ONLY)

PERSONNEL

REFERENCE NO. 160

SHEET 7 OF 25

NOTES RHOADES

DATE 9/19/18

ROUTE SR 163

H.C. MILLER

WEATHER SUNNY

COUNTY OTTAWA

R.C. O'DONNELL

TEMP. 68°

TOWNSHIP DANBURY

DWG BY MILLER

PID NO PID

SECTION 6

T 6 N R 18 E

TYPE MONUMENT LG. R.R SPIKE

ON SURFACE - ~~BELOW~~ ON \_\_\_\_\_

OFFSET  $\text{C}$  PAVEMENT 1' ~~LT~~ : RT

8.7' TO LT EDGE PAVEMENT

STATION: 2131+35


HORZ.DATUM: NAD83 2011

GEOID: NAVD88 2012A


GRID: NORTHING: 673300.541

EASTING: 1902413.172

NOTES:  
THIS MAP IS FOR QDOT PURPOSES ONLY  
TO INDEX REFERENCE TIES, AND DOES NOT  
REPRESENT TRUE LAND SUBDIVISION.

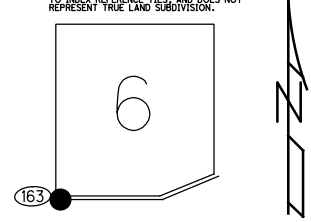

RECORD: P.I.  
STA.285+83.62  
FD P.K.NAIL  
8/14/00, BVD  
SET P.K./WASHER  
4-3-01, BVD  
FD LG.R.R.SPIKE  
REF160  
9-19-18  
2/8/19, JFO

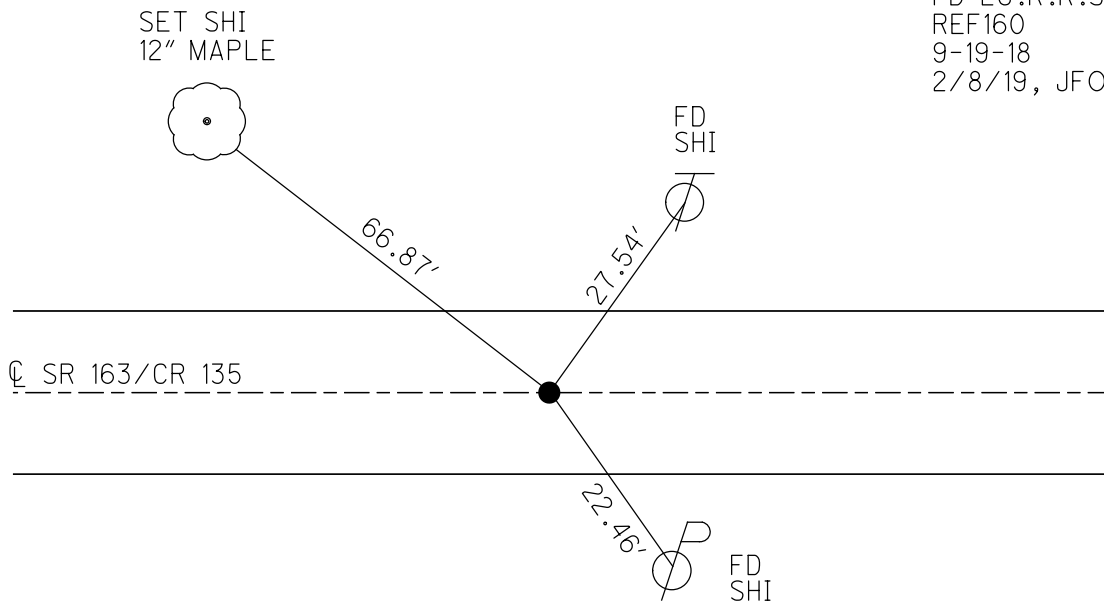

O.D.O.T. DISTRICT 2 SURVEY OFFICE

PERSONNEL

REFERENCE NO. 160 SHEET 6 OF 22

NOTES VAN DUSEN

H.C. Rousos

R.C. Adam B.

DATE 8-19-00

WEATHER Cloudy

TEMP. +70° F

ROUTE 163

COUNTY OTTAWA

TOWNSHIP DANBURY

SECTION 1

T. 6 N. R. 18 E


TYPE MONUMENT P.K. NAIL

ON SURFACE - BELOW YES

LEFT - & PAV'T. - RIGHT YES

8.7 TO RT. EDGE PAVEMENT

S.L.M. 2131+3.5

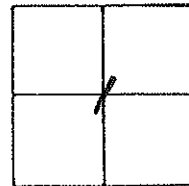

REC.: PI  
PLAN STA.  
285+83.62  
PER. CO. PLANS

SET PK'S WASHER  
4-3-01  
BVD

