


O.D.O.T. DISTRICT 2 SURVEY OFFICE (USE ONLY)

PERSONNEL _____ REFERENCE NO. 163 SHEET 10 OF 25
 NOTES RHOADES DATE 9/19/18 ROUTE SR 163
 H.C. MILLER WEATHER SUNNY COUNTY OTTAWA
 R.C. O'DONNELL TEMP. 68° TOWNSHIP DANBURY
 DWG BY MILLER PID PVTRAIN SECTION 10
 T 6 N R 18 E


TYPE MONUMENT P.K./WASHER
 ON SURFACE - ~~BELOW~~ ON
 OFFSET 0 PAVEMENT 1' LT : ~~RT~~
8.8' TO LT EDGE PAVEMENT
 STATION: 2145+58

NOTE:
THIS MAP IS FOR CDOT PURPOSES ONLY.
IT DOES NOT REPRESENT TRUE LAND SUBDIVISION.

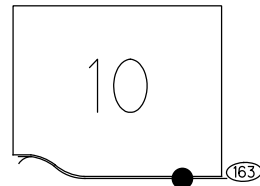

HORIZ.DATUM: NAD83 2011 GEOID: NAVD88 2012A
 GRID: NORTHING: 673275.340 EASTING: 1900993.028

RECORD:
 FD LG.R.R.SPIKE
 8/14/00, BVD
 SET P.K./WASHER
 4-3-01, BVD
 FD P.K./WASHER
 REF163
 9-19-18
 2/8/19, JFO

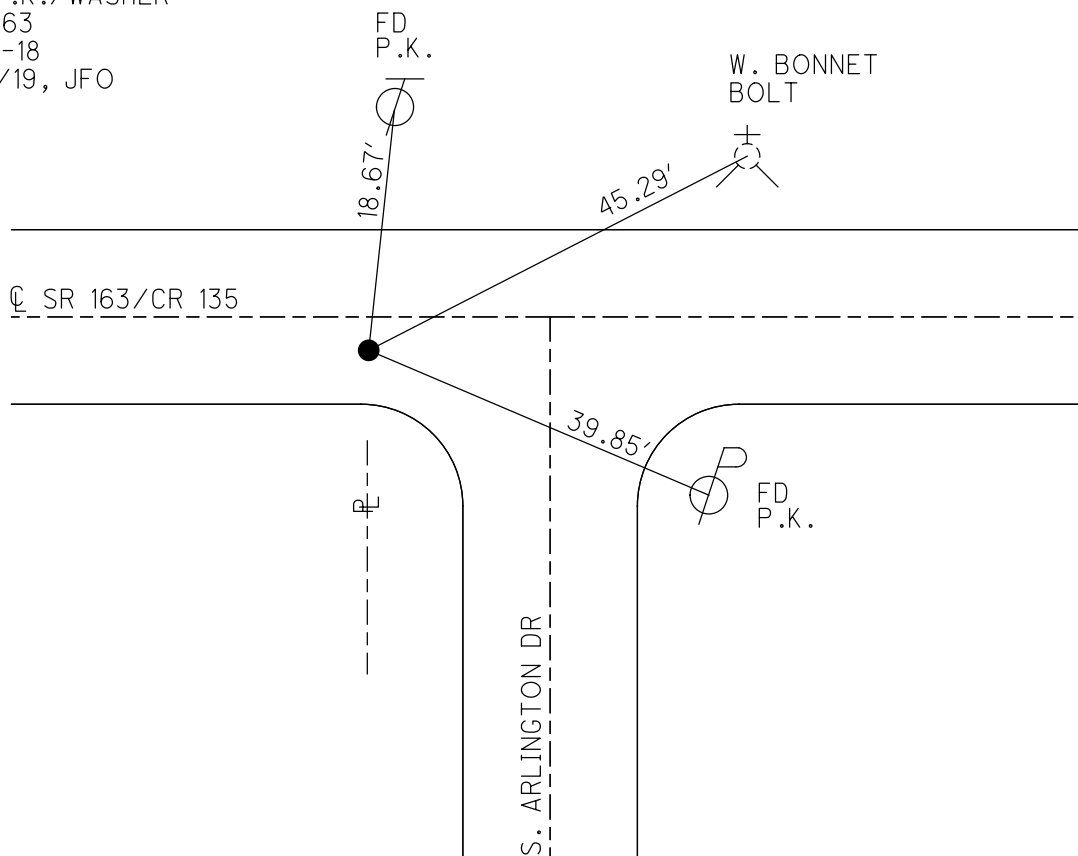


O.D.O.T. DISTRICT 2 SURVEY OFFICE (USE ONLY)

PERSONNEL _____ REFERENCE NO. 163 SHEET 10 OF 25
 NOTES RHOADES DATE 9/19/18 ROUTE SR 163
 H.C. MILLER WEATHER SUNNY COUNTY OTTAWA
 R.C. O'DONNELL TEMP. 68° TOWNSHIP DANBURY
 SECTION 10
 DWG BY MILLER PID NO PID T 6 N R 18 E


TYPE MONUMENT P.K./WASHER
 ON SURFACE - ~~BELOW~~ ON _____
 OFFSET \odot PAVEMENT 1' LT : ~~RT~~
8.8' TO LT EDGE PAVEMENT
 STATION: 2145+58

NOTE: THIS MAP IS FOR CDOT PURPOSES ONLY. TO INDEX REFERENCE TIES, AND DOES NOT REPRESENT TRUE LAND SUBDIVISION.

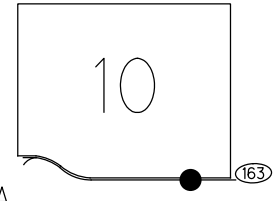

HORZ.DATUM: NAD83 2011 GEOID: NAVD88 2012A
 GRID: NORTHING: 673275.340 EASTING: 1900993.028

RECORD:
 FD LG.R.R.SPIKE
 8/14/00, BVD
 SET P.K./WASHER
 4-3-01, BVD
 FD P.K./WASHER
 REF163
 9-19-18
 2/8/19, JFO

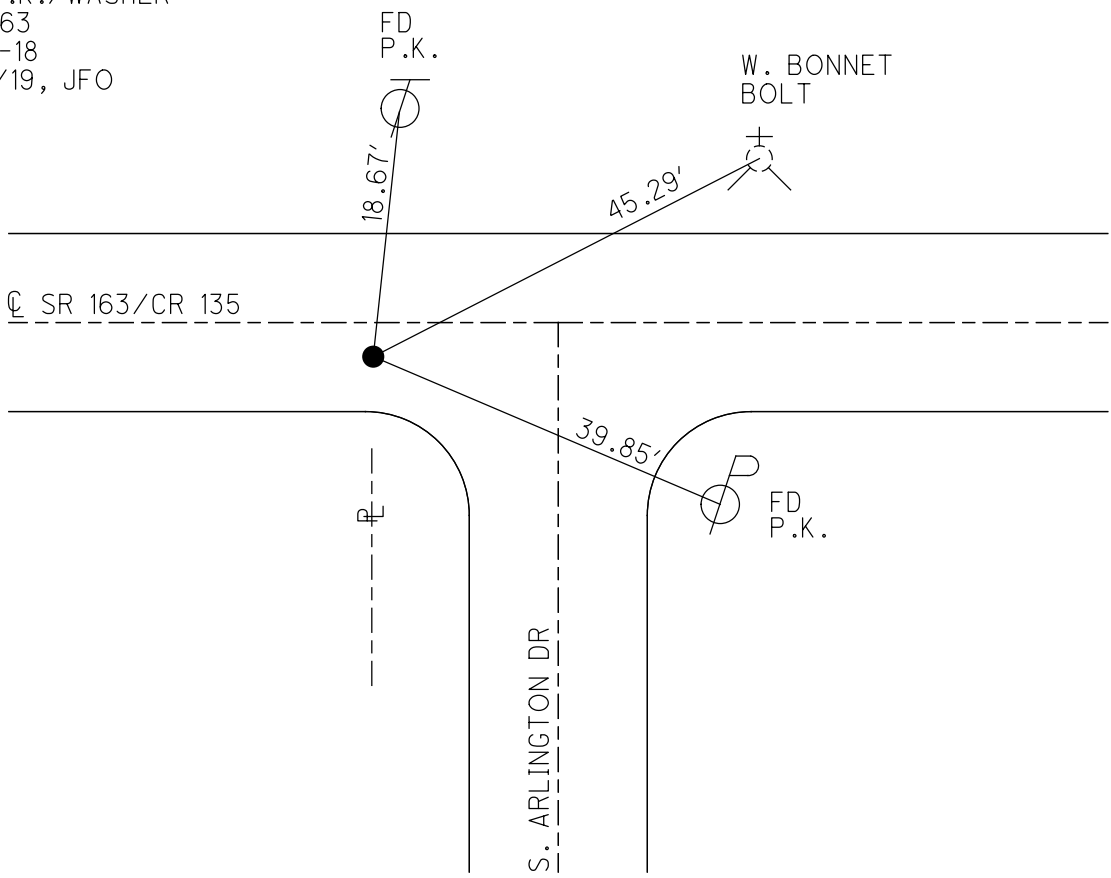

O.D.O.T. DISTRICT 2 SURVEY OFFICE

PERSONNEL

REFERENCE NO. 163

SHEET 9 OF 22

NOTES VAN DUSEN

H.C. Rousos

R.C. ADAM B.

DATE 8-14-00

WEATHER CLOUDY

TEMP. +80° F

ROUTE 163

COUNTY ST TAWA

TOWNSHIP DAN BURY

SECTION 1

T6 NR 18 E


TYPE MONUMENT L.G. R.R. SPK.

ON SURFACE - BELOW YES

LEFT- & PAV'T. - RIGHT 1.0'

8.8 TOLZ. EDGE PAVEMENT

S.L.M. 2145+58

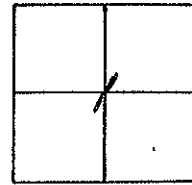

SET PK & WASHER
4-3-01
B.V.D

