

O.D.O.T. DISTRICT 2 SURVEY OFFICE (USE ONLY)

PERSONNEL _____ REFERENCE NO. 170 SHEET 17 OF 25
 NOTES RHOADES DATE 9/19/18 ROUTE SR 163
 H.C. MILLER WEATHER SUNNY COUNTY OTTAWA
 R.C. O'DONNELL TEMP. 73° TOWNSHIP DANBURY
 DWG BY MILLER PID PVTRAIN SECTION 10
 T 6 N R 18 E

TYPE MONUMENT 1" IPIPE

~~ON SURFACE~~ - BELOW 1'

OFFSET \odot PAVEMENT _____ LT : ~~RT~~



40' LT TO LT EDGE PAVEMENT

STATION: 2169+44

HORZ. DATUM: NAD83 2011 GEOID: NAVD88 2012A


GRID: NORTHING: _____ EASTING: _____

NOTE:
THIS MAP IS FOR CDDT PURPOSES ONLY
TO INDEX REFERENCE TIES, AND DOES NOT
REPRESENT TRUE LAND SUBDIVISION.

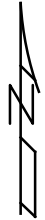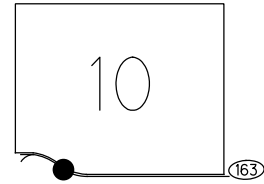

RECORD: P.I.
 STA. 247+99.34
 FD 1" IPIPE
 1' DOWN
 8/14/00, SAH
 4-3-01, BVD
 DNF
 9-19-18, JFO

DIST. 170-170A= 61.62' P

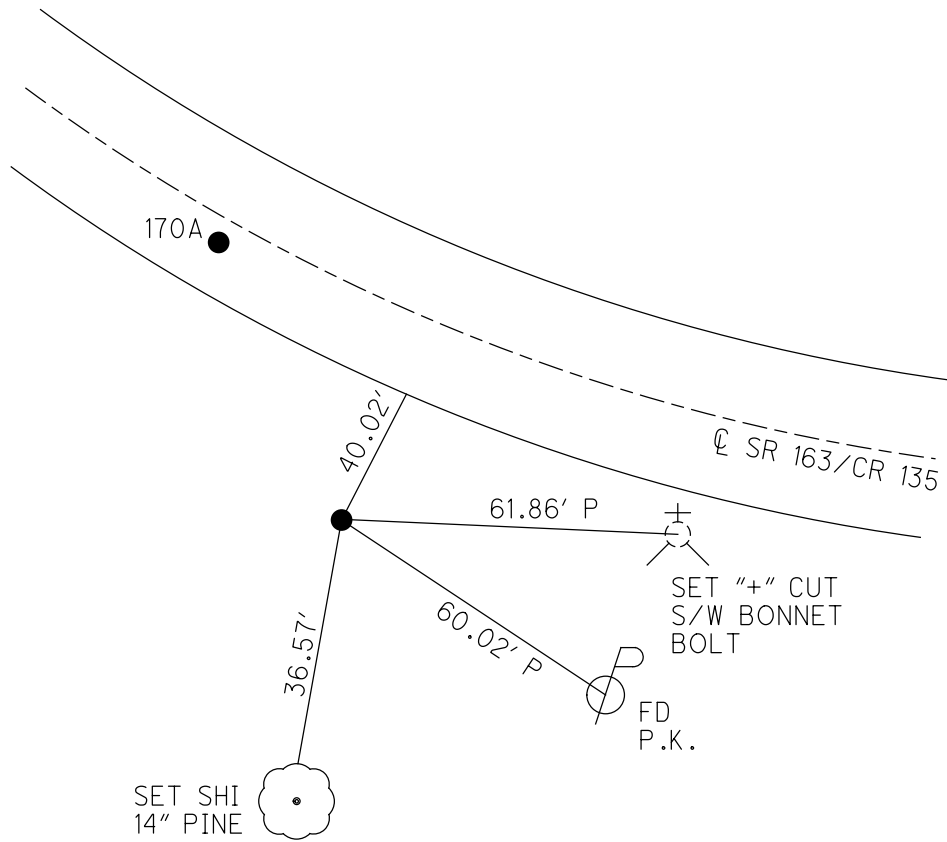

O.D.O.T. DISTRICT 2 SURVEY OFFICE (USE ONLY)

PERSONNEL

REFERENCE NO. 170

SHEET 17 OF 25

NOTES RHOADES DATE 9/19/18
 H.C. MILLER WEATHER SUNNY
 R.C. O'DONNELL TEMP. 73°

ROUTE SR 163
 COUNTY OTTAWA
 TOWNSHIP DANBURY
 SECTION 10
 T 6 N R 18 E

DWG BY MILLER PID NO PID

TYPE MONUMENT 1" IPIPE

~~ON SURFACE~~ - BELOW 1'

OFFSET \odot PAVEMENT _____ LT : ~~RT~~

40' LT TO LT EDGE PAVEMENT

STATION: 2169+44



HORIZ. DATUM: NAD83 2011

GEOID: NAVD88 2012A

GRID: NORTHING: _____


EASTING: _____

NOTE:
THIS MAP IS FOR CDOT PURPOSES ONLY
TO CHECK REFERENCE TIES, AND DOES NOT
REPRESENT TRUE LAND SUBDIVISION.

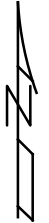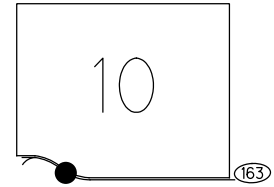

RECORD: P.I.
 STA. 247+99.34
 FD 1" IPIPE
 1' DOWN
 8/14/00, SAH
 4-3-01, BVD
 DNF
 9-19-18, JFO

DIST. 170-170A= 61.62' P

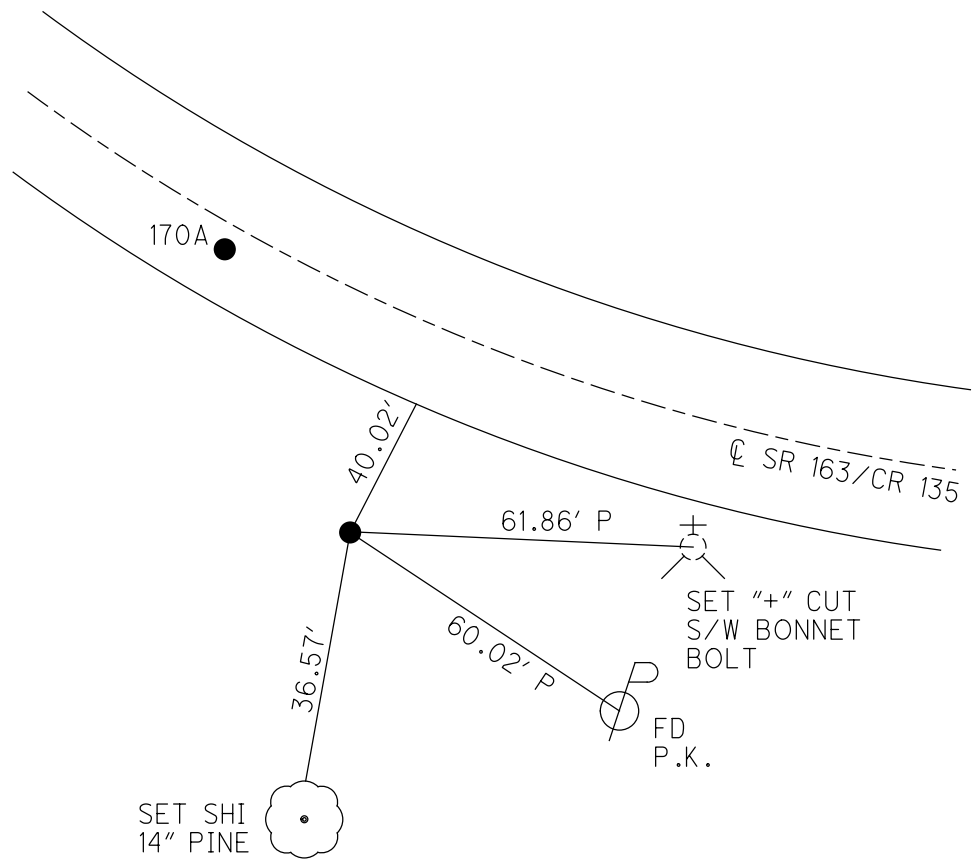

O.D.O.T. DISTRICT 2 SURVEY OFFICE

PERSONNEL

REFERENCE NO. 170

SHEET 16 OF 22

NOTES Huss

H.C. CORDES

R.C. KARGER

DATE 8-14-00

WEATHER CLOUDY

TEMP. +80° F

ROUTE 163

COUNTY OTTAWA


TOWNSHIP DANBURY

SECTION 1

T.6 N. R.18 E

TYPE MONUMENT PI, 1" IRON PIPE
PT B" MAG. NAIL
 ON SURFACE - BELOW PI 1.0' BELOW
 LEFT - & PAV'T. - RIGHT PT. B" ON SURFACE

P.T. B
2.6' TO LT. EDGE PAVEMENT PT. A" 40.02' LT. OF LT. EAP
S.L.M. PT. A" 2169+44 PT. B" 2.0' LT. OF &
PT. B" 2169+74

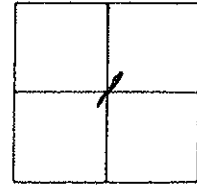

REC. PI
 PLAN STA. 247+99.34
 PER CO. PLANS

FD. IRON PIPE
 4-3-01
 BUD

