

O.D.O.T. DISTRICT 2 SURVEY OFFICE (USE ONLY)

PERSONNEL

REFERENCE NO. 172A

SHEET 21 OF 25

NOTES RHOADES

DATE 9/20/18

ROUTE SR 163

H.C. MILLER

WEATHER CLOUDY

COUNTY OTTAWA

R.C. O'DONNELL

TEMP. 70°

TOWNSHIP DANBURY

DWG BY MILLER PID PVTRAIN

SECTION 10

T 6 N R 18 E

TYPE MONUMENT MAG/WASHER


ON SURFACE - ~~BELOW~~ ON

OFFSET Q PAVEMENT 2.8' LT : ~~RT~~

9.2' TO RT EDGE PAVEMENT

STATION: 2175+65.5

NOTE:  
THIS MAP IS FOR ODOT PURPOSES ONLY  
TO INDEX REFERENCE THIS AND DOES NOT  
REPRESENT TRUE LAND SUBDIVISION.

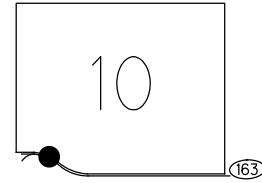

HORZ. DATUM: NAD83 2011


GEOID: NAVD88 2012A

GRID: NORTHING: 673628.792

EASTING: 1898081.570

DIST. 172-172A= 7.49'

RECORD:  
FD P.K.NAIL  
8/14/00, BVD  
SET P.K./WASHER  
4-3-01, BVD  
SET MAG/WASHER  
REFA172  
9-20-18  
2/8/19, JFO

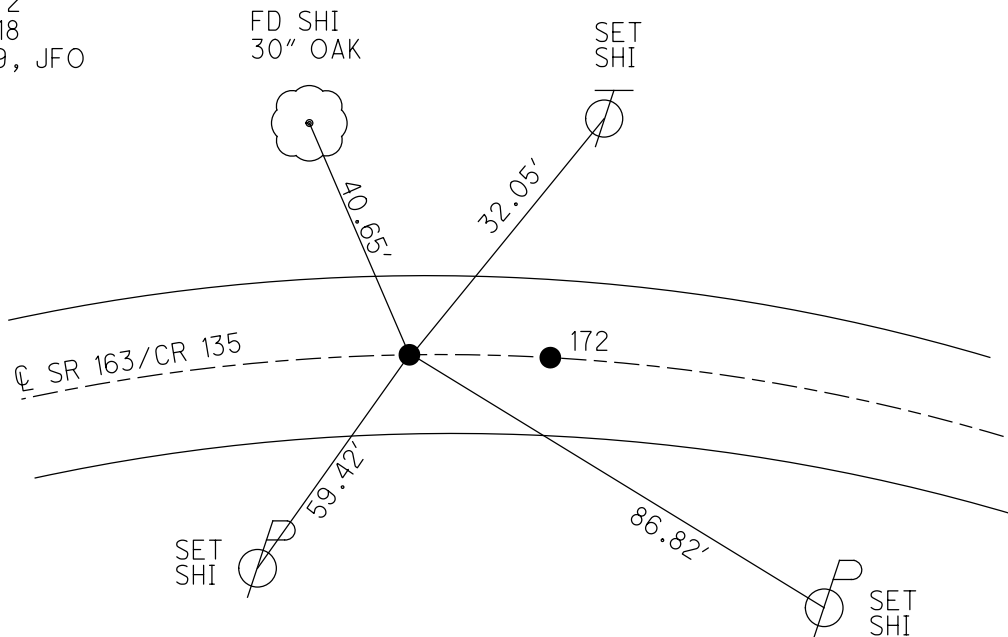


O.D.O.T. DISTRICT 2 SURVEY OFFICE (USE ONLY)

PERSONNEL \_\_\_\_\_ REFERENCE NO. 172A SHEET 21 OF 25  
 NOTES RHOADES DATE 9/20/18 ROUTE SR 163  
 H.C. MILLER WEATHER CLOUDY COUNTY OTTAWA  
 R.C. O'DONNELL TEMP. 70° TOWNSHIP DANBURY  
 DWG BY MILLER PID NO PID SECTION 10  
 T 6 N R 18 E

TYPE MONUMENT MAG/WASHER  
 ON SURFACE - ~~BELOW~~ ON \_\_\_\_\_  
 OFFSET CL PAVEMENT 2.8' LT : ~~RT~~  
9.2' TO RT EDGE PAVEMENT  
 STATION: 2175+65.5


NOTE:  
THIS MAP IS FOR ODOT PURPOSES ONLY  
TO INDEX REFERENCE TIES, AND DOES NOT  
REPRESENT TRUE LAND SUBDIVISION.

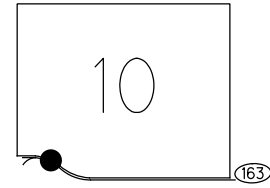

HORIZ.DATUM: NAD83 2011 GEOID: NAVD88 2012A  
 GRID: NORTHING: 673628.792 EASTING: 1898081.570

DIST. 172-172A= 7.49'

RECORD:  
 FD P.K.NAIL  
 8/14/00, BVD  
 SET P.K./WASHER  
 4-3-01, BVD  
 SET MAG/WASHER  
 REFA172  
 9-20-18  
 2/8/19, JFO

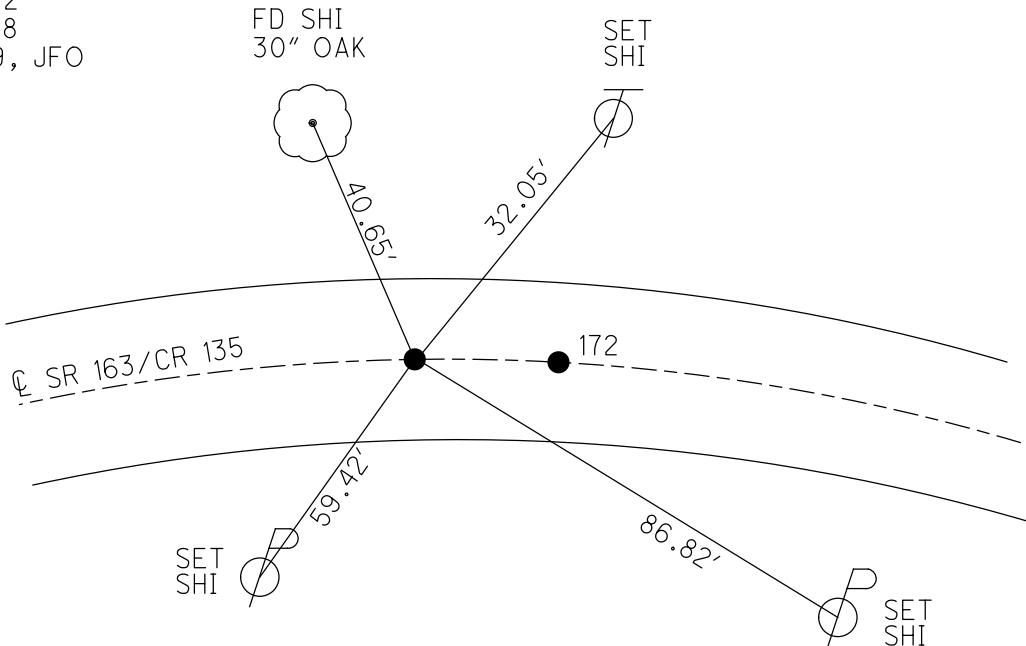

O.D.O.T. DISTRICT 2 SURVEY OFFICE

PERSONNEL

REFERENCE NO. 172

SHEET 18 OF 22

NOTES VAN DUSEN

H.C. Rousos

R.C. ADAM B.

DATE 8-14-00

WEATHER SUNNY

TEMP. +80° F

ROUTE 163

COUNTY OTTAWA

TOWNSHIP DANBURY

SECTION 1

T. 6 N R. 18 E


TYPE MONUMENT PK NAILS

ON SURFACE - ~~BELOW~~ YES

LEFT - & PAV'T. - RIGHT YES

9.2 TO RT. EDGE PAVEMENT

S.L.M. P.T. A = 2175+58 P.T. B = 2175+65.5

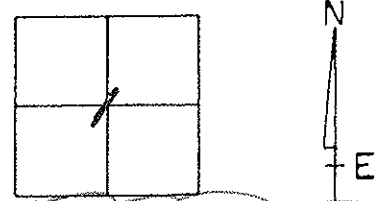

SET PK WASHER  
4-03-01  
BVD

