
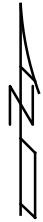


O.D.O.T. DISTRICT 2 SURVEY OFFICE (USE ONLY)

PERSONNEL \_\_\_\_\_ REFERENCE NO. 174 SHEET 23 OF 25  
 NOTES RHOADES DATE 9/20/18 ROUTE SR 163  
 H.C. MILLER WEATHER CLOUDY COUNTY OTTAWA  
 R.C. O'DONNELL TEMP. 70° TOWNSHIP DANBURY  
 DWG BY NIESE PID PVTRAIN SECTION 10  
 T 6 N R 18 E


TYPE MONUMENT MAG/WASHER  
 ON SURFACE - ~~BELOW~~ ON  
 OFFSET  $\text{C}$  PAVEMENT 1.5'  $\text{RT}$  : RT  
9.2' TO RT EDGE PAVEMENT  
 STATION: 2177+94

NOTE:  
THIS MAP IS FOR ODOT PURPOSES ONLY  
TO INDEX REFERENCE TIES, AND DOES NOT  
REPRESENT TRUE LAND SUBDIVISION.

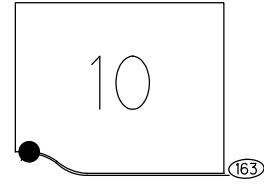

HORIZ.DATUM: NAD83 2011 GEOID: NAVD88 2012A  
 GRID: NORTHING: 673710.228 EASTING: 1897870.359

RECORD:  
 FD P.K.NAIL  
 8/14/00, BVD  
 SET P.K./WASHER  
 4/3/01, BVD  
 SET MAG/WASHER  
 REF174  
 9/20/18, JFO  
 FD MAG/WASHER  
 2/8/19, JFO  
 2/7/22, JFO

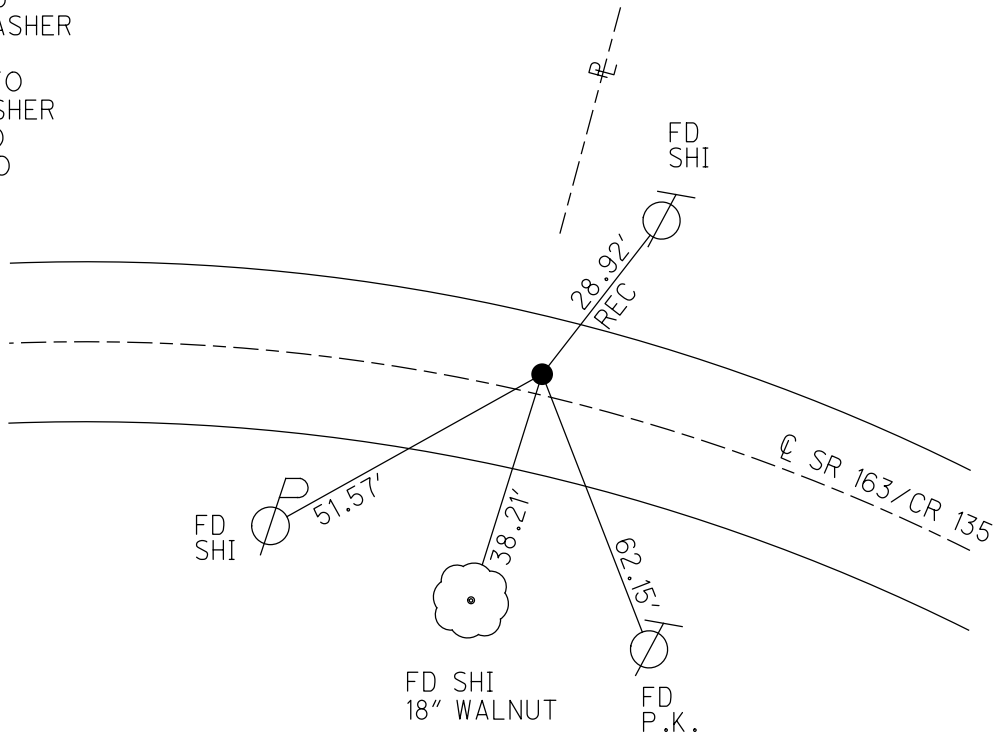


O.D.O.T. DISTRICT 2 SURVEY OFFICE (USE ONLY)

PERSONNEL \_\_\_\_\_ REFERENCE NO. 174 SHEET 23 OF 25  
 NOTES RHOADES DATE 9/20/18 ROUTE SR 163  
 H.C. MILLER WEATHER CLOUDY COUNTY OTTAWA  
 R.C. O'DONNELL TEMP. 70° TOWNSHIP DANBURY  
 DWG BY MILLER PID NO PID SECTION 10  
 T 6 N R 18 E


TYPE MONUMENT MAG/WASHER  
 ON SURFACE - ~~BELOW~~ ON \_\_\_\_\_  
 OFFSET ☉ PAVEMENT 1.5' ~~LT~~ : RT  
9.2' TO RT EDGE PAVEMENT  
 STATION: 2177+94

NOTE: THIS MAP IS FOR GOVT PURPOSES ONLY TO INDEX REFERENCE TIES, AND DOES NOT REPRESENT TRUE LAND SUBDIVISION.

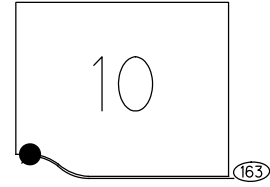

HORZ.DATUM: NAD83 2011 GEOID: NAVD88 2012A  
 GRID: NORTHING: 673710.228 EASTING: 1897870.359

RECORD:  
 FD P.K.NAIL  
 8/14/00, BVD  
 SET P.K./WASHER  
 4-3-01, BVD  
 SET MAG/WASHER  
 REF174  
 9-20-18, JFO  
 FD MAG/WASHER  
 2/8/19, JFO

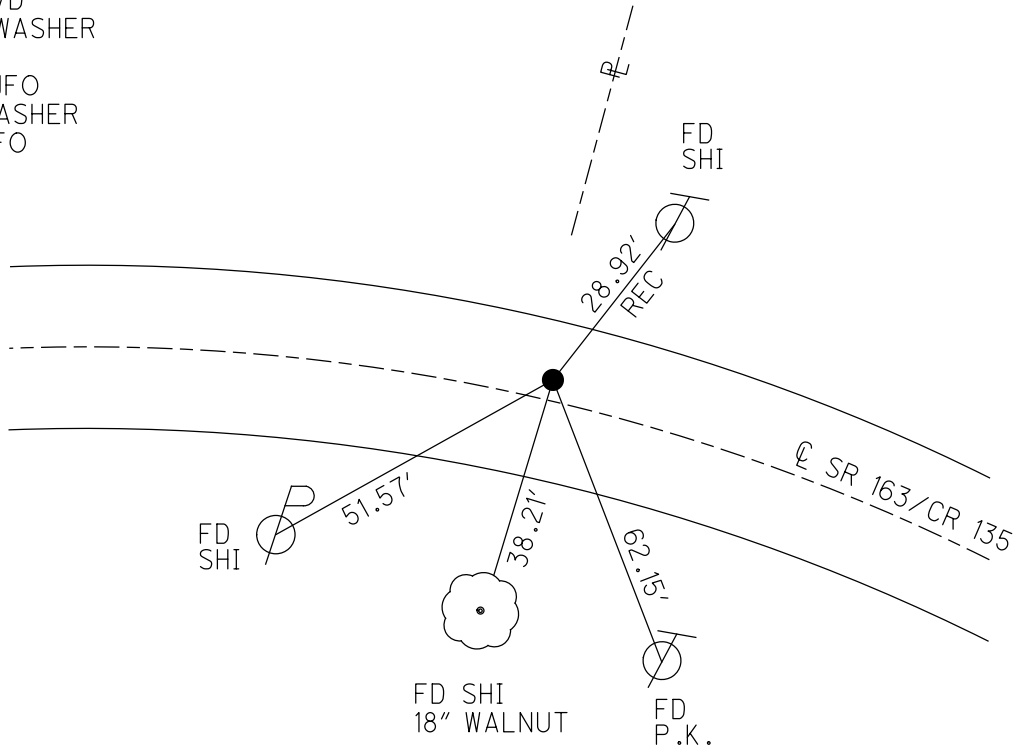

O.D.O.T. DISTRICT 2 SURVEY OFFICE

PERSONNEL

REFERENCE NO. 174

SHEET 20 OF 22

NOTES VAN DUSEN

H.C. Rousos

R.C. ADAM B.

DATE 8-14-00

WEATHER CLOUDY

TEMP. +70°F

ROUTE 163

COUNTY OTTAWA

TOWNSHIP DANBURY

SECTION 1

T. 6 N R. 18 E


TYPE MONUMENT P.K. NAIL

ON SURFACE - BELOW YES


LEFT - & PAV'T. - RIGHT 1.5

9.2 TO RT. EDGE PAVEMENT

S.L.M. 2177+94

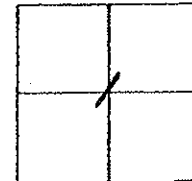

SET PK & WASHER  
4-3-01  
BVD

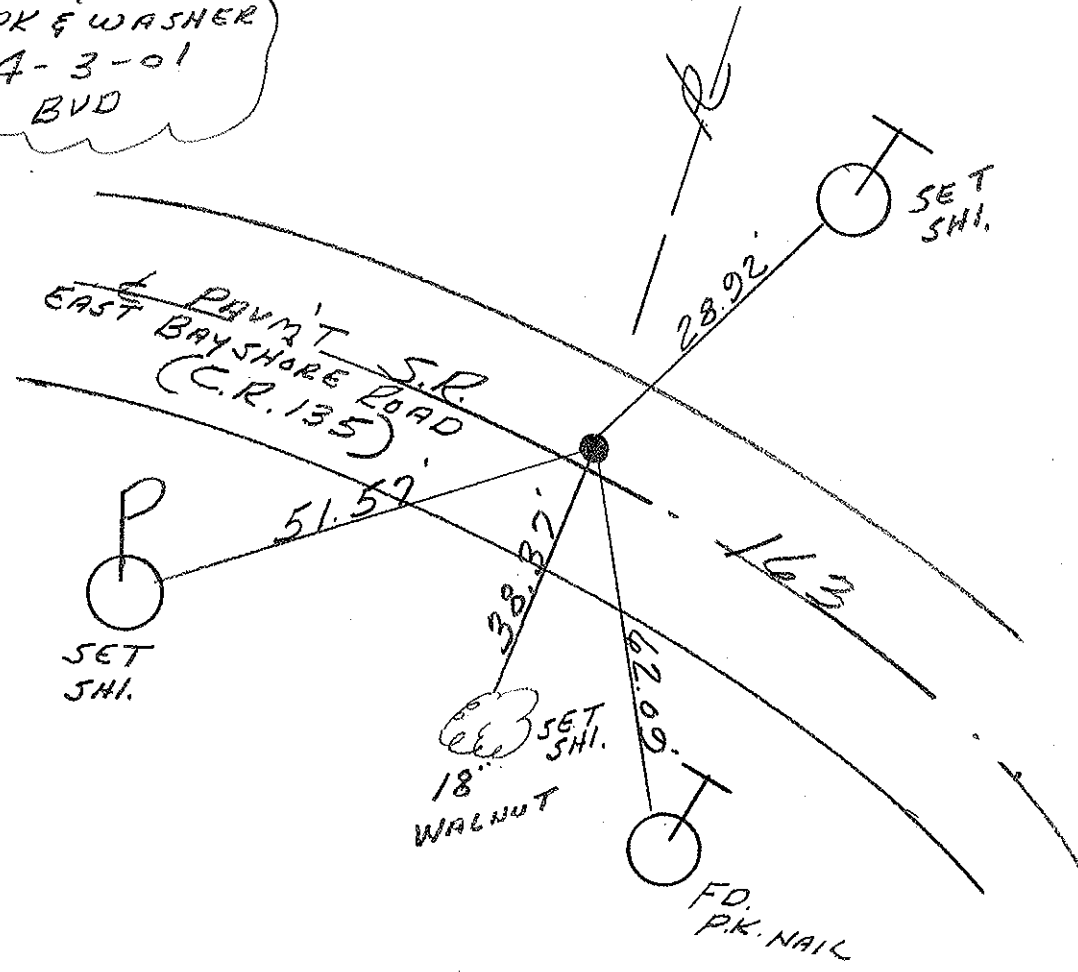

18"  
WALNUT