


O.D.O.T. DISTRICT 2 SURVEY OFFICE (USE ONLY)


PERSONNEL	REFERENCE NO. <u>4</u>	SHEET <u>4</u> OF <u>7</u>
NOTES <u>LUMBREZER</u>	DATE <u>4/29/11</u>	ROUTE <u>OLD SR 269</u>
H.C. <u>MOSER</u>	WEATHER <u>CLOUDY</u>	COUNTY <u>OTTAWA</u>
R.C. <u>LUMBREZER</u>	TEMP. <u>62°</u>	TOWNSHIP <u>DANBURY</u>
		SECTION <u>4-32</u>

NOTE:
THIS MAP IS FOR ODOT PURPOSES ONLY
TO INDEX REFERENCE TIES, AND DOES NOT
REPRESENT TRUE LAND SUBDIVISION.

TYPE MONUMENT MONBOX
 ON SURFACE - ~~BELOW~~ ON
 LEFT - CL PAV'T - ~~RIGHT~~ 18.5'
- TO - EDGE PAVEMENT
 S.L.M. 77+47.01, (26.3' S. OF CL CR 135)
 GRID: NORTHING: 669002.507 EASTING: 1877124.281

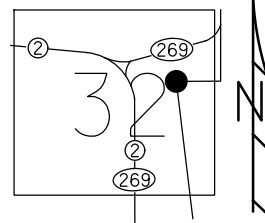

RECORD: P.I.
 $\Delta = 79^{\circ}49' RT$
 REF 4 269
 RJL, 4/29/11

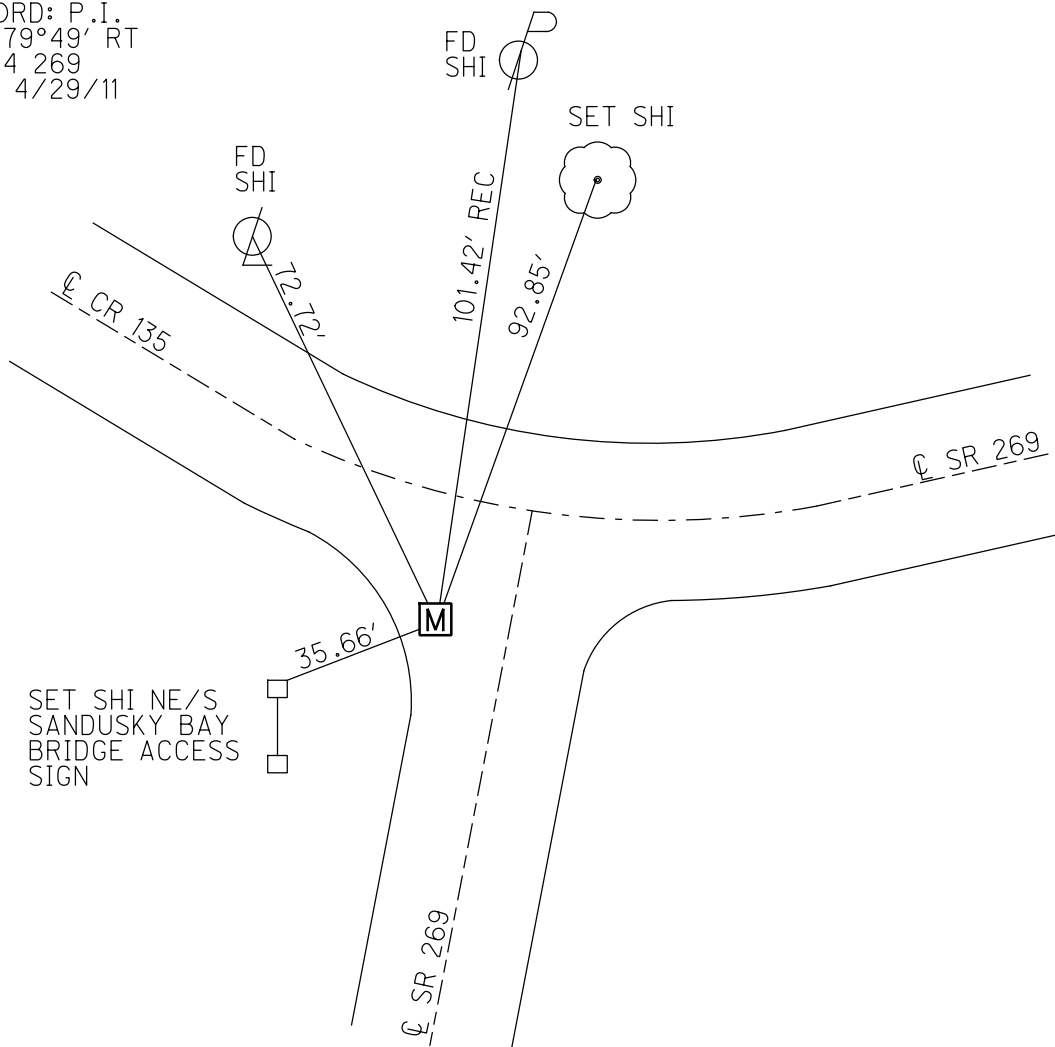

O.D.O.T. DISTRICT 2 SURVEY OFFICE

PERSONNEL _____

REFERENCE NO. 4

SHEET _____ OF _____

NOTES LOEHRKE

H.C. CANTERBURY

DATE 12-2-94

ROUTE S.R. 269

R.C. SLOVAK

WEATHER WINDY

COUNTY OTTAWA

TEMP. +40

TOWNSHIP DANBURY

SECTION _____

T. _____ R. _____


TYPE MONUMENT Mon Box

ON SURFACE - BELOW Yes


LEFT- & PAV'T. - RIGHT 185' G.PAVT S.R. 269

- TO < EDGE PAVEMENT 26.3 S. of G.PAVT Co. Rd. 135

S.L.M. 77+47.01

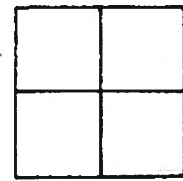

RECORD $\Delta = 79^{\circ} - 49' \text{ Rt}$

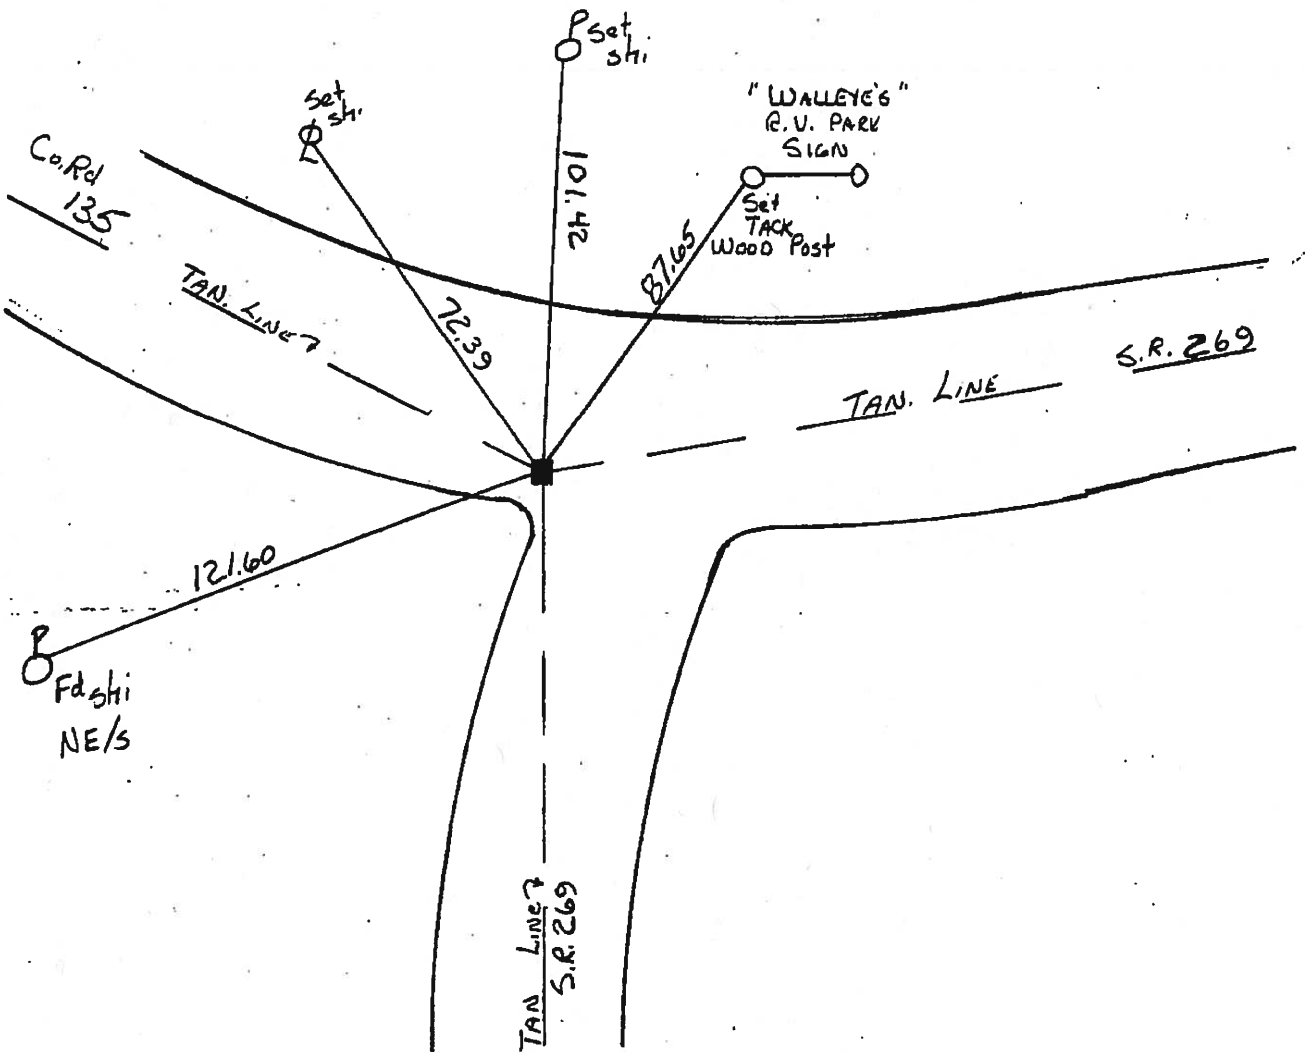

QD.O.T. DISTRICT 2 SURVEY OFFICE

SHEET 1 OF

County Ottawa S.R. # 269

Date 8/29/84

Township Danbury

Weather sunny - windy

Section

Temp. 80

T N, R E

Personnel: Cronin


Ripple

Ceyman

Barbour




1-2-3

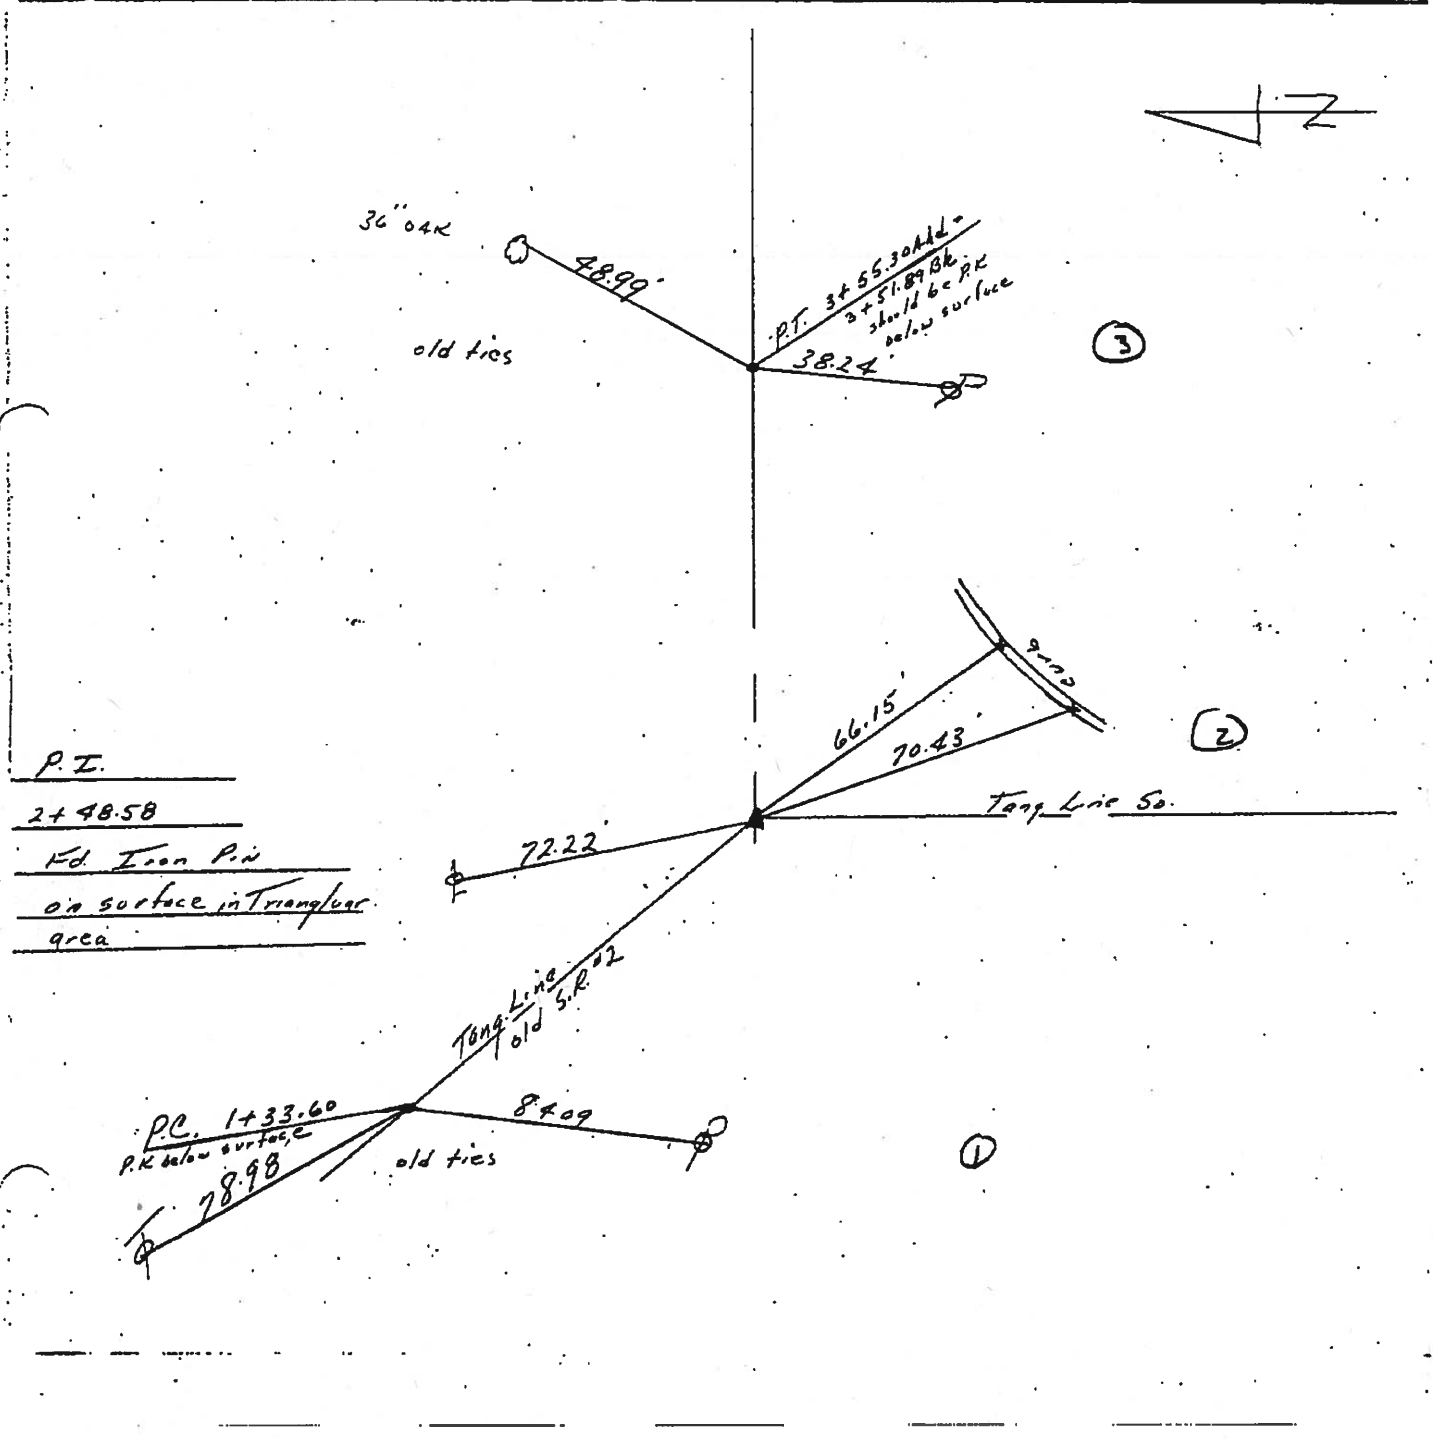

P.I.
2+48.58
Fd. Iron Pin
on surface in triangular
area

PERSONNEL	TITLE	PERSONNEL	TITLE	COUNTY	DATE	WEATHER	TEMP.
Schneider				Ottawa	6-21-71	Fair	75°
Mosser				S. R. 269			
Barbour				SEC. (0.07)(0.78)(2.67)			
Geyman							
DESCRIPTION				Old S.R. # 240 sec 4 Danbury Twp.	JOB NO.		
	LEFT	CENTER LINE	RIGHT				

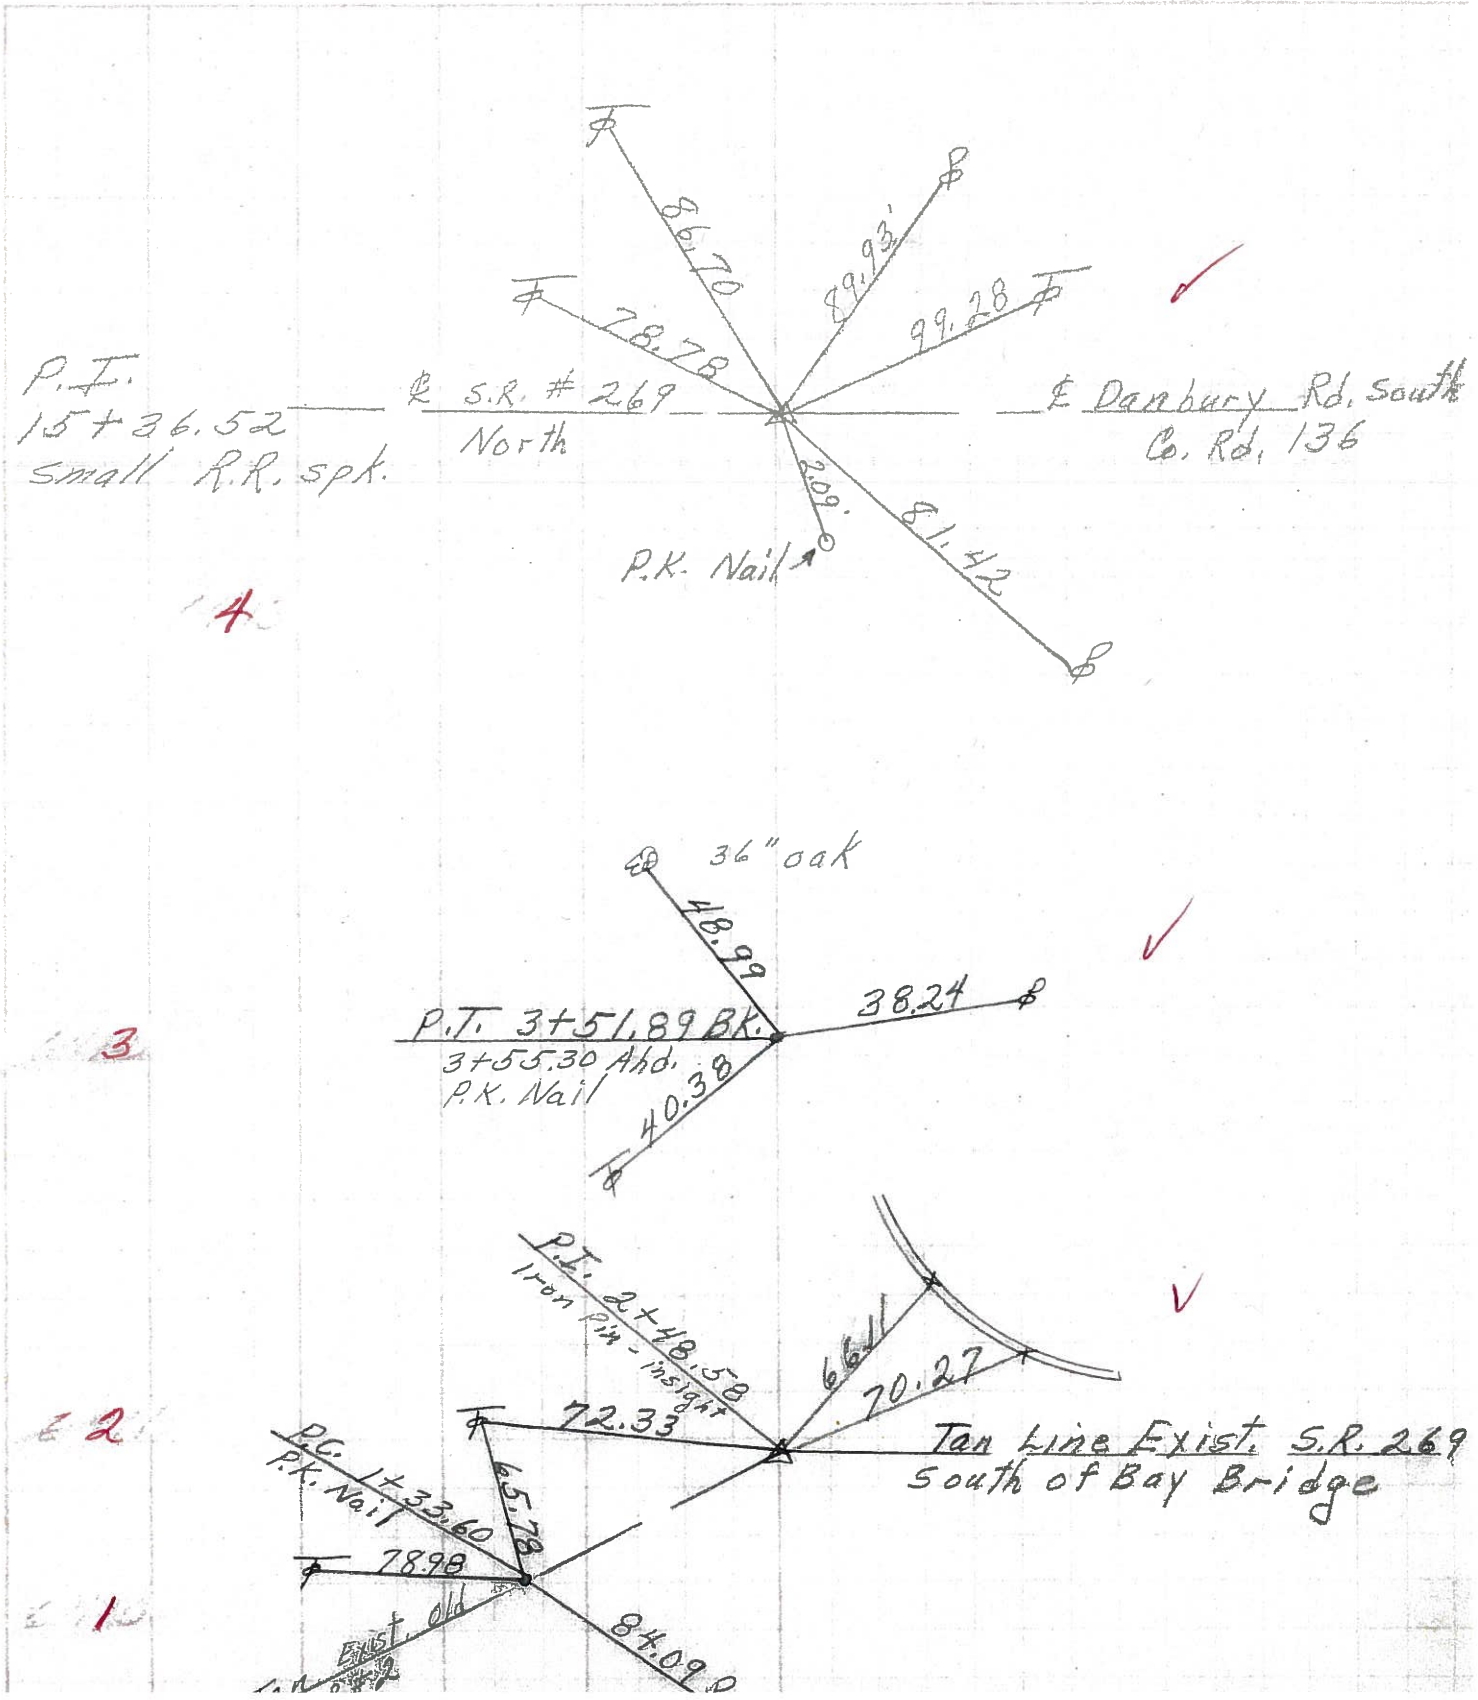

P.F.
15+36.52
small R.R. spk.

S.R. # 269
North

E Danbury Rd. South
Co. Rd. 136

P.K. Nail

1 A

3

P.T. 3+51.89 BK.
3+55.30 Abd.
P.K. Nail

36" oak

2

P.I. 2+48.58
Iron pin - insight

Tan line Exist. S.R. 269
South of Bay Bridge

P.C. 1+33.60
P.K. Nail

EXIST. old

1