


O.D.O.T. DISTRICT 2 SURVEY OFFICE (USE ONLY)

PERSONNEL \_\_\_\_\_ REFERENCE NO. 5 SHEET 5 OF 7  
 NOTES RHOADES DATE 4/20/21 ROUTE OLD SR 269  
 H.C. O'DONNELL WEATHER FAIR COUNTY OTTAWA  
 R.C. BALBAUGH TEMP. 41° TOWNSHIP DANBURY  
 SECTION 4-32  
 DWG BY RHOADES PID 95758 & 114099


TYPE MONUMENT MONBOX W/ 1" IPIN  
 ON SURFACE - ~~BELOW~~ ON  
 OFFSET Q PAVEMENT ON \_\_\_\_\_ LT : RT  
 \_\_\_\_\_ TO \_\_\_\_\_ EDGE PAVEMENT  
 STATION: 89+93.93-BACK, 15+36.52-AHEAD

HORIZ.DATUM: NAD83 2011 GEOID: NAVD88 2012A  
 GRID: NORTHING: 669268.176 EASTING: 1878391.352

NOTE:  
 THIS MAP IS FOR ODOT PURPOSES ONLY.  
 TO INDEX REFERENCE TIES, AND DOES NOT  
 REPRESENT TRUE LAND SUBDIVISION.

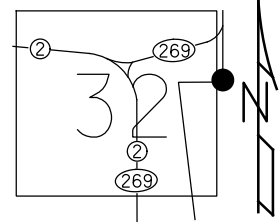

RECORD: P.I.  
 STA. 89+93.93-BACK  
 STA. 15+36.52-AHEAD  
 SET P.K./WASHER  
 ATOP R.R.SPIKE  
 8/29/94, CL  
 FD MONBOX  
 12/2/94, CL  
 FD MONBOX  
 W/ 1" IPIN  
 REF5  
 4/20/20, JFO

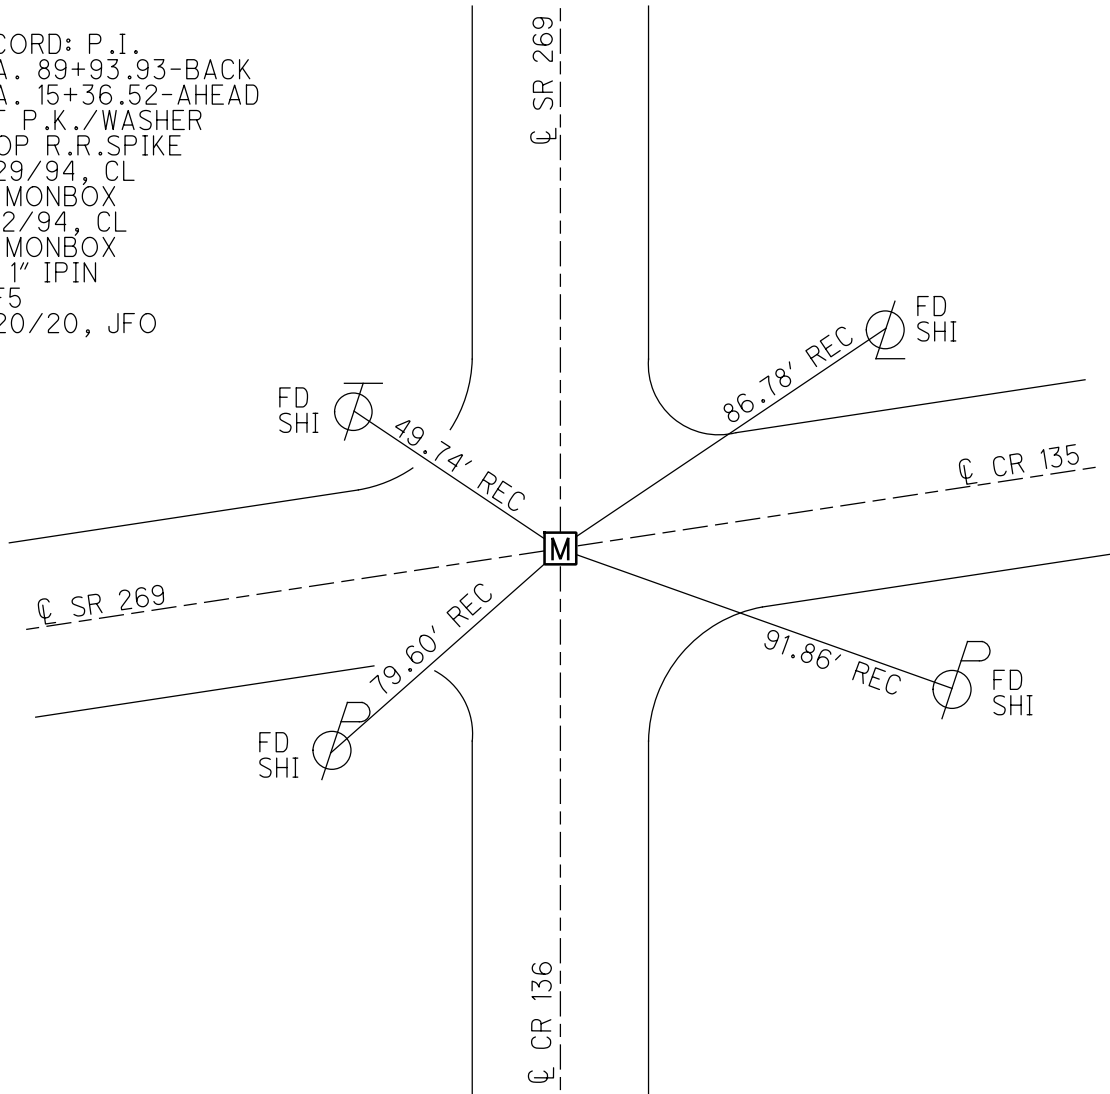


# O.D.O.T. DISTRICT 2 SURVEY OFFICE


PERSONNEL \_\_\_\_\_ REFERENCE NO. 5 SHEET \_\_\_\_\_ OF \_\_\_\_\_

NOTES LOEHARKE  
 H.C. SANTERBURY DATE 12-2-94 ROUTE S.R. 269  
 R.C. SLOVAK WEATHER WINDY, SUNNY COUNTY OTTAWA  
 \_\_\_\_\_ TEMP. +40°F TOWNSHIP DANBURY  
 \_\_\_\_\_ SECTION \_\_\_\_\_  
 T \_\_\_\_\_ R \_\_\_\_\_

TYPE MONUMENT MON. BOX  
 ON SURFACE - BELOW YES  
 LEFT-☉ PAV'T. - RIGHT SOUTH; 2.0' S. OF ☉ PAV'T  
TO \_\_\_\_\_ EDGE PAVEMENT WEST  
 S.L.M. 89+93.93 (BACK)=15+36.52 (AHEAD)

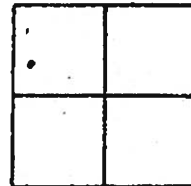

PI. Record  
 SET PK & WASHER  
 ATOP R.R. SPIKE  
 8-29-84

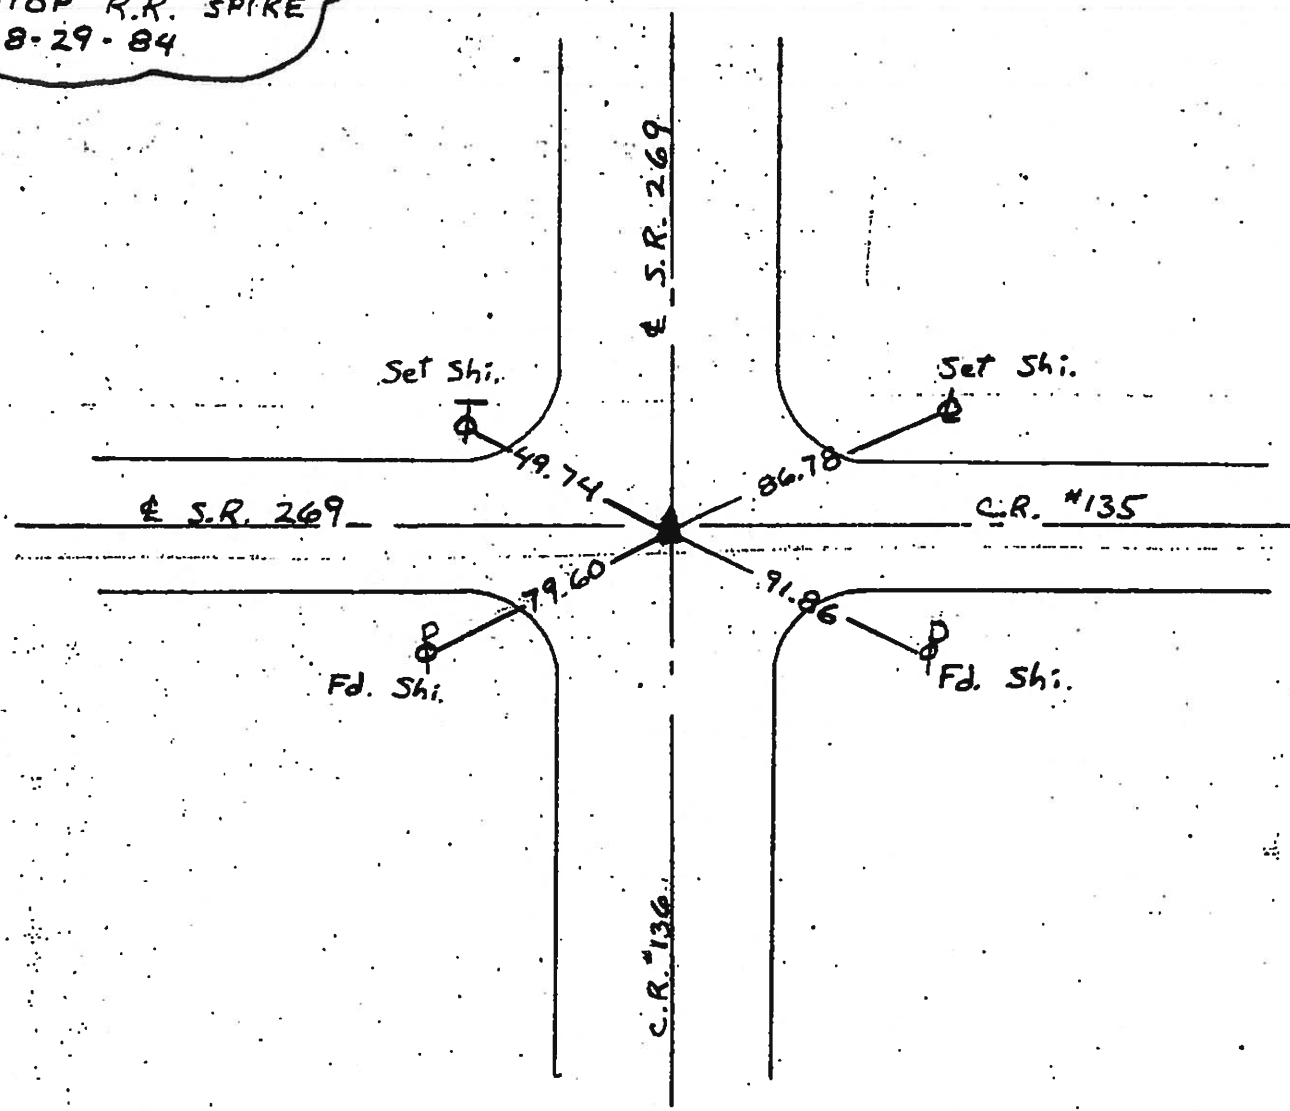

ODOT. DISTRICT 2 SURVEY OFFICE

SHEET 2 OF

County Ottawa S.R. #269

Date 8/29/84

Township Darbury

Weather sunny - windy

Section \_\_\_\_\_

Temp. 80°

T\_N, R\_E

Personnel Cronin




# 4

Ripple

Geyman

Barbour

5

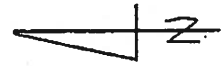

P.I. \_\_\_\_\_


15+36.52

set P.K. & washer

atop R.R. spike

S.R. #269

C.R. #136

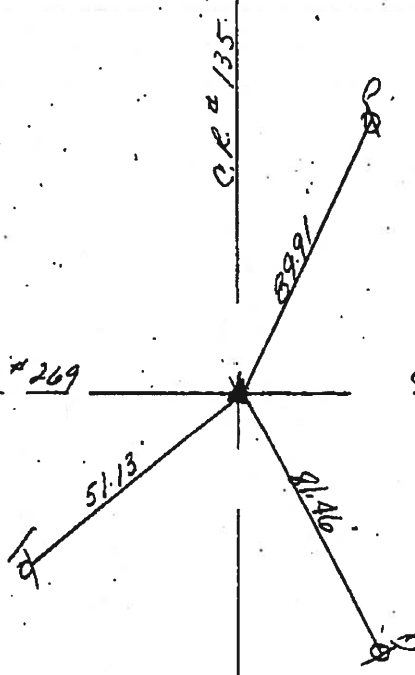

PERSONNEL	TITLE	PERSONNEL	TITLE
Schneider			
Mosser			
Barbour			
Geyman			

COUNTY Ottawa DATE 6-21-71  
 S. R. 269 WEATHER Fair  
 SEC. (0.07)(0.78)(2.67) TEMP. 75°

DESCRIPTION Old S.R. # 240 sec 4 Danbury Twp. JOB NO. \_\_\_\_\_  
 LEFT CENTER LINE RIGHT

