


O.D.O.T. DISTRICT 2 SURVEY OFFICE (USE ONLY)

PERSONNEL _____ REFERENCE NO. 10 SHEET 4 OF 9
 NOTES NIESE DATE 9/30/21 ROUTE SR 269
 H.C. AUBLE WEATHER CLEAR COUNTY OTTAWA
 R.C. NIESE TEMP. 57° TOWNSHIP DANBURY
 DWG BY WHITAKER PID 95758 SECTION 4-20


TYPE MONUMENT MAG/WASHER
 ON SURFACE - ~~BELOW~~ ON
 OFFSET \odot PAVEMENT ON LT : RT
12.4' TO LT EDGE PAVEMENT
 STATION: 157+87

NOTE:
 THIS MAP IS FOR ODOT PURPOSES ONLY
 TO INDEX REFERENCE TIES, AND DOES NOT
 REPRESENT TRUE LAND SUBDIVISION.

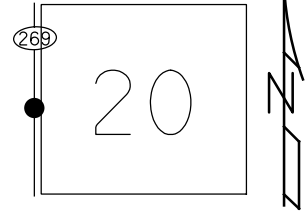

HORZ. DATUM: NAD83(2011) GEOID: 2018
 GRID: NORTHING: 674623.474 EASTING: 1878250.326

RECORD: P.I.
 STA. 68+95.40
 FD P.K./WASHER
 2" DOWN
 3/31/03, MB
 SET MAG/WASHER
 6/30/03, MDB
 SET MAG/WASHER
 REF10
 9/26/18, JFO
 FD MAG/WASHER
 2/8/19, JFO
 FD MAG/WASHER
 REF10
 9/30/21, DSA
 SET MAG/WASHER
 7/22/22, DSA

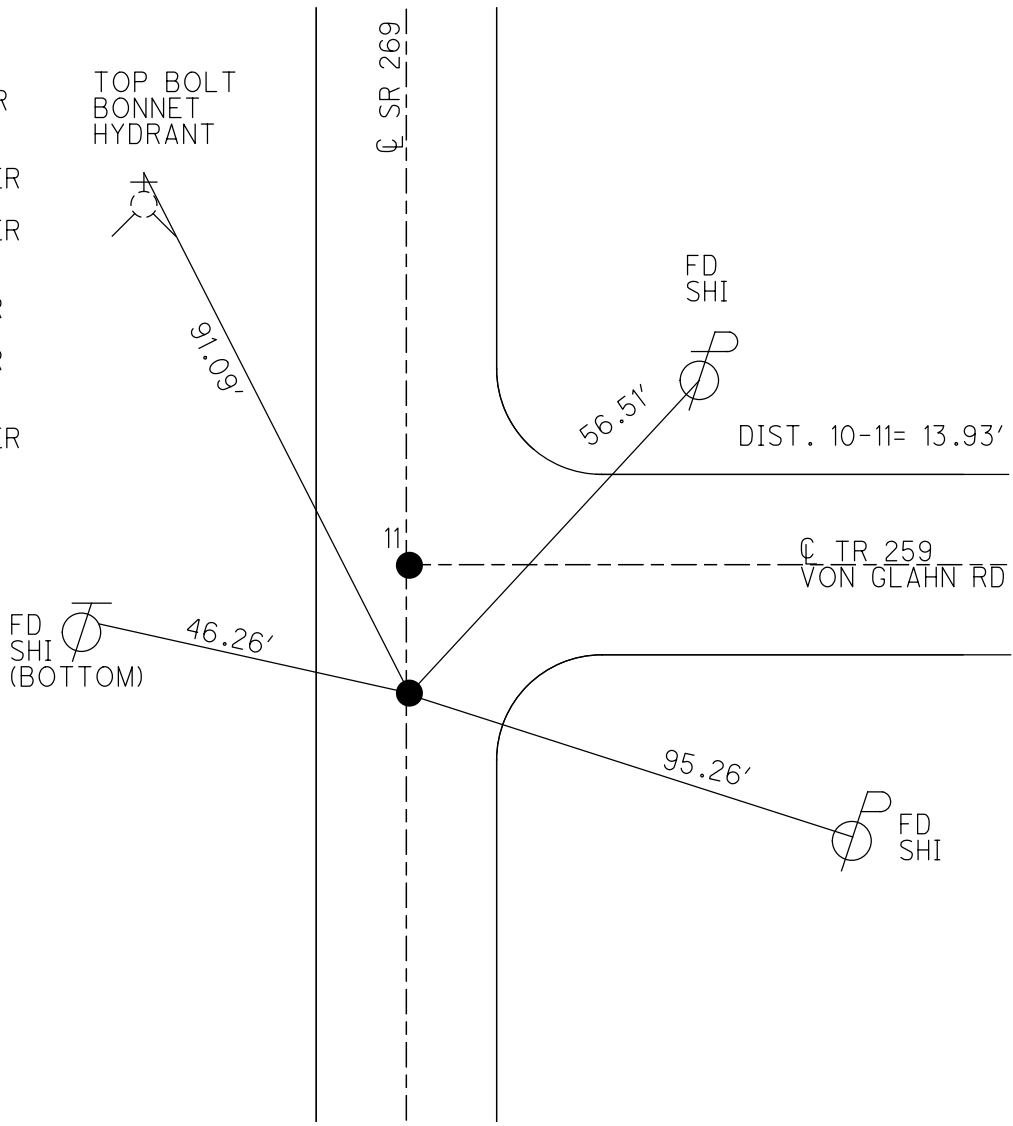


O.D.O.T. DISTRICT 2 SURVEY OFFICE (USE ONLY)

PERSONNEL _____ REFERENCE NO. 10 SHEET 4 OF 8
 NOTES RHOADES DATE 9/26/18 ROUTE SR 269
 H.C. O'DONNELL WEATHER CLOUDY COUNTY OTTAWA
 R.C. RHOADES TEMP. 68° TOWNSHIP DANBURY
 SECTION 4-20

DWG BY NIESE PID PAV'T TRAIN


TYPE MONUMENT MAG/WASHER
 ON SURFACE - ~~BELOW~~ ON
 OFFSET Q PAVEMENT ON LT : RT
12.4' TO LT EDGE PAVEMENT
 STATION: 154+03

NOTE:
THIS MAP IS FOR ODOT PURPOSES ONLY
TO INDEX REFERENCE TIES, AND DOES NOT
REPRESENT TRUE LAND SUBDIVISION.

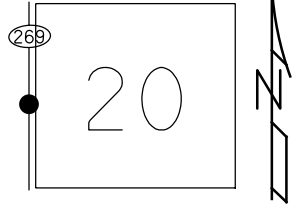

HORZ. DATUM: NAD83(2011) GEOID: 2012A
 GRID: NORTHING: 674623.474 EASTING: 1878250.326

RECORD: P.I.
 STA. 68+95.40
 FD P.K./WASHER
 2" BELOW
 3/31/03, MB
 SET MAG/WASHER
 6/30/03, MDB
 SET MAG/WASHER
 REF10
 9/26/18, JFO
 FD MAG/WASHER
 2/8/19, JFO

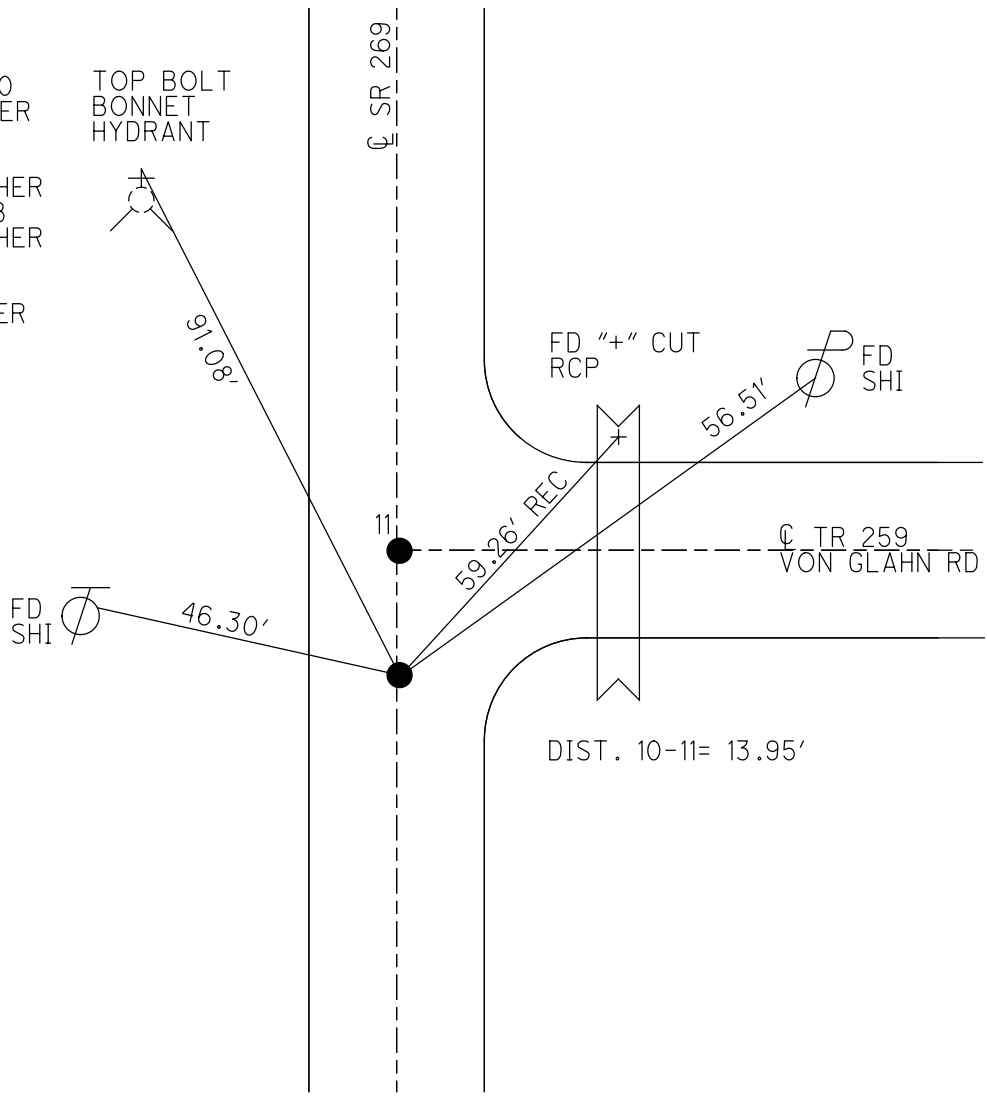


O.D.O.T. DISTRICT 2 SURVEY OFFICE (USE ONLY)

PERSONNEL _____ REFERENCE NO. 10 SHEET 3 OF 7
 NOTES RHOADES DATE 9/26/18 ROUTE SR 269
 H.C. O'DONNELL WEATHER CLOUDY COUNTY OTTAWA
 R.C. MILLER TEMP. 68° TOWNSHIP DANBURY
 _____ SECTION 4-25


TYPE MONUMENT MAG/WASHER
 ON SURFACE - ~~BELOW~~ ON
 LEFT - Q PAV'T - RIGHT ON
12.4' TO LT EDGE PAVEMENT
 S.L.M. 157+87

NOTE:
THIS MAP IS FOR ODOT PURPOSES ONLY
TO INDEX REFERENCE TIES, AND DOES NOT
REPRESENT TRUE LAND SUBDIVISION.

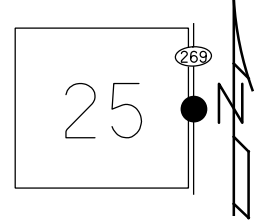

GRID: NORTHING: 674623.474 EASTING: 1878250.326

RECORD: P.I.
 STA. 68+95.40
 FD P.K./WASHER
 3/31/03, MB
 SET MAGS/WASHER
 6/30/03, MDB
 SET MAG/WASHER
 REF10
 9/26/18, JFO
 FD MAG/WASHER
 2/8/19, JFO

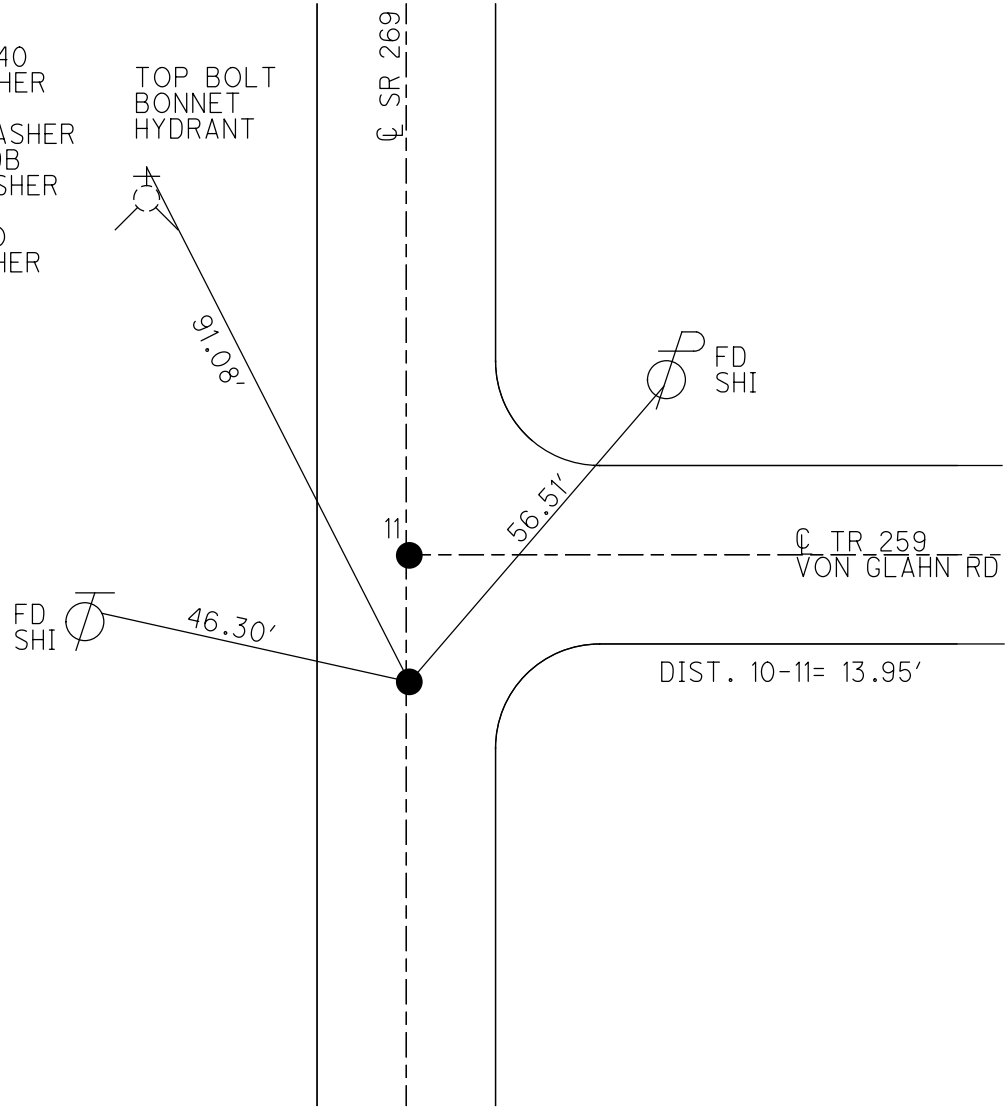


O.D.O.T. DISTRICT 2 SURVEY OFFICE (USE ONLY)

PERSONNEL _____ REFERENCE NO. 10 SHEET 8 OF 12
 NOTES BARNHISEL DATE 03/31/03 ROUTE S.R. 269
 H.C. BRUMBAUGH WEATHER CLEAR COUNTY OTTAWA
 R.C. GLASS TEMP. +35° TOWNSHIP DANBURY
 _____ SECTION 4-25

TYPE MONUMENT PK/WASHER
~~ON SURFACE~~ - BELOW 2"
~~LEFT~~ - Q PAV'T - ~~RIGHT~~ ON
12.4' TO LT EDGE PAVEMENT
 S.L.M. 154+03

NOTE:
THIS MAP IS FOR ODOT PURPOSES ONLY
TO SHOW REFERENCE TIES, AND DOES NOT
REPRESENT TRUE LAND SUBDIVISION.

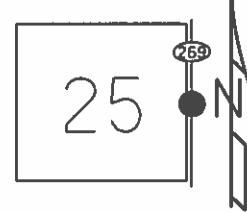

GRID: NORTHING: _____ EASTING: _____

RECORD:
 P.I. = 68+95.40
 RESET MAGS/WASHER
 06/30/03, MDB

