


O.D.O.T. DISTRICT 2 SURVEY OFFICE (USE ONLY)

PERSONNEL _____ REFERENCE NO. 11 SHEET 5 OF 9
 NOTES NIESE DATE 9/30/21 ROUTE SR 269
 H.C. AUBLE WEATHER CLEAR COUNTY OTTAWA
 R.C. NIESE TEMP. 57° TOWNSHIP DANBURY
 SECTION 4-20
 DWG BY WHITAKER PID 95758


TYPE MONUMENT MAG/WASHER
 ON SURFACE - ~~BELOW~~ ON
 OFFSET Q PAVEMENT ON LT : RT
12.4' TO LT EDGE PAVEMENT
 STATION: 158+01

NOTE:
THIS MAP IS FOR ODOT PURPOSES ONLY
TO INDEX REFERENCE TIES, AND DOES NOT
REPRESENT TRUE LAND SUBDIVISION.

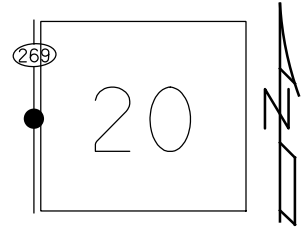

HORIZ.DATUM: NAD83(2011) GEOID: 2012A
 GRID: NORTHING: 674637.411 EASTING: 1878249.914

RECORD: P.O.T.
 STA. 69+09.28
 FD P.K./WASHER
 2" DOWN
 3/31/03, MB
 SET MAG/WASHER
 6/30/03, MDB
 SET MAG/WASHER
 REF11
 9/26/18, JFO
 FD MAG/WASHER
 2/8/19, JFO
 FD MAG/WASHER
 REF11
 9/30/21, DSA
 SET MAG/WASHER
 7/22/22, DSA

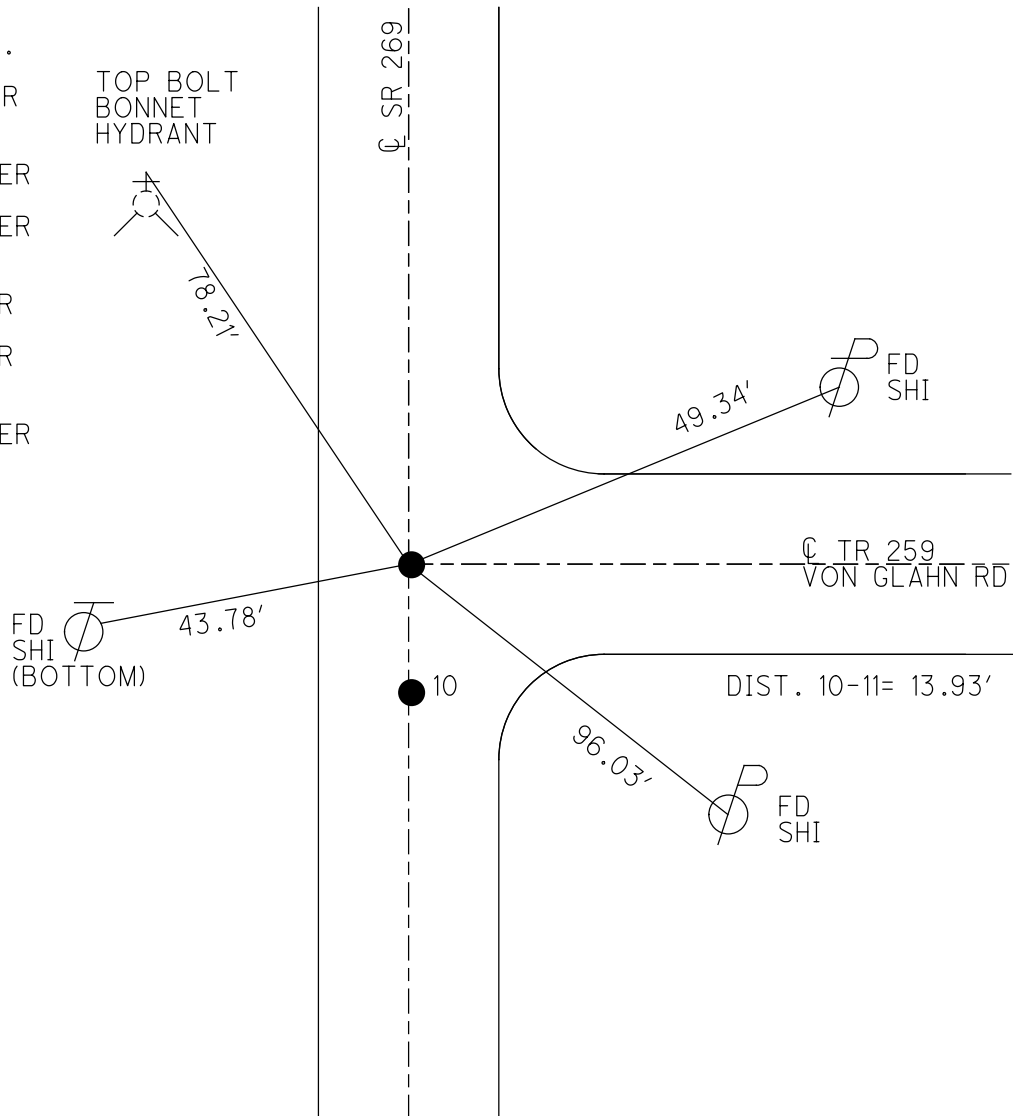


O.D.O.T. DISTRICT 2 SURVEY OFFICE (USE ONLY)

PERSONNEL _____ REFERENCE NO. 11 SHEET 5 OF 8
 NOTES RHOADES DATE 9/26/18 ROUTE SR 269
 H.C. O'DONNELL WEATHER CLOUDY COUNTY OTTAWA
 R.C. RHOADES TEMP. 68° TOWNSHIP DANBURY
 SECTION 4-20
 DWG BY NIESE PID PAV'T TRAIN


TYPE MONUMENT MAG/WASHER
 ON SURFACE - ~~BELOW~~ ON
 OFFSET \odot PAVEMENT ON LT : RT
12.4' TO LT EDGE PAVEMENT
 STATION: 154+17

NOTE:
 THIS MAP IS FOR ODOT PURPOSES ONLY
 TO INDEX REFERENCE TIES, AND DOES NOT
 REPRESENT TRUE LAND SUBDIVISION.

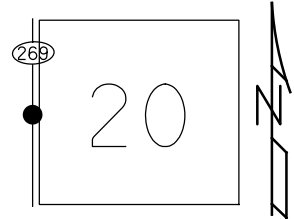

HORZ.DATUM: NAD83(2011) GEOID: 2012A
 GRID: NORTHING: 674637.411 EASTING: 1878249.914

RECORD: P.I.
 STA. 69+09.28
 FD P.K./WASHER
 2" BELOW
 3/31/03, MB
 SET MAGS/WASHER
 6/30/03, MDB
 SET MAG/WASHER
 REF11
 9/26/18, JFO
 FD MAG/WASHER
 2/8/19, JFO

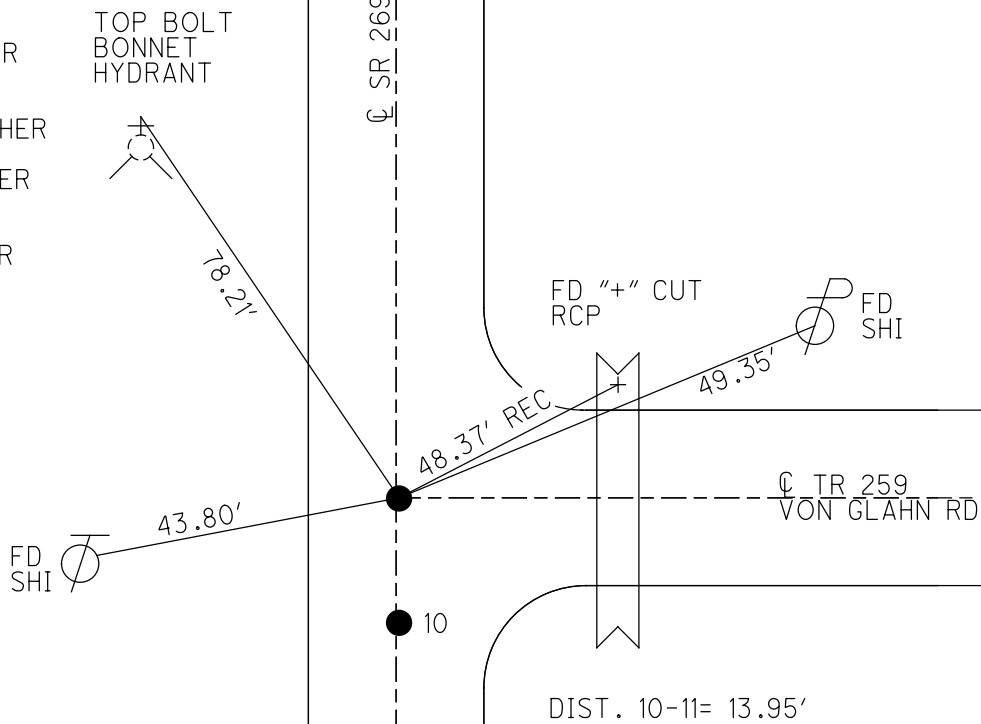


O.D.O.T. DISTRICT 2 SURVEY OFFICE (USE ONLY)

PERSONNEL	REFERENCE NO.	<u>11</u>	SHEET	<u>4</u>	OF	<u>7</u>
NOTES	<u>RHOADES</u>	DATE	<u>9/26/18</u>	ROUTE	<u>SR 269</u>	
H.C.	<u>O'DONNELL</u>	WEATHER	<u>CLOUDY</u>	COUNTY	<u>OTTAWA</u>	
R.C.	<u>MILLER</u>	TEMP.	<u>68°</u>	TOWNSHIP	<u>DANBURY</u>	
				SECTION	<u>4-25</u>	


TYPE MONUMENT MAG/WASHER
 ON SURFACE - ~~BELOW~~ ON
 LEFT - ℄ PAV'T - RIGHT ON
12.4' TO LT EDGE PAVEMENT
 S.L.M. 158+01

NOTE:
THIS MAP IS FOR ODOT PURPOSES ONLY
TO INDEX REFERENCE TIES, AND DOES NOT
REPRESENT TRUE LAND SUBDIVISION.

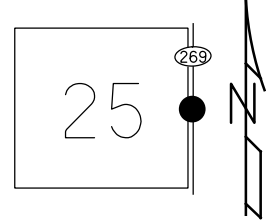

GRID: NORTHING: 674637.411 EASTING: 1878249.914

RECORD: P.O.T.
 STA. 69+09.28
 FD P.K./WASHER
 3/31/03, MB
 SET MAG/WASHER
 6/30/03, MDB
 SET MAG/WASHER
 REF11
 9/26/18
 FD MAG/WASHER
 2/8/19, JFO

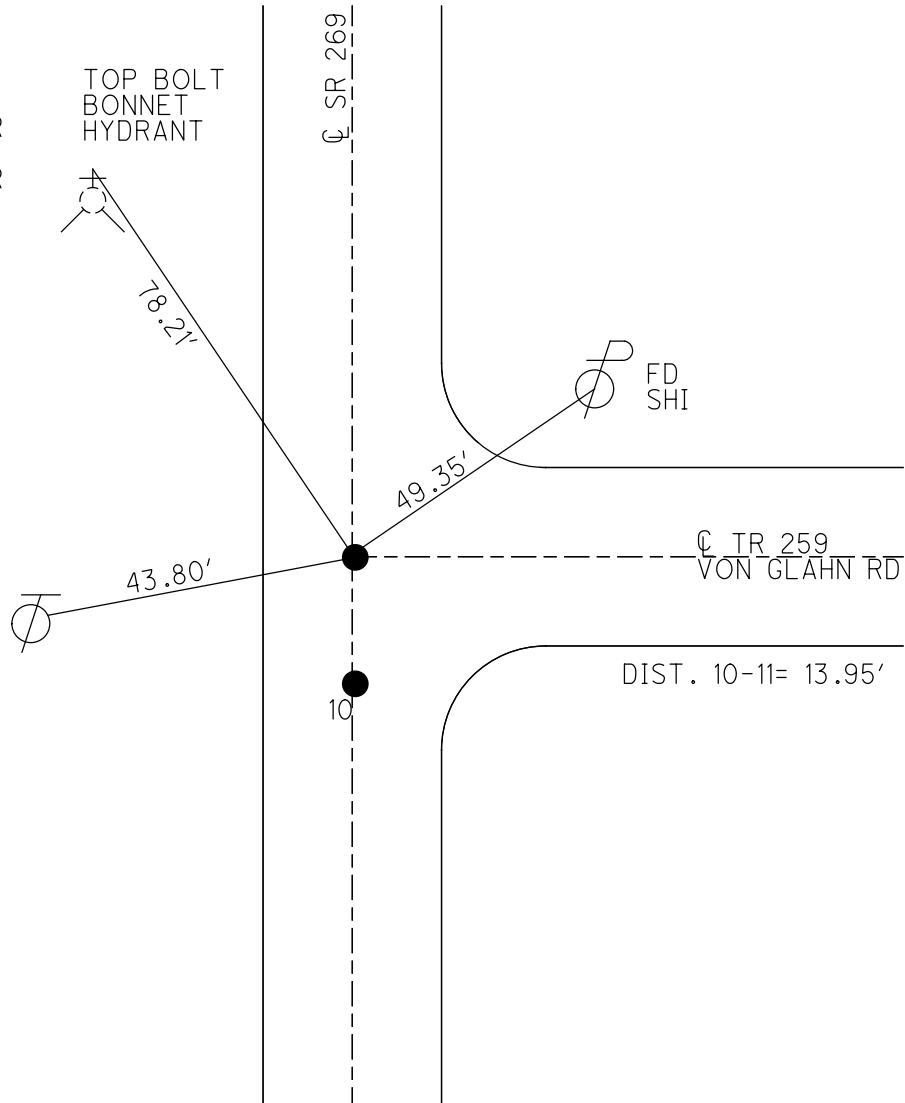


O.D.O.T. DISTRICT 2 SURVEY OFFICE (USE ONLY)

PERSONNEL _____ REFERENCE NO. 11 SHEET 9 OF 12
 NOTES BARNHISEL DATE 03/31/03 ROUTE S.R. 269
 H.C. BRUMBAUGH WEATHER CLEAR COUNTY OTTAWA
 R.C. GLASS TEMP. +35° TOWNSHIP DANBURY
 _____ SECTION 4-25

TYPE MONUMENT _____ PK/WASHER _____
~~ON SURFACE~~ - BELOW 2"
~~LEFT~~ - Q PAV'T - ~~RIGHT~~ YES
12.4' TO LT EDGE PAVEMENT
 S.L.M. 154+17
 GRID: NORTHING: _____ EASTING: _____

NOTE:
 THIS MAP IS FOR ODOT PURPOSES ONLY
 TO SHOW REFERENCE TIES, AND DOES NOT
 REPRESENT TRUE LAND SUBDIVISION.

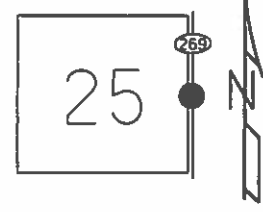

RECORD:
 P.O.T. =69+09.28
 RESET MAG/WASHER
 06/30/03, MDB

