

O.D.O.T. DISTRICT 2 SURVEY OFFICE (USE ONLY)

PERSONNEL

REFERENCE NO. 12

SHEET 6 OF 9

NOTES NIESE
 H.C. AUBLE
 R.C. NIESE

DATE 9/30/21
 WEATHER SUNNY
 TEMP. 55°

ROUTE SR 269
 COUNTY OTTAWA
 TOWNSHIP DANBURY
 SECTION 4-20

DWG BY WHITAKER PID 95758

TYPE MONUMENT P.K. SHANK

~~ON SURFACE~~ - BELOW 2"

OFFSET Q PAVEMENT 0.3' LT : ~~RT~~

13.1' TO RT EDGE PAVEMENT

STATION: 168+92


HORZ. DATUM: NAD83 (2011)

GEOID: 2018


GRID: NORTHING: 675727.738

EASTING: 1878222.133

NOTE:
THIS MAP IS FOR ODOT PURPOSES ONLY
TO INDEX REFERENCE TIES, AND DOES NOT
REPRESENT TRUE LAND SUBDIVISION.

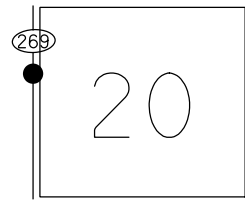

RECORD: P.O.T.
 STA. 80+00
 FD P.K./WASHER
 3/31/03, MB
 SET MAG/WASHER
 6/30/03, MDB
 D.N.F.
 9/26/18, JFO
 FD P.K. SHANK
 REF12
 9/30/21, DSA
 SET MAG/WASHER
 7/22/22, DSA

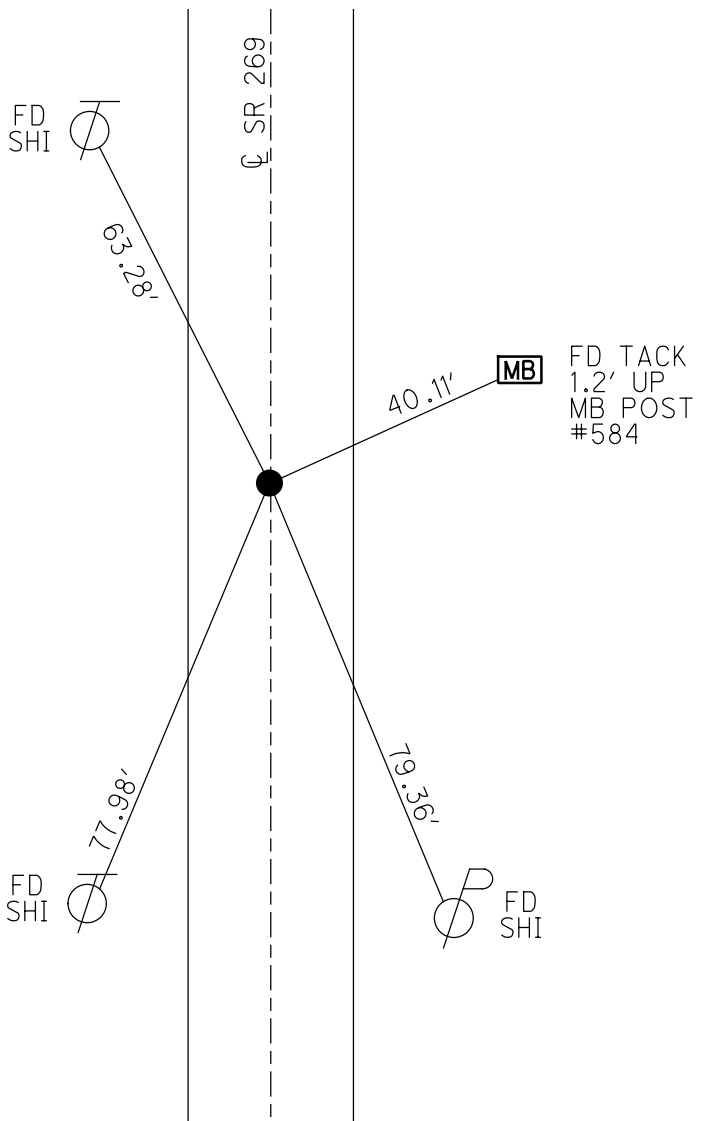


FD TACK
 1.2' UP
 MB POST
 #584

O.D.O.T. DISTRICT 2 SURVEY OFFICE (USE ONLY)

PERSONNEL _____ REFERENCE NO. 12 SHEET 6 OF 8
 NOTES RHOADES DATE 9/26/18 ROUTE SR 269
 H.C. O'DONNELL WEATHER CLOUDY COUNTY OTTAWA
 R.C. RHOADES TEMP. 68° TOWNSHIP DANBURY
 SECTION 4-20
 DWG BY NIESE PID PAV'T TRAIN


TYPE MONUMENT P.K./WASHER
 ON SURFACE - ~~BELOW~~ ON
 OFFSET \varnothing PAVEMENT 0.3' LT : ~~RT~~
13.1' TO RT EDGE PAVEMENT
 STATION: 165+09

NOTE:
THIS MAP IS FOR ODOT PURPOSES ONLY
TO INDEX REFERENCE TIES, AND DOES NOT
REPRESENT TRUE LAND SUBDIVISION.

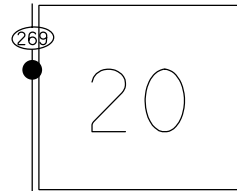

HORIZ.DATUM: - GEOID: -
 GRID: NORTHING: - EASTING: -

RECORD: P.O.T.
 STA. 80+00
 FD P.K./WASHER
 3/31/03, MB
 SET MAG/WASHER
 6/30/03, MDB
 D.N.F.
 9/26/18, JFO

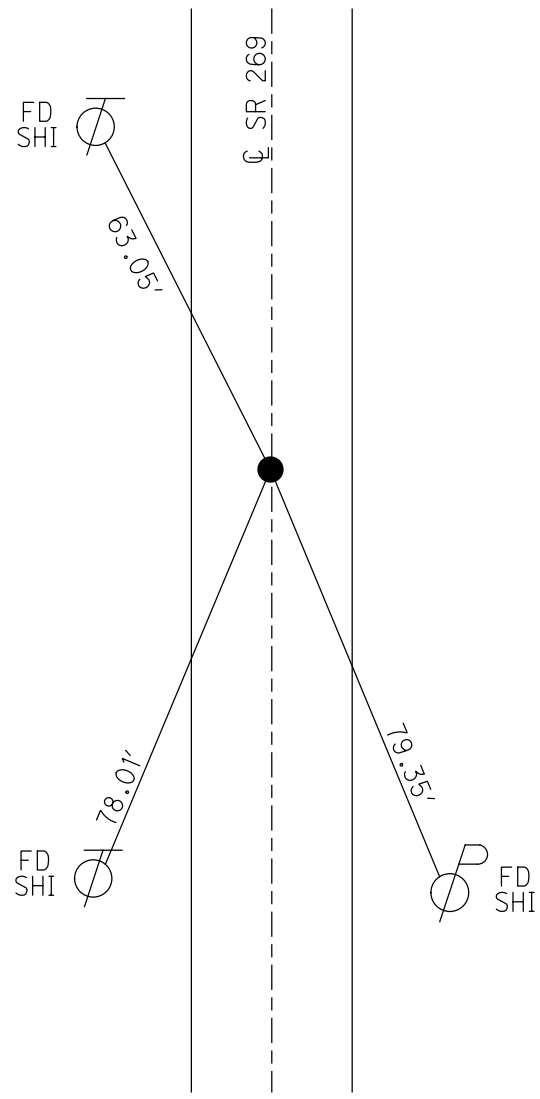


O.D.O.T. DISTRICT 2 SURVEY OFFICE (USE ONLY)


PERSONNEL _____ REFERENCE NO. 12 SHEET 5 OF 7
 NOTES BARNHISEL DATE 3/31/03 ROUTE SR 269
 H.C. BRUMBAUGH WEATHER CLEAR COUNTY OTTAWA
 R.C. GLASS TEMP. 35° TOWNSHIP DANBURY
 _____ SECTION 4-25

TYPE MONUMENT P.K./WASHER
 ON SURFACE - ~~BELOW~~ ON _____
 LEFT - Q PAV'T - ~~RIGHT~~ 0.3'
13.1' TO RT EDGE PAVEMENT
 S.L.M. 168+92
 GRID: NORTHING: _____ EASTING: _____

NOTE:
THIS MAP IS FOR ODOT PURPOSES ONLY.
TO INDEX REFERENCE TIES, AND DOES NOT
REPRESENT TRUE LAND SUBDIVISION.

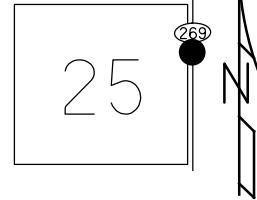

RECORD: P.O.T.
 STA. 80+00
 FD P.K./WASHER
 3/31/03, MB
 SET MAG/WASHER
 6/30/03, MDB
 D.N.F.
 TIES ARE OFF
 9/26/18, JFO

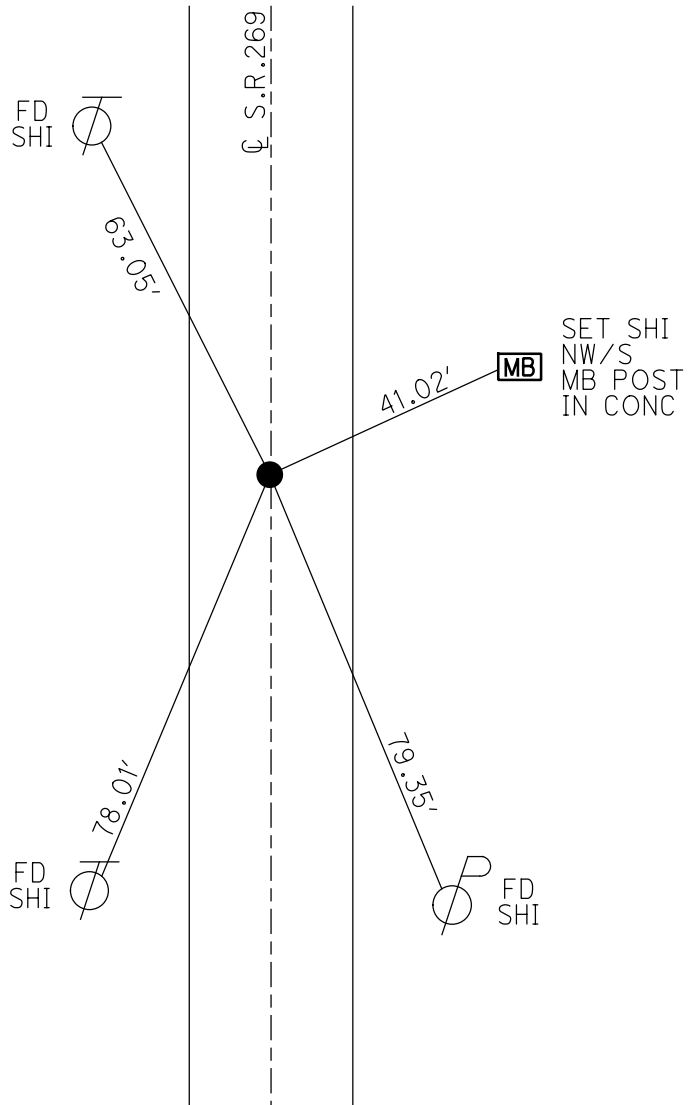


O.D.O.T. DISTRICT 2 SURVEY OFFICE (USE ONLY)


PERSONNEL _____ REFERENCE NO. 12 SHEET 10 OF 12
 NOTES BARNHISEL DATE 03/31/03 ROUTE S.R. 269
 H.C. BRUMBAUGH WEATHER CLEAR COUNTY OTTAWA
 R.C. GLASS TEMP. +35° TOWNSHIP DANBURY
 _____ SECTION 4-25

TYPE MONUMENT PK NAIL & WASHER
 ON SURFACE - ~~BELOW~~ YES
 LEFT - Q PAV'T - ~~RIGHT~~ 0.3'
13.1' TO RT. EDGE PAVEMENT
 S.L.M. 165+09
 GRID: NORTHING: _____ EASTING: _____

NOTE:
THIS MAP IS FOR ODOT PURPOSES ONLY
TO INDEX REFERENCE TIES, AND DOES NOT
REPRESENT TRUE LAND SUBDIVISION.

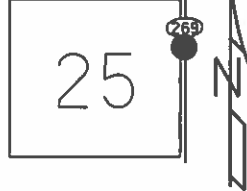

RECORD:
 P.O.T. = 80+00
 RESET MAG/WASHER
 06/30/03, MDB

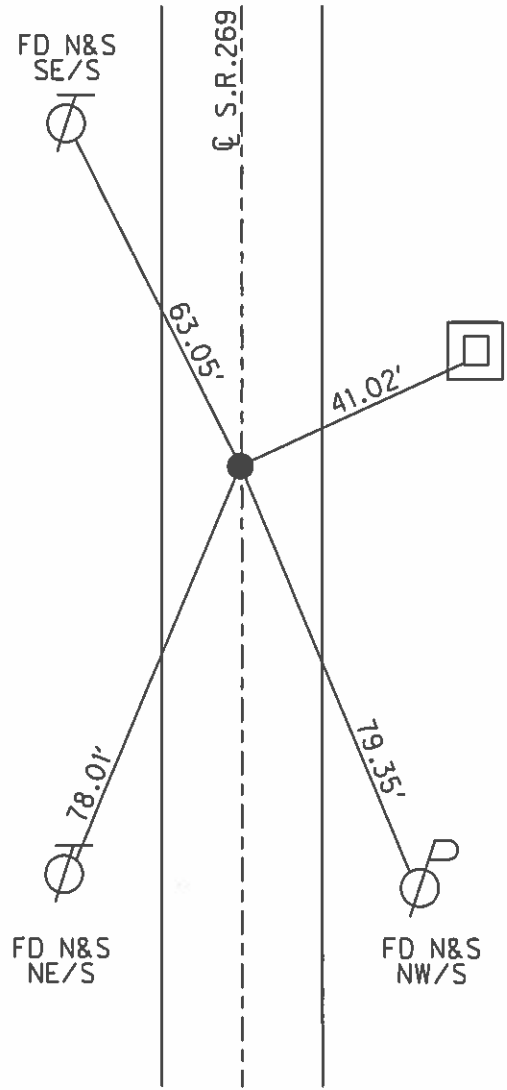

SET N&S
 NW/S MB POST
 IN CONC.