


O.D.O.T. DISTRICT 2 SURVEY OFFICE (USE ONLY)

PERSONNEL \_\_\_\_\_ REFERENCE NO. 13 SHEET 7 OF 9  
 NOTES NIESE DATE 9/30/21 ROUTE SR 269  
 H.C. AUBLE WEATHER SUNNY COUNTY OTTAWA  
 R.C. NIESE TEMP. 57° TOWNSHIP DANBURY  
 DWG BY WHITAKER PID 95758 SECTION 4-20


TYPE MONUMENT MAG/WASHER  
 ON SURFACE - ~~BELOW~~ ON  
 OFFSET Q PAVEMENT ON LT : RT  
13.5' TO RT EDGE PAVEMENT  
 STATION: 184+46

NOTE:  
 THIS MAP IS FOR ODOT PURPOSES ONLY  
 TO INDEX REFERENCE TIES, AND DOES NOT  
 REPRESENT TRUE LAND SUBDIVISION.

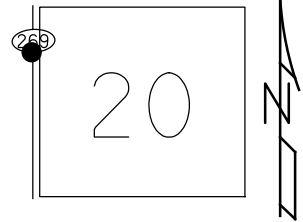

HORZ.DATUM: NAD83(2011) GEOID: 2012A  
 GRID: NORTHING: 677282.165 EASTING: 1878182.764

RECORD: P.I.  
 STA. 95+55.23  
 FD P.K./WASHER  
 3/31/03, MB  
 SET MAG/WASHER  
 6/30/03, MDB  
 FD MAG/WASHER  
 REF13  
 9/26/18  
 2/8/19, JFO  
 FD MAG/WASHER  
 9/30/21, DSA  
 SET MAG/WASHER  
 NEWREF13  
 7/22/22, DSA

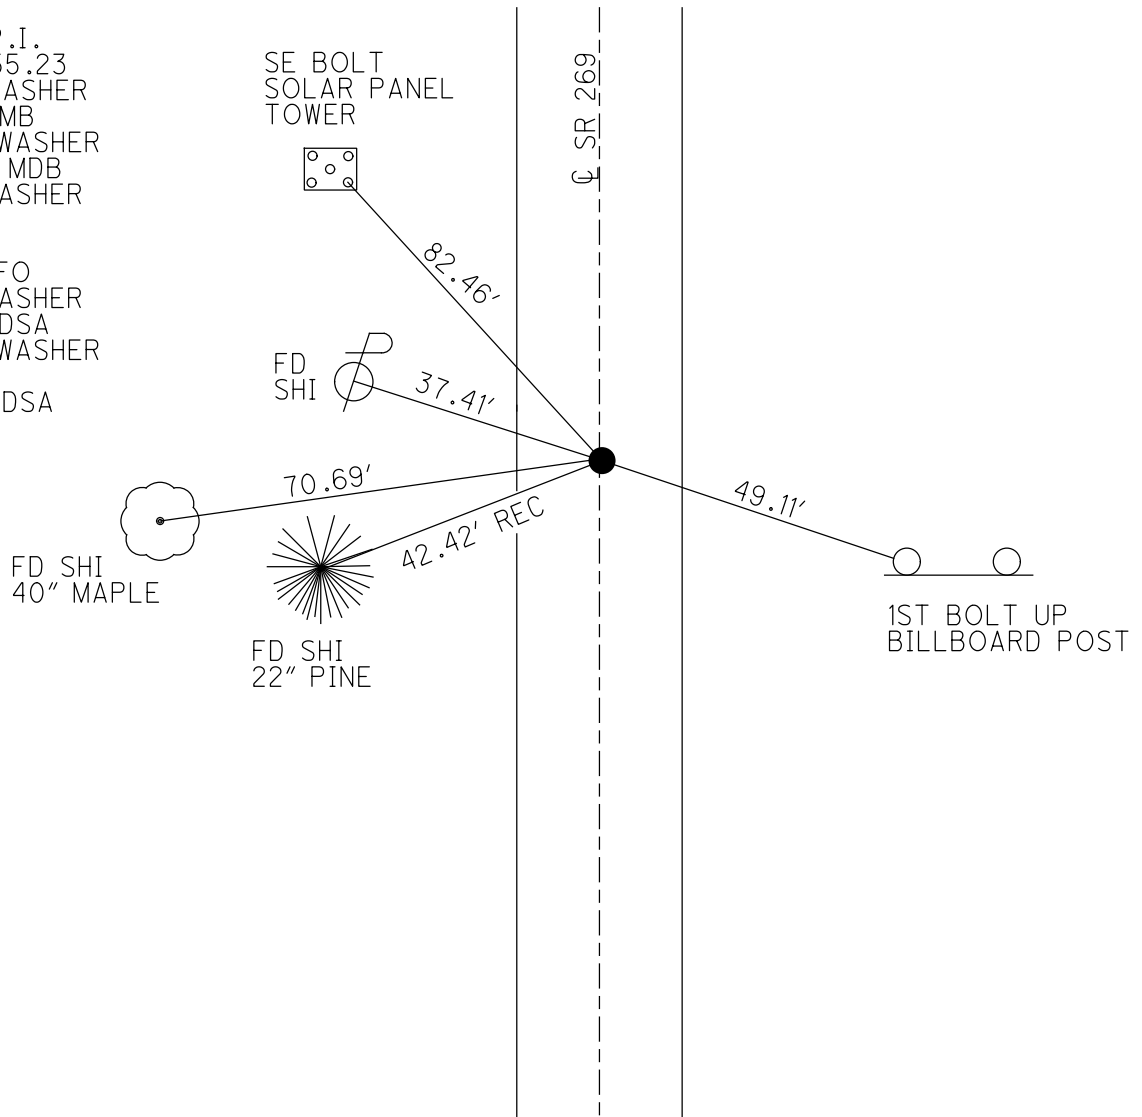

O.D.O.T. DISTRICT 2 SURVEY OFFICE (USE ONLY)

PERSONNEL \_\_\_\_\_ REFERENCE NO. 13 SHEET 7 OF 8  
 NOTES RHOADES DATE 9/26/18 ROUTE SR 269  
 H.C. O'DONNELL WEATHER CLOUDY COUNTY OTTAWA  
 R.C. RHOADES TEMP. 68° TOWNSHIP DANBURY  
 SECTION 4-20

DWG BY NIESE PID PAV'T TRAIN

TYPE MONUMENT MAG/WASHER

ON SURFACE - ~~BELOW~~ ON


OFFSET CL PAVEMENT ON LT : RT  
13.5' TO RT EDGE PAVEMENT

STATION: 180+61


HORIZ.DATUM: NAD83(2011) GEOID: 2012A

GRID: NORTHING: 677282.165 EASTING: 1878182.764

NOTE:  
THIS MAP IS FOR ODOT PURPOSES ONLY  
TO INDEX REFERENCE TIES, AND DOES NOT  
REPRESENT TRUE LAND SUBDIVISION.

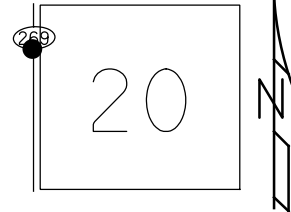

RECORD: P.I.  
 STA. 95+55.23  
 FD P.K./WASHER  
 3/31/03, MB  
 SET MAG/WASHER  
 6/30/03, MDB  
 FD MAG/WASHER  
 REF13  
 9/26/18  
 2/8/19, JFO

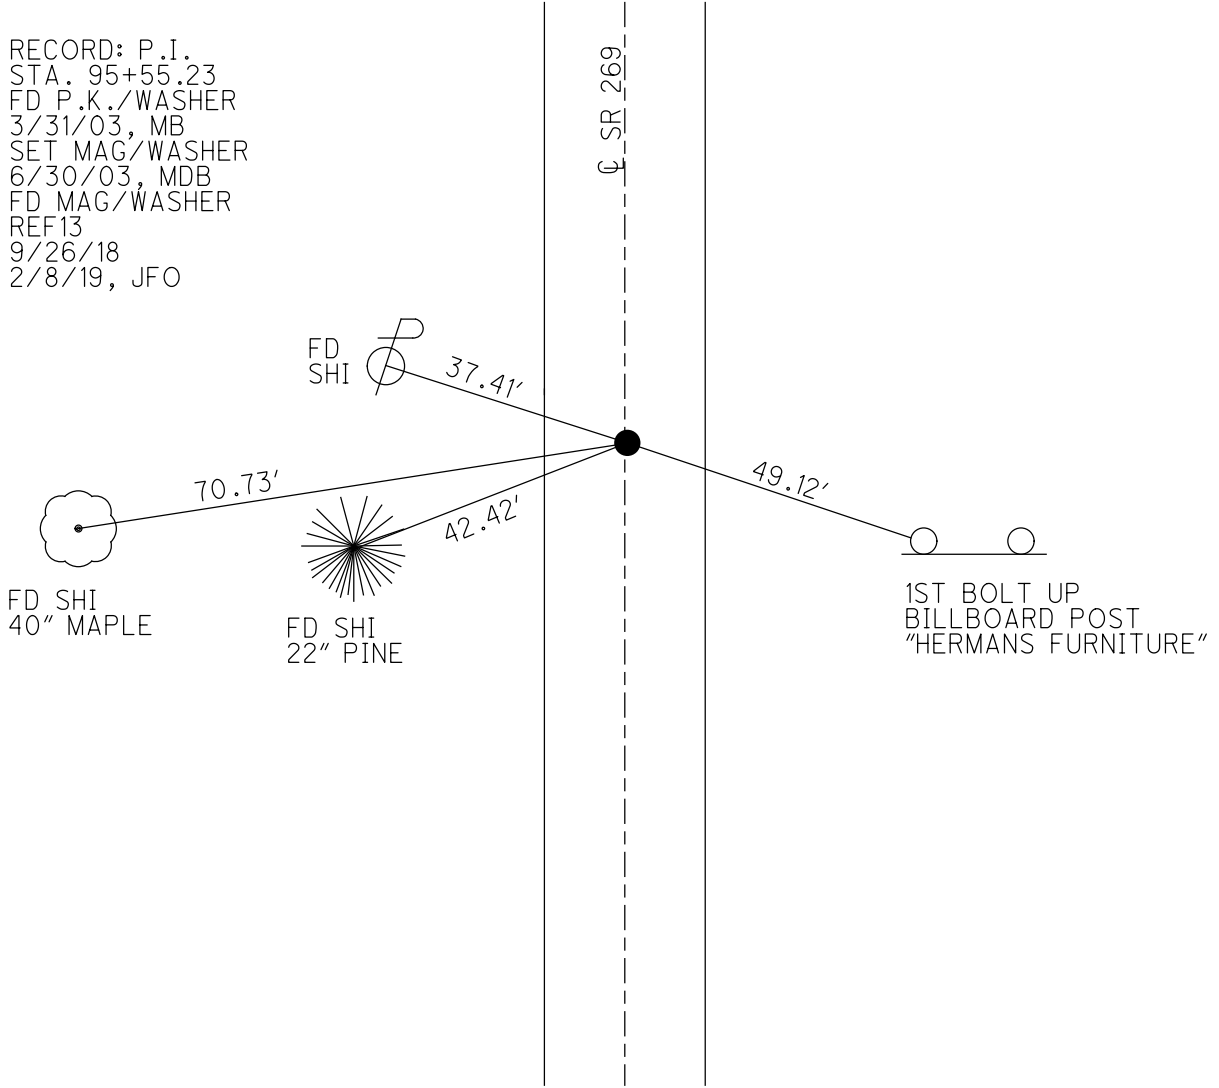


O.D.O.T. DISTRICT 2 SURVEY OFFICE (USE ONLY)

PERSONNEL	REFERENCE NO.	<u>13</u>	SHEET	<u>6</u>	OF	<u>7</u>
NOTES	RHOADES	DATE	<u>9/26/18</u>	ROUTE	<u>SR 269</u>	
H.C.	<u>O'DONNELL</u>	WEATHER	<u>CLOUDY</u>	COUNTY	<u>OTTAWA</u>	
R.C.	<u>MILLER</u>	TEMP.	<u>68°</u>	TOWNSHIP	<u>DANBURY</u>	
				SECTION	<u>4-25</u>	


TYPE MONUMENT MAG/WASHER  
 ON SURFACE - ~~BELOW~~ ON  
 LEFT - ℄ PAV'T - RIGHT ON  
13.5' TO RT EDGE PAVEMENT  
 S.L.M. 184+46

NOTE:  
THIS MAP IS FOR ODOT PURPOSES ONLY  
TO INDEX REFERENCE TIES, AND DOES NOT  
REPRESENT TRUE LAND SUBDIVISION.

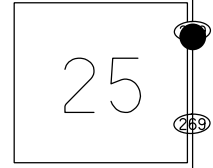

GRID: NORTHING: 677282.165 EASTING: 1878182.764

RECORD: P.I.  
 STA. 95+55.23  
 FD P.K./WASHER  
 3/31/03, MB  
 SET MAG/WASHER  
 6/30/03, MDB  
 FD MAG/WASHER  
 REF13  
 9/26/18  
 2/8/19, JFO

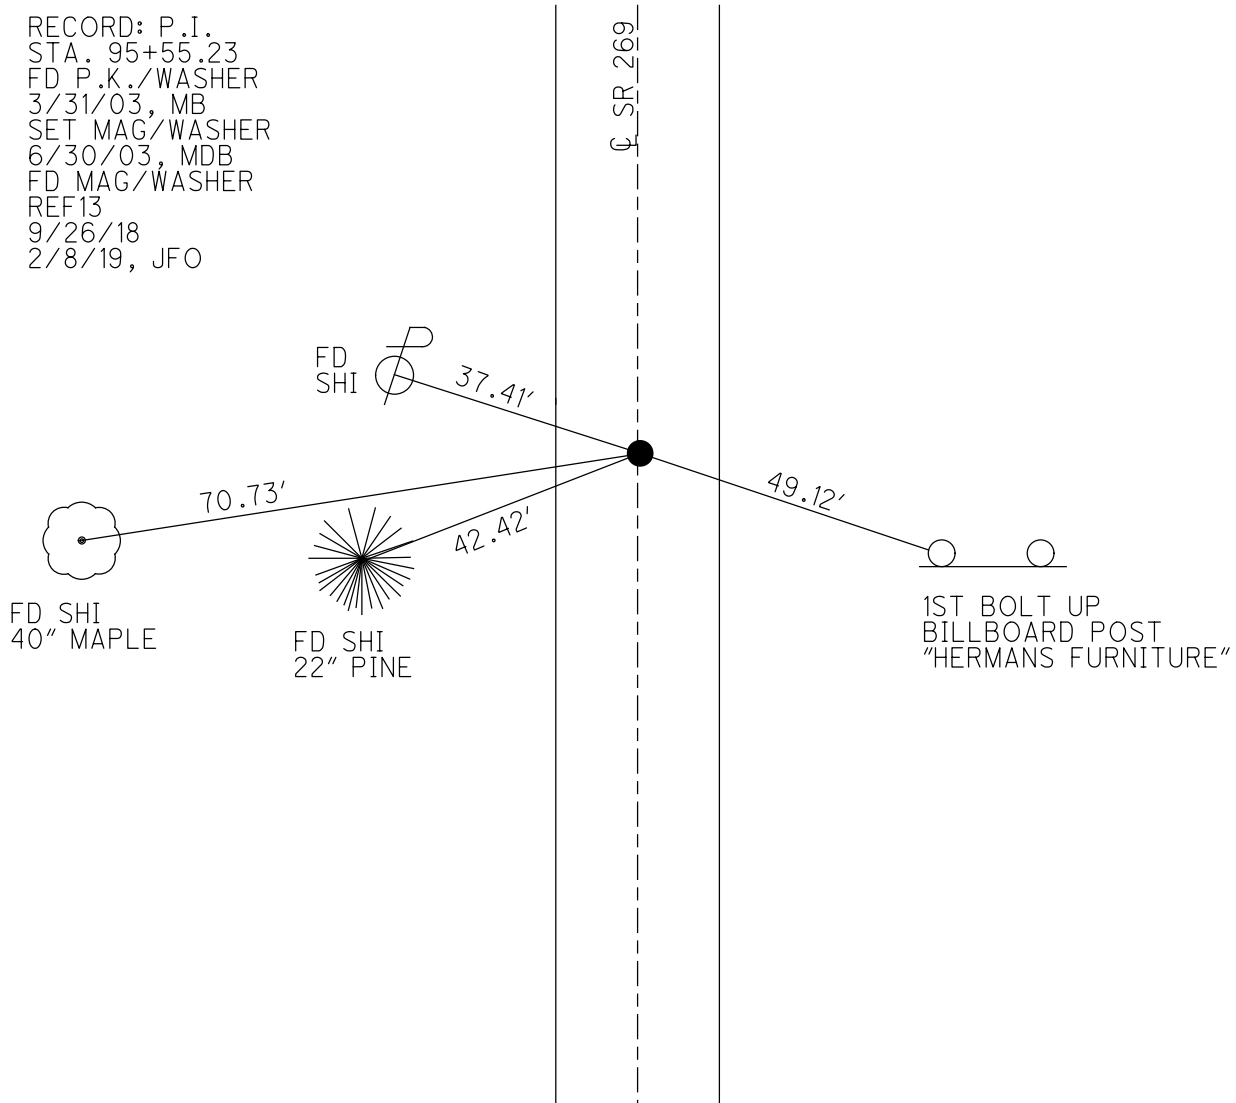

**O.D.O.T. DISTRICT 2 SURVEY OFFICE (USE ONLY)**

PERSONNEL \_\_\_\_\_ REFERENCE NO. 13 SHEET 11 OF 12  
 NOTES BARNHISEL DATE 03/31/03 ROUTE S.R. 269  
 H.C. BRUMBAUGH WEATHER CLEAR COUNTY OTTAWA  
 R.C. GLASS TEMP. +35° TOWNSHIP DANBURY  
 \_\_\_\_\_ SECTION 4-25

TYPE MONUMENT PK NAIL & WASHER  
 ON SURFACE - ~~BELOW~~ YES  
~~LEFT~~ - Q PAV'T - ~~RIGHT~~ YES  
13.5' TO RT. EDGE PAVEMENT  
 S.L.M. 180+61  
 GRID: NORTHING: \_\_\_\_\_ EASTING: \_\_\_\_\_

NOTE:  
THIS MAP IS FOR ODOT PURPOSES ONLY  
TO INDEX REFERENCE TIES, AND DOES NOT  
REPRESENT TRUE LAND SUBDIVISION.



RECORD:  
P.I. =95+55.23

RESET MAG/WASHER  
06/30/03, MDB

