

O.D.O.T. DISTRICT 2 SURVEY OFFICE (USE ONLY)

PERSONNEL _____ REFERENCE NO. 14 SHEET 8 OF 9
 NOTES NIESE DATE 9/30/21 ROUTE SR 269
 H.C. AUBLE WEATHER SUNNY COUNTY OTTAWA
 R.C. NIESE TEMP. 64° TOWNSHIP DANBURY
 SECTION 4-20

DWG BY WHITAKER PID 95758

TYPE MONUMENT MAG NAIL

ON SURFACE - ~~BELOW~~ ON

OFFSET Q PAVEMENT ON LT : RT

12.4' TO RT EDGE PAVEMENT

STATION: 195+82



HORZ. DATUM: NAD83(2011)

GEOID: 2012A

GRID: NORTHING: 678418.368


EASTING: 1878154.653

NOTE:
THIS MAP IS FOR ODOT PURPOSES ONLY
TO INDEX REFERENCE TIES, AND DOES NOT
REPRESENT TRUE LAND SUBDIVISION.

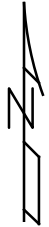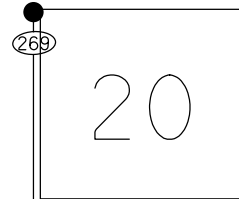

RECORD: P.I.
 STA. 106+92.10
 FD P.K./WASHER
 2" DOWN
 3/31/03, MB
 SET MAG/WASHER
 6/30/03, MDB
 FD MAG/WASHER
 REF14
 9/26/18
 2/8/19, JFO
 FD MAG MAIL
 REF14
 9/30/21, DSA
 SET MAG/WASHER
 7/22/22, DSA

FD P.K.
 IN 1ST SEAM
 CONC.DRIVE
 30.64'

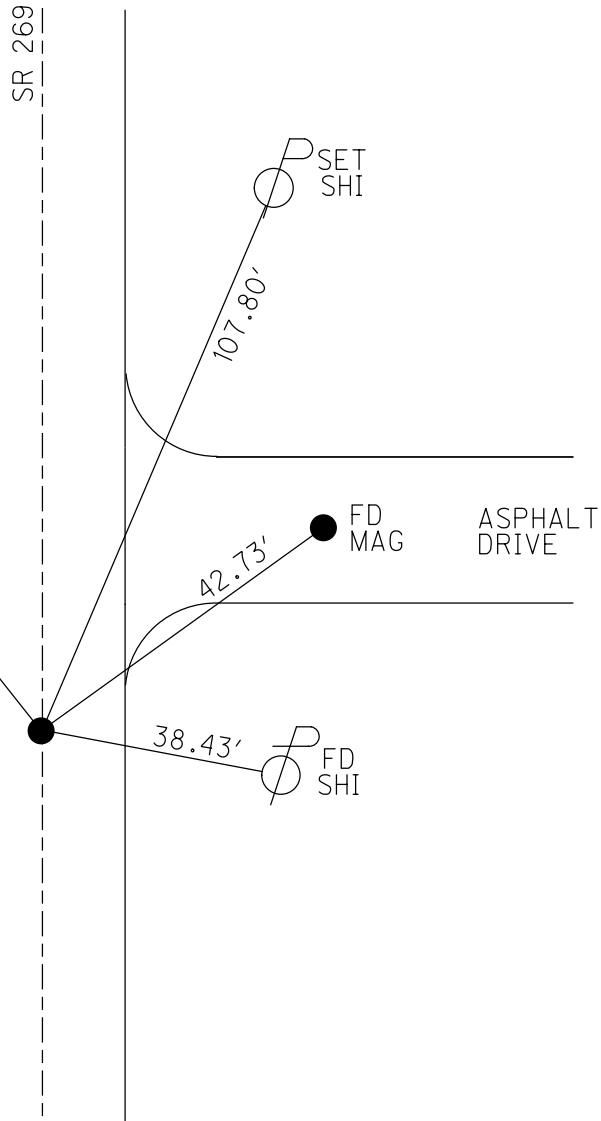

O.D.O.T. DISTRICT 2 SURVEY OFFICE (USE ONLY)

PERSONNEL _____ REFERENCE NO. 14 SHEET 8 OF 8
 NOTES RHOADES DATE 9/26/18 ROUTE SR 269
 H.C. O'DONNELL WEATHER CLOUDY COUNTY OTTAWA
 R.C. RHOADES TEMP. 68° TOWNSHIP DANBURY
 SECTION 4-20

DWG BY NIESE PID PAV'T TRAIN

TYPE MONUMENT MAG/WASHER

ON SURFACE - ~~BELOW~~ ON

OFFSET ☑ PAVEMENT ON LT : RT


12.4' TO RT EDGE PAVEMENT

STATION: 191+99

HORIZ.DATUM: NAD83(2011) GEOID: 2012A

GRID: NORTHING: 678418.368 EASTING: 1878154.653

NOTE: THIS MAP IS FOR ODOT PURPOSES ONLY TO INDEX REFERENCE TIES, AND DOES NOT REPRESENT TRUE LAND SUBDIVISION.

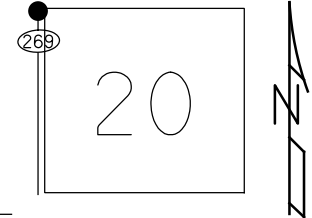

RECORD: P.I.
 STA. 106+92.10
 FD P.K./WASHER
 2" BELOW
 3/31/03, MB
 SET MAG/WASHER
 6/30/03, MDB
 FD MAG/WASHER
 REF14
 9/26/18
 2/8/19, JFO

