

O.D.O.T. DISTRICT 2 SURVEY OFFICE (USE ONLY)

PERSONNEL

REFERENCE NO. 14 A

SHEET 1 OF 18

NOTES MOSER DATE 5/5/11
 H.C. MOSER WEATHER SUNNY
 R.C. LUMBREZER TEMP. 60°

ROUTE SR 269
 COUNTY OTTAWA
 TOWNSHIP DANBURY
 SECTION 4-21

DWG BY NIESE PID PAV'T TRAIN

TYPE MONUMENT P.K. NAIL

ON SURFACE - ~~BELOW~~ ON

OFFSET CL PAVEMENT 13.0' ~~LT~~ : RT

40.9' TO LT EDGE PAVEMENT

STATION: 204+33.4



HORZ.DATUM: NAD83(2011)

GEOID: 2012A

GRID: NORTHING: 679603.040


EASTING: 1878125.169

NOTE:
THIS MAP IS FOR ODOT PURPOSES ONLY.
TO INDEX REFERENCE TIES, AND DOES NOT
REPRESENT TRUE LAND SUBDIVISION.

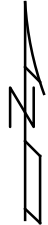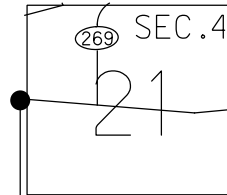

NOTE: REF 132 SR 163

RECORD: P.O.C.
 STA. 254+26.65
 SET P.K./WASHER
 1983
 FD P.K.NAIL
 9/28/09
 3/29/10, KPM
 SV101
 4/23/10, KPM
 9/9/10, JMH
 SET MAG/WASHER
 FINREF132
 9/17/12, SDC
 FD MAG/WASHER
 REFA14
 9/26/18
 2/8/19, JFO
 9/30/21, DSA

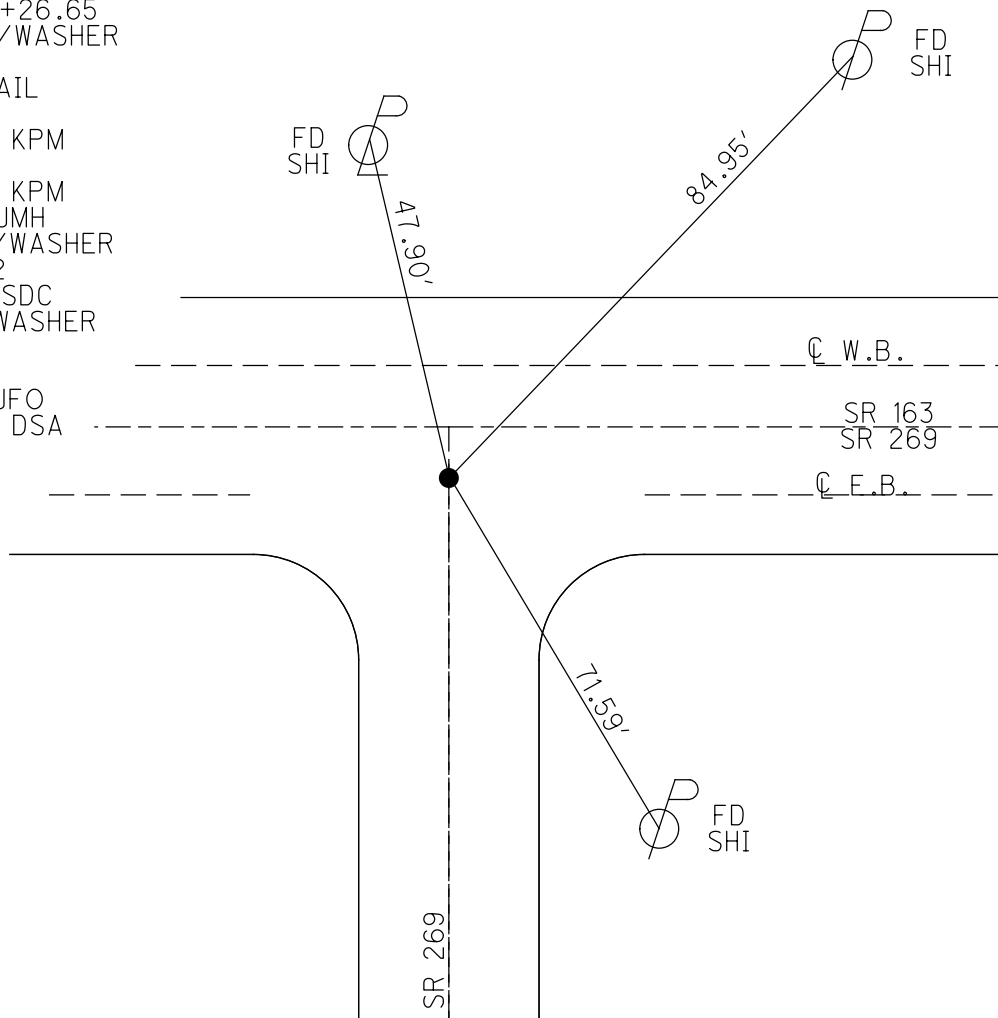

O.D.O.T. DISTRICT 2 SURVEY OFFICE (USE ONLY)

PERSONNEL _____ REFERENCE NO. 14 A SHEET 1 OF 18
 NOTES MOSER DATE 5/5/11 ROUTE SR 269
 H.C. MOSER WEATHER SUNNY COUNTY OTTAWA
 R.C. LUMBREZER TEMP. 60° TOWNSHIP DANBURY
 SECTION 4-21

DWG BY NIESE PID PAV'T TRAIN

TYPE MONUMENT P.K. NAIL

ON SURFACE - ~~BELOW~~ ON

OFFSET ☉ PAVEMENT 13.0' ~~RT~~ : RT



40.9' TO LT EDGE PAVEMENT

STATION: 204+33.4

HORIZ.DATUM: NAD83(2011) GEOID: 2012A


GRID: NORTHING: 679603.040 EASTING: 1878125.169

NOTE:
THIS MAP IS FOR ODOT PURPOSES ONLY
TO INDEX REFERENCE TIES, AND DOES NOT
REPRESENT TRUE LAND SUBDIVISION.

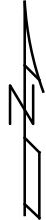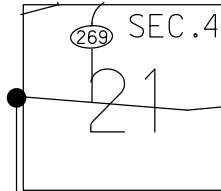

NOTE: REF 132 SR 163

RECORD: P.O.C.
 STA. 254+26.65
 SET P.K./WASHER
 1983
 FD P.K.NAIL
 9/28/09
 3/29/10, KPM
 SV101
 4/23/10, KPM
 9/9/10, JMH
 SET MAG/WASHER
 FINREF132
 9/17/12, SDC
 FD MAG/WASHER
 REFA14
 9/26/18
 2/8/19, JFO

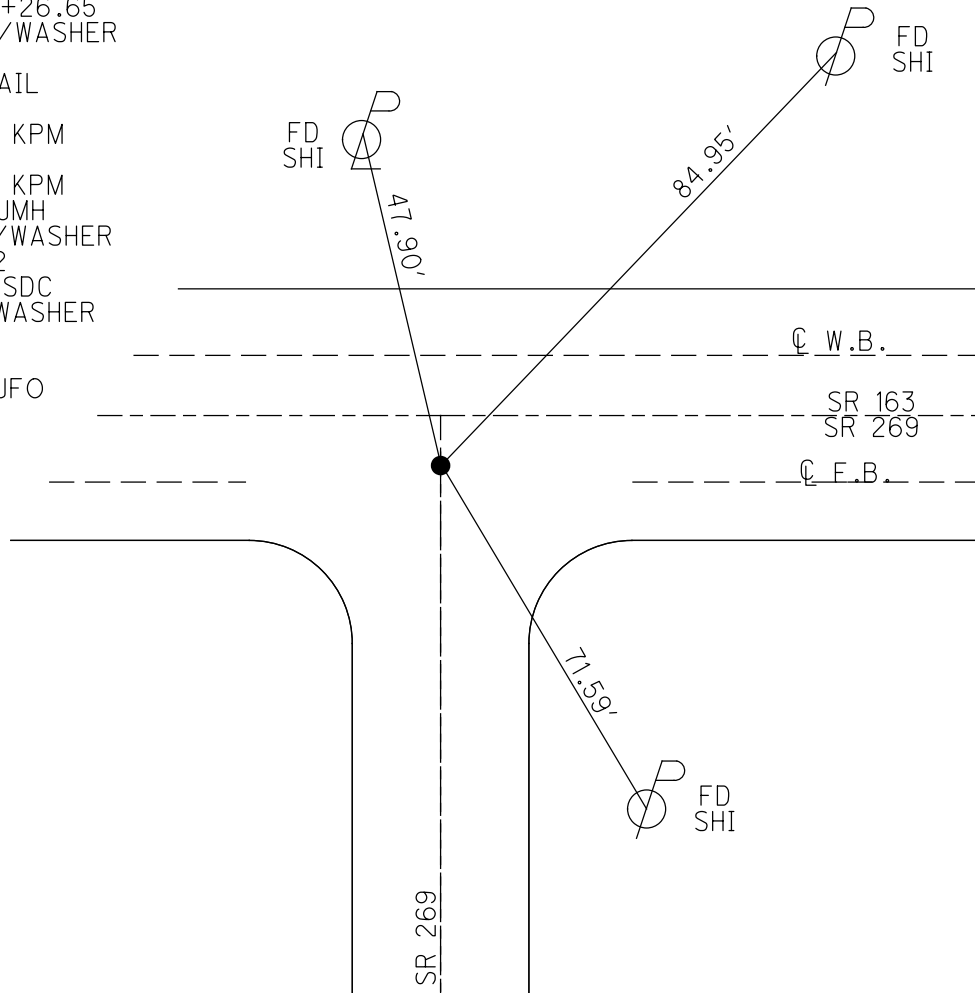

O.D.O.T. DISTRICT 2 SURVEY OFFICE (USE ONLY)

PERSONNEL _____ REFERENCE NO. 14 A SHEET 1 OF 18
 NOTES MOSER DATE 5/5/11 ROUTE SR 269
 H.C. MOSER WEATHER SUNNY COUNTY OTTAWA
 R.C. LUMBREZER TEMP. 60° TOWNSHIP DANBURY
 _____ SECTION 4-24

TYPE MONUMENT P.K.NAIL


ON SURFACE - ~~BELOW~~ ON

~~LEFT~~ - Q PAV'T - RIGHT 13.0'
40.9' TO LT EDGE PAVEMENT

S.L.M. 204+33.4


GRID: NORTHING: 679603.040 EASTING: 1878125.169

NOTE:
THIS MAP IS FOR ODOT PURPOSES ONLY.
TO INDEX REFERENCE TIES, AND DOES NOT
REPRESENT TRUE LAND SUBDIVISION.

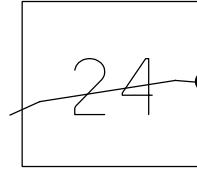

NOTE: REF 132 SR 163

RECORD: P.O.C.
 STA. 254+26.65
 SET P.K./WASHER
 1983

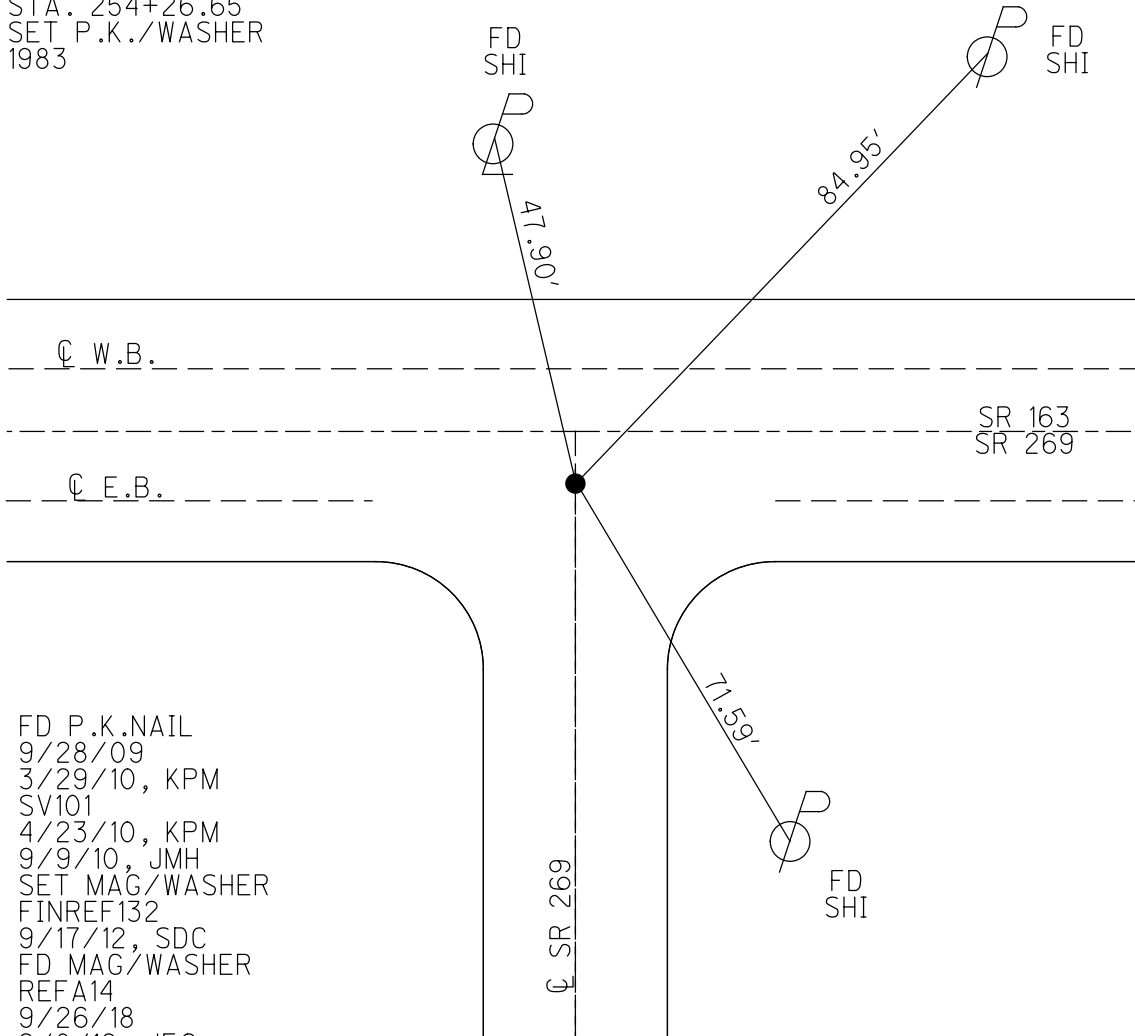


FD P.K.NAIL
 9/28/09
 3/29/10, KPM
 SV101
 4/23/10, KPM
 9/9/10, JMH
 SET MAG/WASHER
 FINREF132
 9/17/12, SDC
 FD MAG/WASHER
 REFA14
 9/26/18
 2/8/19, JFO

O.D.O.T. DISTRICT 2 SURVEY OFFICE (USE ONLY)


PERSONNEL _____ REFERENCE NO. 14 A SHEET 1 OF 18
 NOTES MOSER DATE 5/5/11 ROUTE SR 269
 H.C. MOSER WEATHER SUNNY COUNTY OTTAWA
 R.C. LUMBREZER TEMP. 60° TOWNSHIP DANBURY
 _____ SECTION 4-24

TYPE MONUMENT P.K.
 ON SURFACE - ~~BELOW~~ ON
~~LEFT~~ - C PAV'T - RIGHT 13.0'
 40.9' TO LT EDGE PAVEMENT
 S.L.M. 204+33.4
 GRID: NORTHING: 679603.030 EASTING: 1878125.088

NOTE:
THIS MAP IS FOR ODOT PURPOSES ONLY
TO INDEX REFERENCE TIES, AND DOES NOT
REPRESENT TRUE LAND SUBDIVISION.

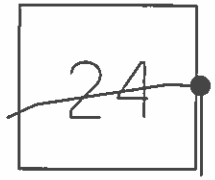

1983 RECORD
 P.O.C. 254+26.65
 SET P.K./WASHER
 2.6' LT C EB PAV'T

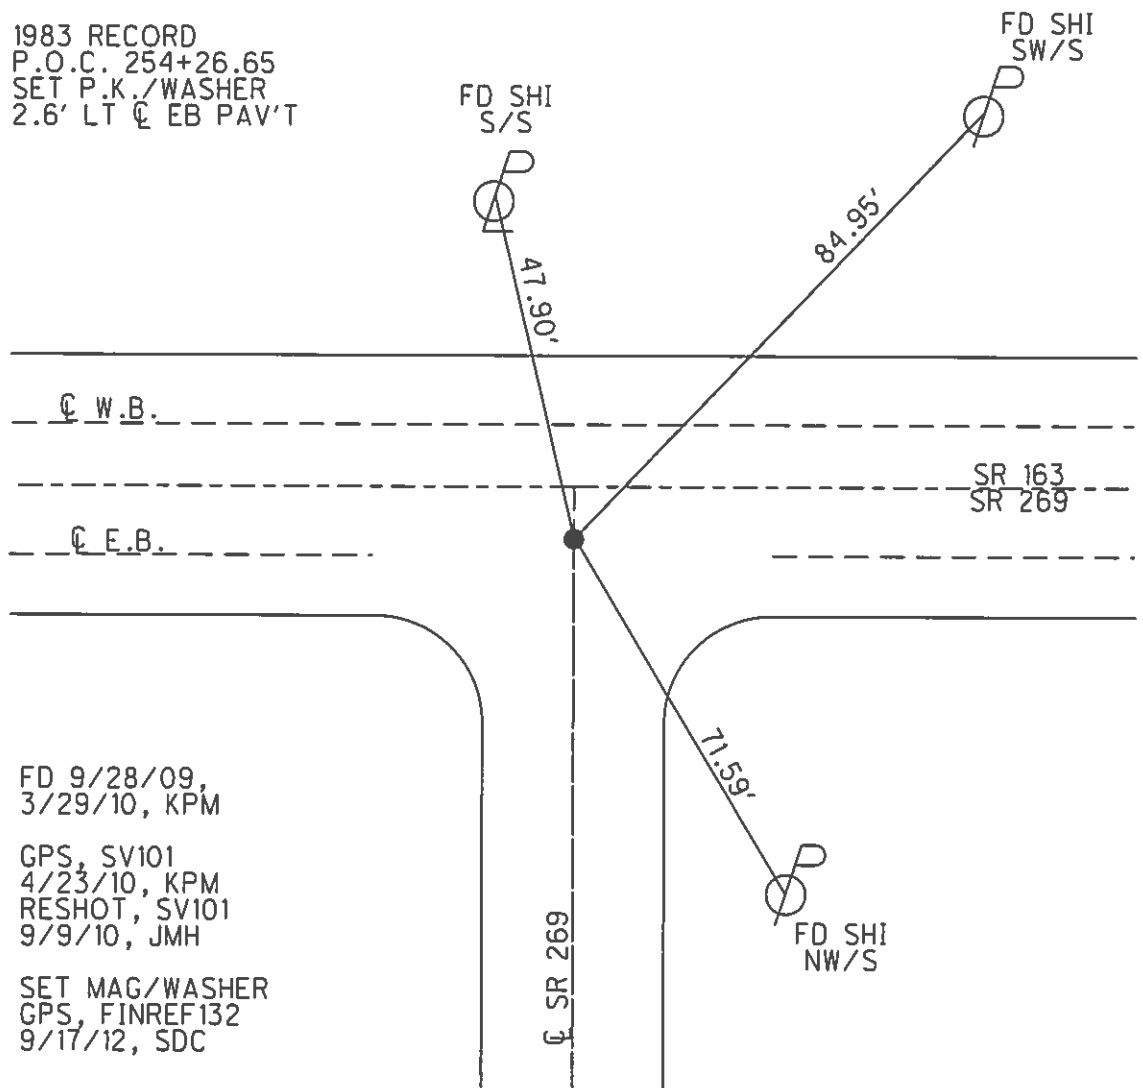

FD 9/28/09,
 3/29/10, KPM
 GPS, SV101
 4/23/10, KPM
 RESHOT, SV101
 9/9/10, JMH
 SET MAG/WASHER
 GPS, FINREF132
 9/17/12, SDC