

O.D.O.T. DISTRICT 2 SURVEY OFFICE (USE ONLY)

PERSONNEL

REFERENCE NO. 14 B

SHEET 3 OF 18

NOTES RHOADES

DATE 12/4/14

ROUTE SR 269

H.C. WESTFALL

WEATHER CLOUDY

COUNTY OTTAWA

R.C. HOMAN

TEMP. 28°

TOWNSHIP DANBURY

SECTION 4-21

DWG BY RHOADES PID 93682

TYPE MONUMENT MONBOX W/1" IPIN


NOTES:
THIS MAP IS FOR ODOT PURPOSES ONLY
TO INDEX REFERENCE TIES, AND DOES NOT
REPRESENT TRUE LAND SUBDIVISION.

ON SURFACE - ~~BELOW~~ ON

OFFSET C PAVEMENT 8.3' LT : RT

- TO - EDGE PAVEMENT

STATION: 226+51.2

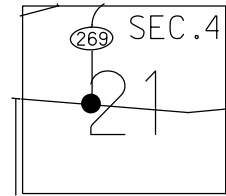


HORIZ.DATUM: NAD83 2011

GEOID: NAVD88 2018

GRID: NORTHING: 679504.025

EASTING: 1880359.041

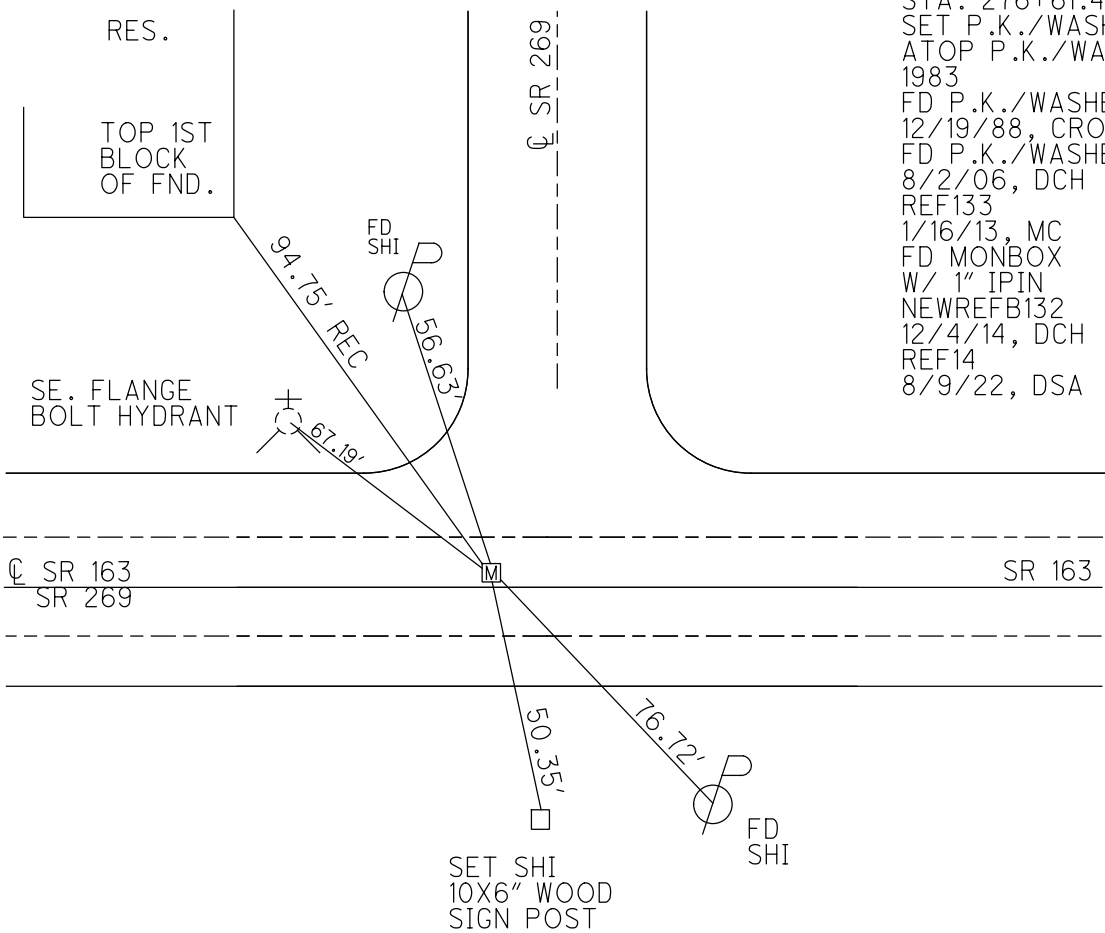

RECORD: P.O.T.
STA. 276+61.45
SET P.K./WASHER
ATOP P.K./WASHER
1983
FD P.K./WASHER
12/19/88, CRONIN
FD P.K./WASHER
8/2/06, DCH
REF133
1/16/13, MC
FD MONBOX
W/ 1" IPIN
NEWREFB132
12/4/14, DCH
REF14
8/9/22, DSA



O.D.O.T. DISTRICT 2 SURVEY OFFICE (USE ONLY)

PERSONNEL _____ REFERENCE NO. 14 B SHEET 3 OF 18

NOTES RHOADES DATE 12/4/14 ROUTE SR 269
 H.C. WESTFALL WEATHER CLOUDY COUNTY OTTAWA
 R.C. HOMAN TEMP. 28° TOWNSHIP DANBURY
 _____ SECTION 4-21

NOTES:
THIS MAP IS FOR ODOT PURPOSES ONLY.
TO INDEX REFERENCE TIES, AND DOES NOT
REPRESENT TRUE LAND SUBDIVISION.

TYPE MONUMENT MON.BOX
 ON SURFACE - ~~BELOW~~ ON
 LEFT - ℄ PAV'T - ~~RIGHT~~ 8.3'
_____ TO _____ EDGE PAVEMENT
 S.L.M. 226+51.2
 GRID: NORTHING: 679503.950 EASTING: 1880359.071

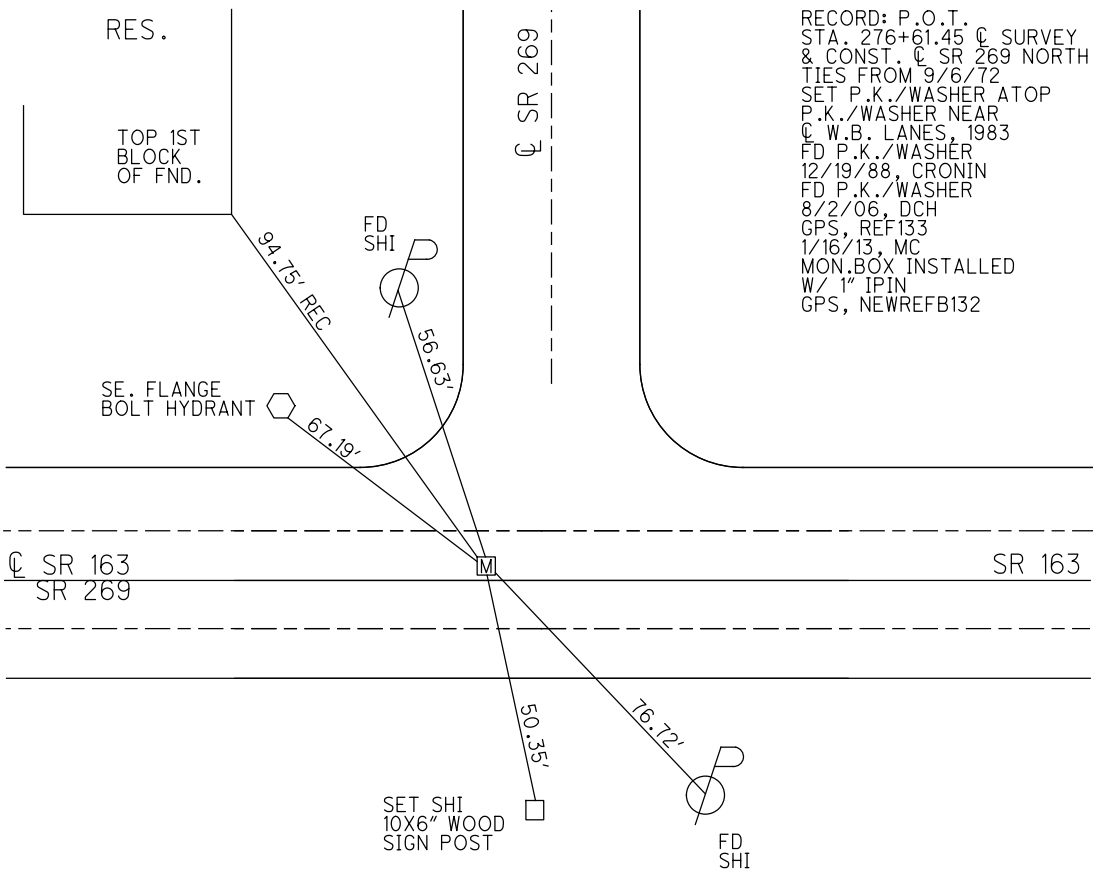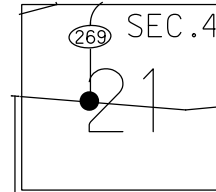

RECORD: P.O.T.
 STA. 276+61.45 ℄ SURVEY
 & CONST. ℄ SR 269 NORTH
 TIES FROM 9/6/72
 SET P.K./WASHER ATOP
 P.K./WASHER NEAR
 ℄ W.B. LANES, 1983
 FD P.K./WASHER
 12/19/88, CRONIN
 FD P.K./WASHER
 8/2/06, DCH
 GPS, REF133
 1/16/13, MC
 MON.BOX INSTALLED
 W/ 1" IPIN
 GPS, NEWREFB132