
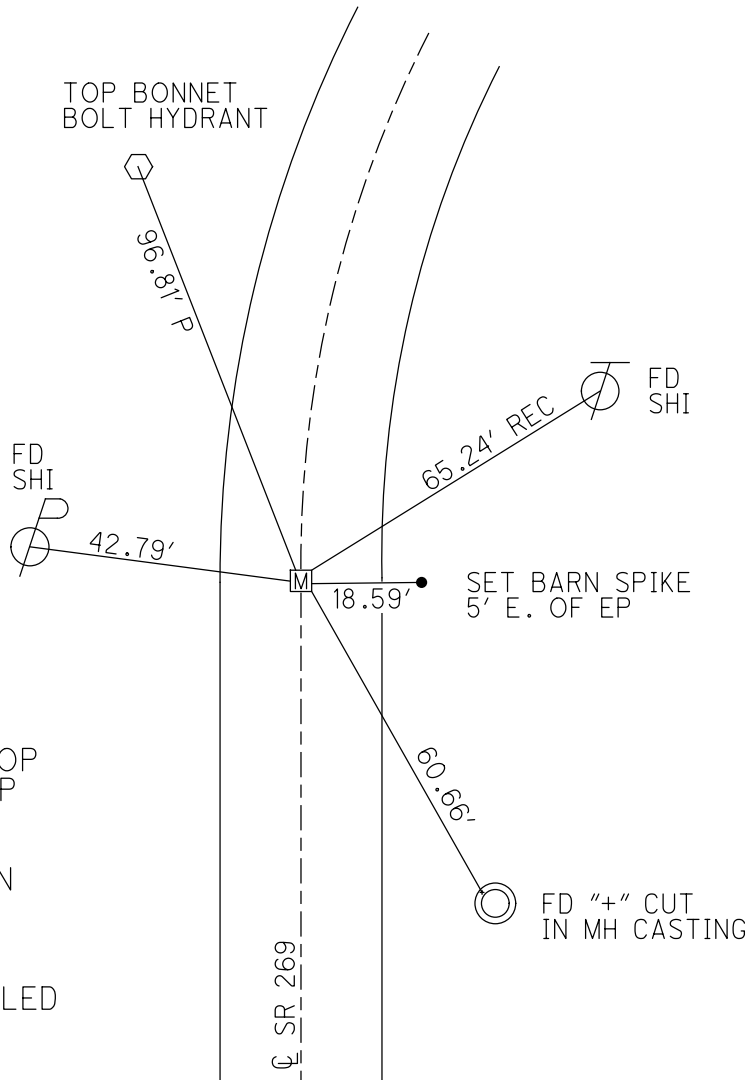


O.D.O.T. DISTRICT 2 SURVEY OFFICE (USE ONLY)

PERSONNEL	REFERENCE NO.	<u>16</u>	SHEET	<u>5</u>	OF	<u>18</u>
NOTES	RHOADES	DATE	<u>12/4/14</u>	ROUTE	<u>SR 269</u>	
H.C.	<u>WESTFALL</u>	WEATHER	<u>CLOUDY</u>	COUNTY	<u>OTTAWA</u>	
R.C.	<u>HOMAN</u>	TEMP.	<u>28°</u>	TOWNSHIP	<u>DANBURY</u>	
				SECTION	<u>4-21</u>	

TYPE MONUMENT MON.BOX
 ON SURFACE - ~~BELOW~~ ON
 LEFT - Q PAV'T - RIGHT ON
11.7' TO LT EDGE PAVEMENT
 S.L.M. 244+44.94
 GRID: NORTHING: 681297.346 EASTING: 1880326.637

NOTE:
THIS MAP IS FOR ODOT PURPOSES ONLY
TO INDEX REFERENCE TIES, AND DOES NOT
REPRESENT TRUE LAND SUBDIVISION.

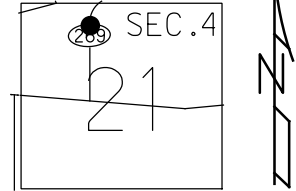

RECORD: S.C.
 STA. 159+09.04
 P.K./WASHER ATOP
 BOLT SPIKE ATOP
 P.K. NAIL
 FD P.K./WASHER
 12/19/88, CRONIN
 FD P.K./WASHER
 GPS, REF16
 1/16/13, MC
 MON.BOX INSTALLED
 W/ 1" IPIN
 GPS, NEWREF16