
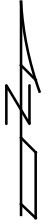


O.D.O.T. DISTRICT 2 SURVEY OFFICE (USE ONLY)

PERSONNEL _____ REFERENCE NO. 17 SHEET 6 OF 18
 NOTES RHOADES DATE 6/13/14 ROUTE SR 269
 H.C. WESTFALL WEATHER CLOUDY COUNTY OTTAWA
 R.C. MEYER TEMP. 65° TOWNSHIP DANBURY
 _____ SECTION 4-21


TYPE MONUMENT _____ IPIN _____
~~ON SURFACE~~ - BELOW 0.4'
 LEFT - ℄ PAV'T - ~~RIGHT~~ 38.2'
26.5' LT TO LT EDGE PAVEMENT
 S.L.M. 246+10.33
 GRID: NORTHING: 681467.483 EASTING: 1880312.067

NOTE:
THIS MAP IS FOR ODOT PURPOSES ONLY.
TO INDEX REFERENCE TIES, AND DOES NOT
REPRESENT TRUE LAND SUBDIVISION.

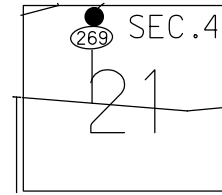

RESTAURANT
BILLBOARD
1' UP W. POST

TOP BONNET
BOLT HYDRANT

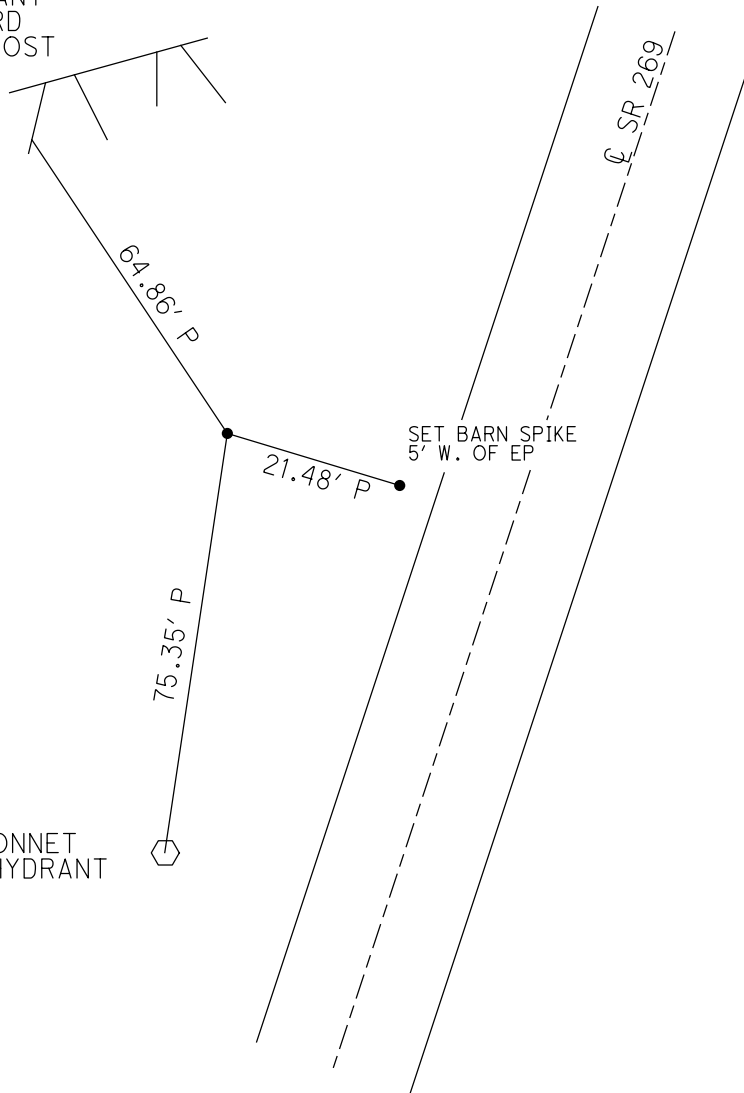

RECORD: P.I.
 STA. 160+79.10
 ℄ SURVEY & CONST.
 FD IPIN
 12/19/88, CRONIN
 FD IPIN
 GPS, REF17
 1/16/13, MC
 MON. BOX INSTALLED
 W/ 1" IPIN
 GPS, NEWREF17
 12/4/14, EBW