


O.D.O.T. DISTRICT 2 SURVEY OFFICE (USE ONLY)

PERSONNEL _____ REFERENCE NO. 20 SHEET 9 OF 18
 NOTES RHOADES DATE 12/4/14 ROUTE SR 269
 H.C. WESTFALL WEATHER CLOUDY COUNTY OTTAWA
 R.C. HOMAN TEMP. 28° TOWNSHIP DANBURY
 _____ SECTION 4-21

TYPE MONUMENT MON.BOX
 ON SURFACE - ~~BELOW~~ ON
 LEFT - Q PAV'T - RIGHT ON
11.7' TO LT EDGE PAVEMENT
 S.L.M. 254+01.87
 GRID: NORTHING: 682389.697 EASTING: 1880714.354

NOTE:
 THIS MAP IS FOR ODOT PURPOSES ONLY
 TO INDEX REFERENCE TIES, AND DOES NOT
 REPRESENT TRUE LAND SUBDIVISION.

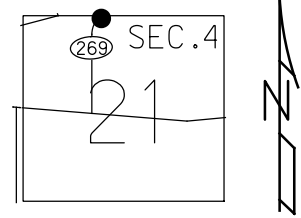

RECORD: T.S.
 STA. 168+65.49
 P.K./WASHER ATOP
 P.K./WASHER ATOP
 P.K.NAIL
 FD P.K./WASHER
 12/19/88, CRONIN
 FD P.K., 0.3' DOWN
 GPS, REF20
 1/18/13, MC
 MON.BOX INSTALLED
 W/ 1" IPIN
 GPS, NEWREF20

