
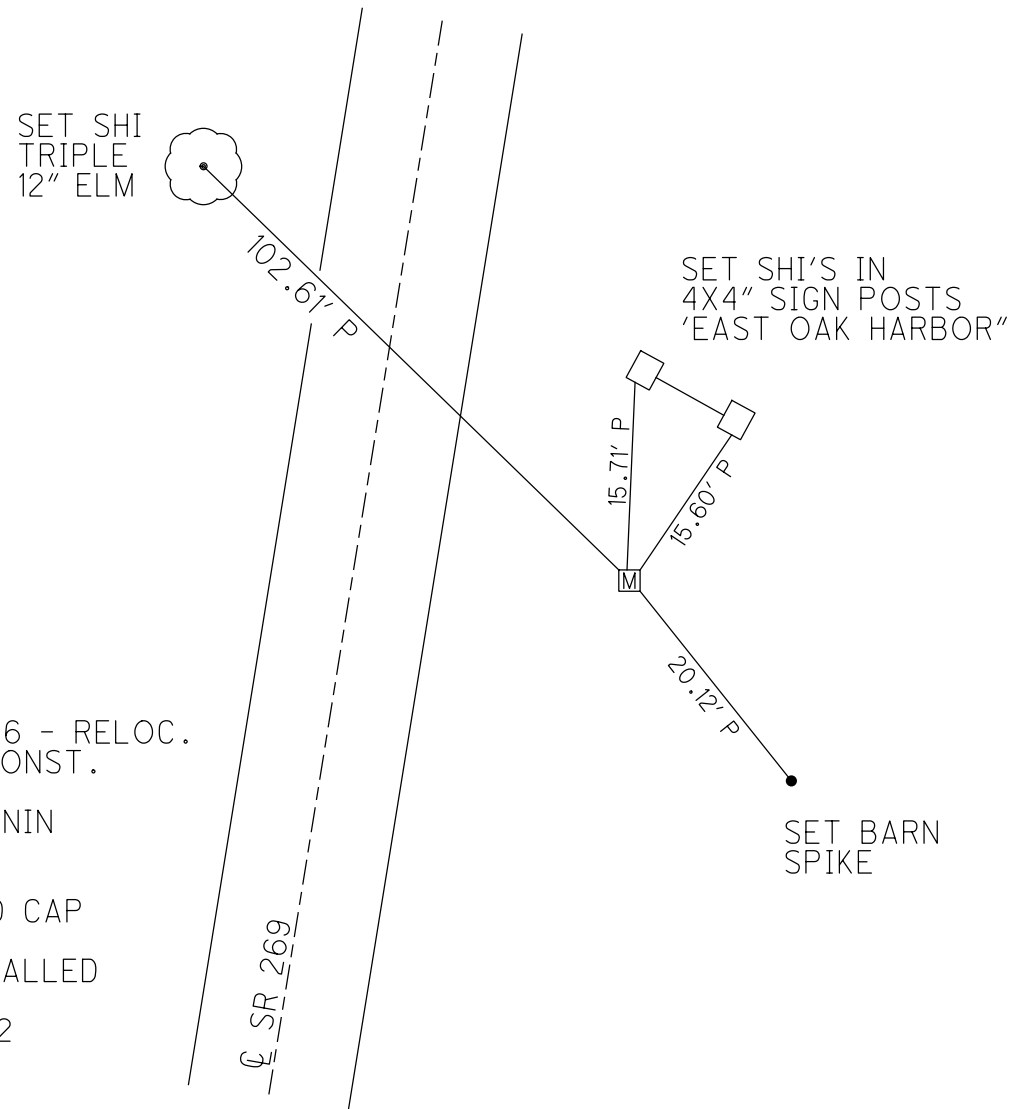
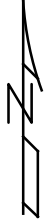


O.D.O.T. DISTRICT 2 SURVEY OFFICE (USE ONLY)

PERSONNEL	REFERENCE NO.	<u>22</u>	SHEET	<u>12</u>	OF	<u>18</u>
NOTES	<u>RHOADES</u>	DATE	<u>12/4/14</u>	ROUTE	<u>SR 269</u>	
H.C.	<u>WESTFALL</u>	WEATHER	<u>CLOUDY</u>	COUNTY	<u>OTTAWA</u>	
R.C.	<u>HOMAN</u>	TEMP.	<u>28°</u>	TOWNSHIP	<u>DANBURY</u>	
				SECTION	<u>3-22</u>	

NOTE:
THIS MAP IS FOR ODOT PURPOSES ONLY
TO INDEX REFERENCE TIES, AND DOES NOT
REPRESENT TRUE LAND SUBDIVISION.

TYPE MONUMENT MON.BOX
 ON SURFACE - ~~BELOW~~ ON
~~LEFT~~ - Q PAV'T - RIGHT 27.6'
39.5' RT TO RT EDGE PAVEMENT
 S.L.M. 258+71.85
 GRID: NORTHING: 682632.635 EASTING: 1880825.033

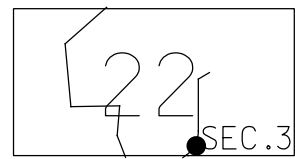

RECORD: P.I.
 STA. 173+40.76 - RELOC.
 Q SURVEY & CONST.
 FD IPIN
 12/19/88, CRONIN
 SET IPIN
 3/20/13, MC
 FD IPIN W/RED CAP
 6/25/14
 MON.BOX INSTALLED
 W/1" IPIN
 GPS, NEWREF22
 12/4/14, EBW