
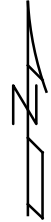


O.D.O.T. DISTRICT 2 SURVEY OFFICE (USE ONLY)


PERSONNEL _____ REFERENCE NO. 24 SHEET 14 OF 18
 NOTES RHOADES DATE 12/4/14 ROUTE SR 269
 H.C. WESTFALL WEATHER CLOUDY COUNTY OTTAWA
 R.C. HOMAN TEMP. 28° TOWNSHIP DANBURY
 _____ SECTION 3-22

NOTE:
THIS MAP IS FOR ODOT PURPOSES ONLY
TO INDEX REFERENCE TIES, AND DOES NOT
REPRESENT TRUE LAND SUBDIVISION.

TYPE MONUMENT MON.BOX
 ON SURFACE - ~~BELOW~~ ON
 LEFT - Q PAV'T - RIGHT ON
11.4' TO RT EDGE PAVEMENT
 S.L.M. 262+55.90
 GRID: NORTHING: 683023.107 EASTING: 1880812.838

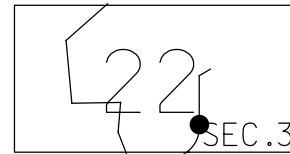

RECORD: P.O.T.
 STA. 177+20.12
 RELOCATION

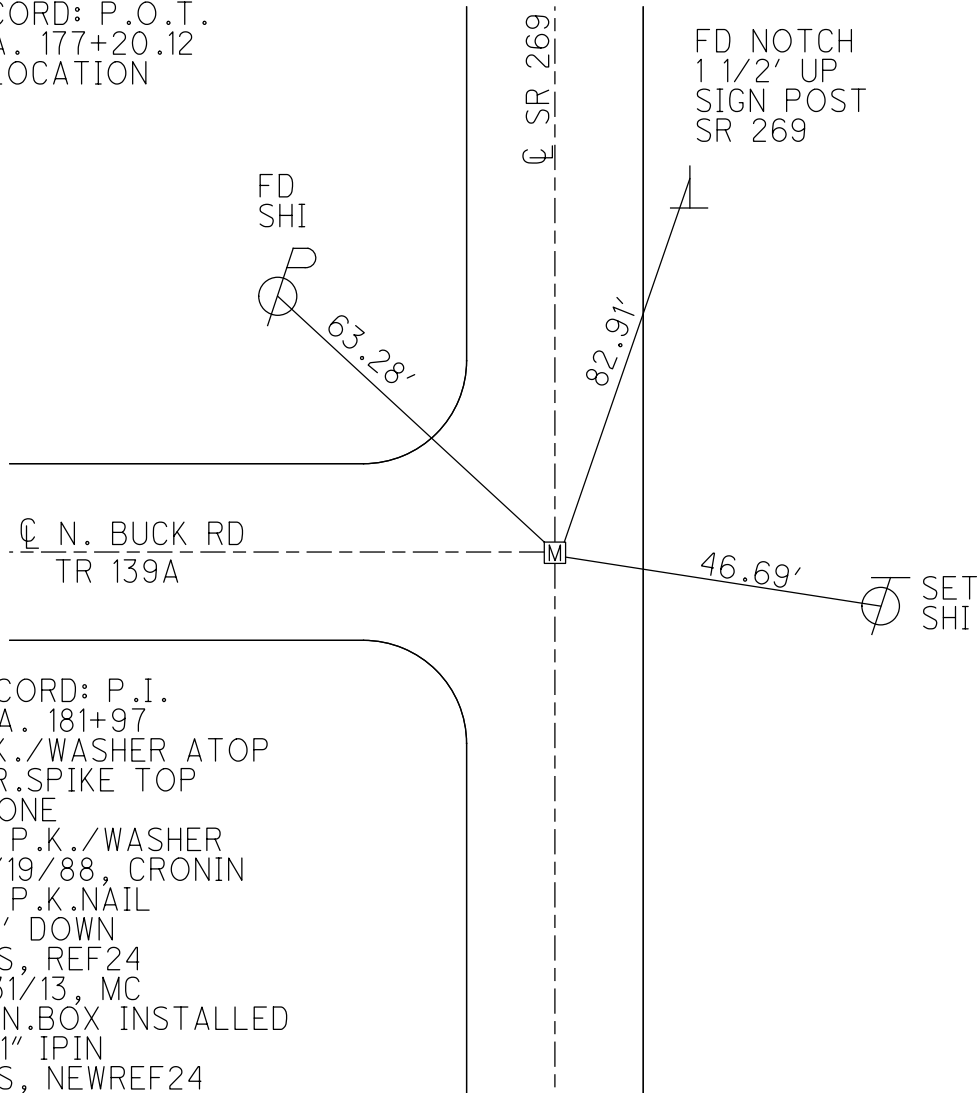

RECORD: P.I.
 STA. 181+97
 P.K./WASHER ATOP
 R.R.SPIKE TOP
 STONE
 FD P.K./WASHER
 12/19/88, CRONIN
 FD P.K.NAIL
 0.1' DOWN
 GPS, REF24
 1/31/13, MC
 MON.BOX INSTALLED
 W/1" IPIN
 GPS, NEWREF24