
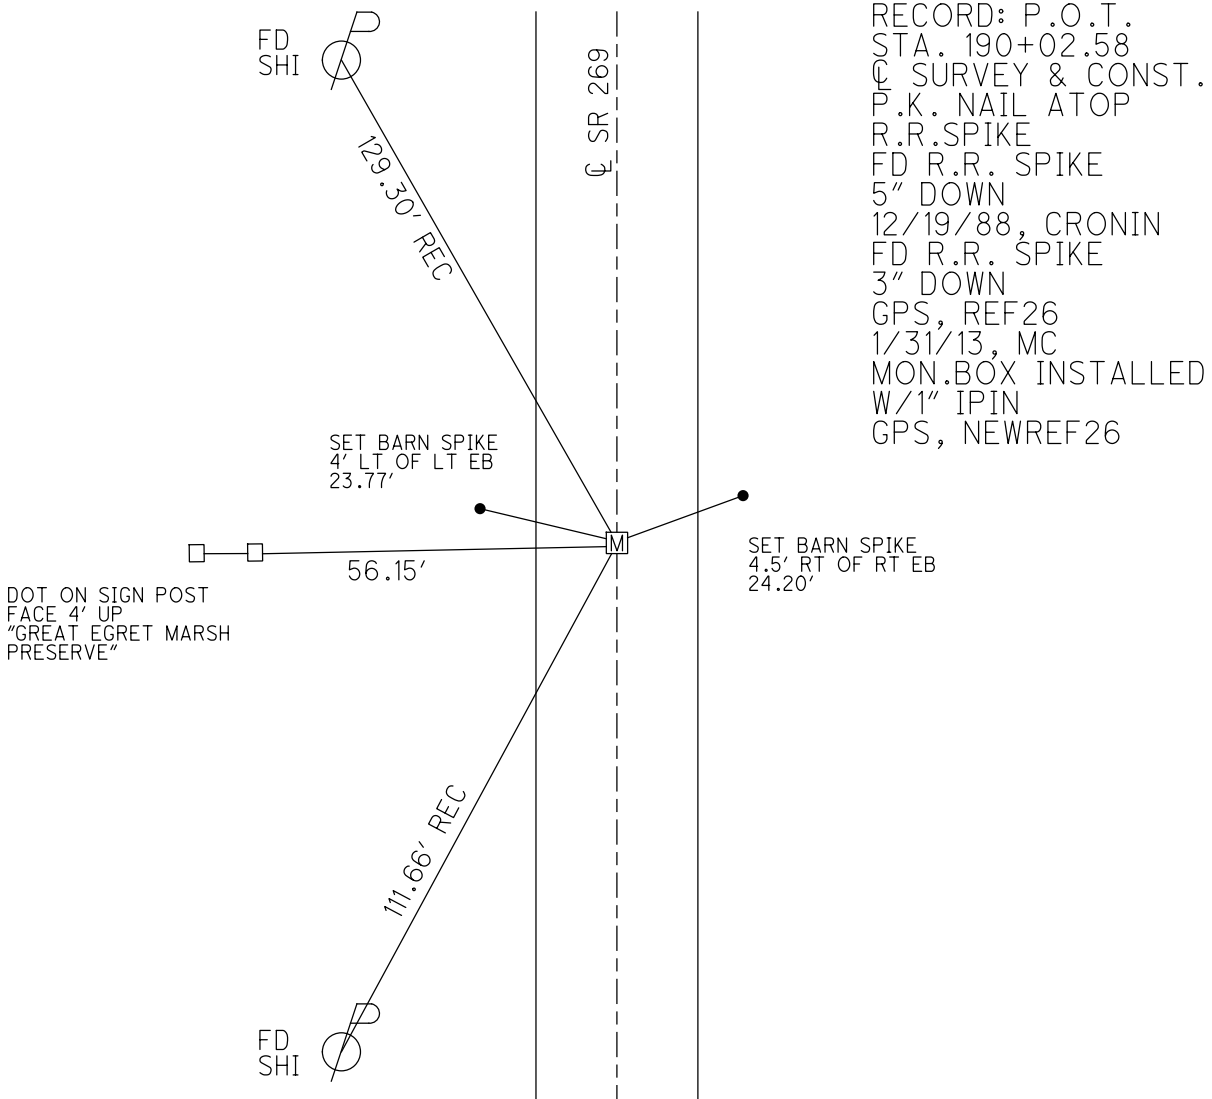
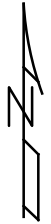


O.D.O.T. DISTRICT 2 SURVEY OFFICE (USE ONLY)

PERSONNEL _____ REFERENCE NO. 26 SHEET 16 OF 18
 NOTES RHOADES DATE 12/4/14 ROUTE SR 269
 H.C. WESTFALL WEATHER CLOUDY COUNTY OTTAWA
 R.C. HOMAN TEMP. 28° TOWNSHIP DANBURY
 _____ SECTION 3-22

NOTE:
 THIS MAP IS FOR ODOT PURPOSES ONLY
 TO INDEX REFERENCE TIES, AND DOES NOT
 REPRESENT TRUE LAND SUBDIVISION.

TYPE MONUMENT MON.BOX
 ON SURFACE - ~~BELOW~~ ON
 LEFT - Q PAV'T - RIGHT ON
- TO - EDGE PAVEMENT
 S.L.M. 270+61.39
 GRID: NORTHING: 683828.297 EASTING: 1880788.028

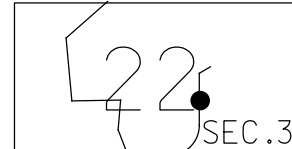

RECORD: P.O.T.
 STA. 190+02.58
 C SURVEY & CONST.
 P.K. NAIL ATOP
 R.R. SPIKE
 FD R.R. SPIKE
 5" DOWN
 12/19/88, CRONIN
 FD R.R. SPIKE
 3" DOWN
 GPS, REF26
 1/31/13, MC
 MON.BOX INSTALLED
 W/1" IPIN
 GPS, NEWREF26