

PERSONNEL	TITLE	PERSONNEL	TITLE	COUNTY	DATE	WEATHER	TEMP.
Cronin		Baumann		Ottawa	7/24/61	rainny	90°
Barbour				#357			
Pacchini				SEC. Put-in Bay O.			
Depinet							


DESCRIPTION Control Point Ties JOB NO. _____

* ALL points plumbed

Set P.K. Nail
 P.I. 5+09.17
 $\Delta = 39^\circ 42' \text{ Lt.}$


Set P.K. Nail
 P.I. 4+14.30
 $\Delta = 94^\circ 25' \text{ Lt.}$

Set P.K. Nail
 0+00

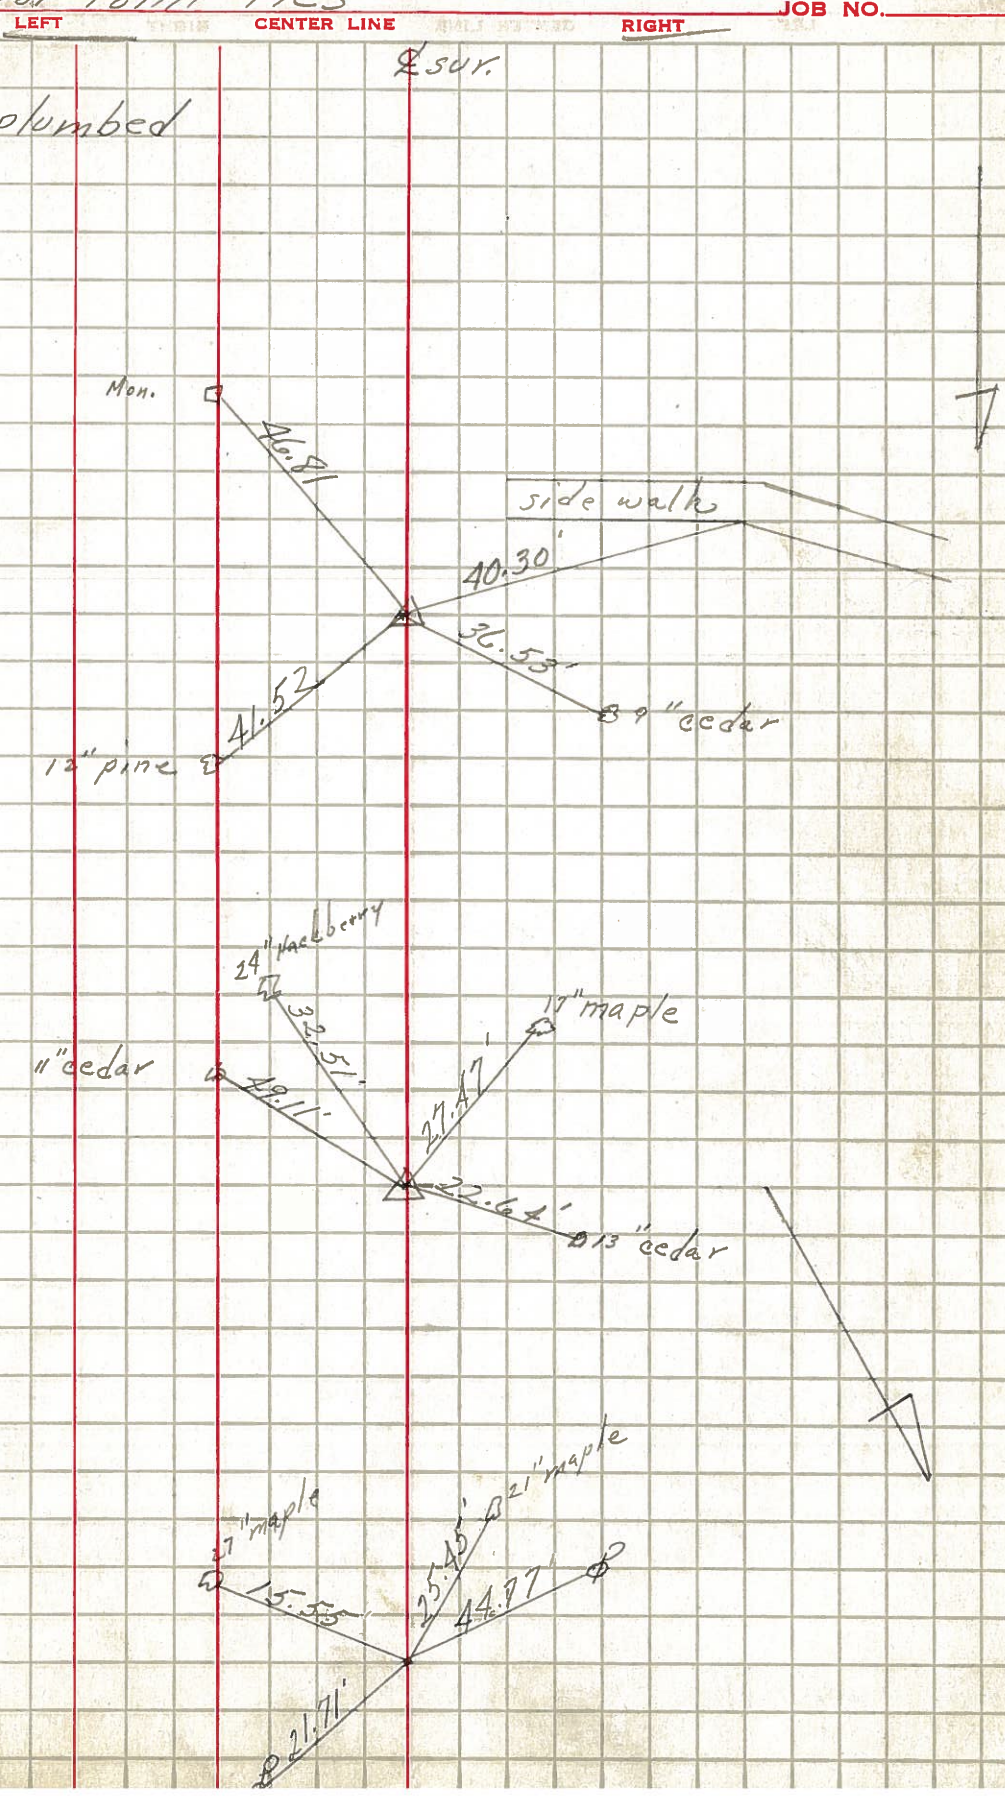

PERSONNEL	TITLE	PERSONNEL	TITLE	COUNTY	DATE	S. R.	WEATHER	TEMP.
Cronin		Baumann		Ottawa	7/24/61	#357	rainny	70°
Barbour								
Pacchini								
Depinet				Put-in-Bay O.				

DESCRIPTION Control Point Ties JOB NO. _____

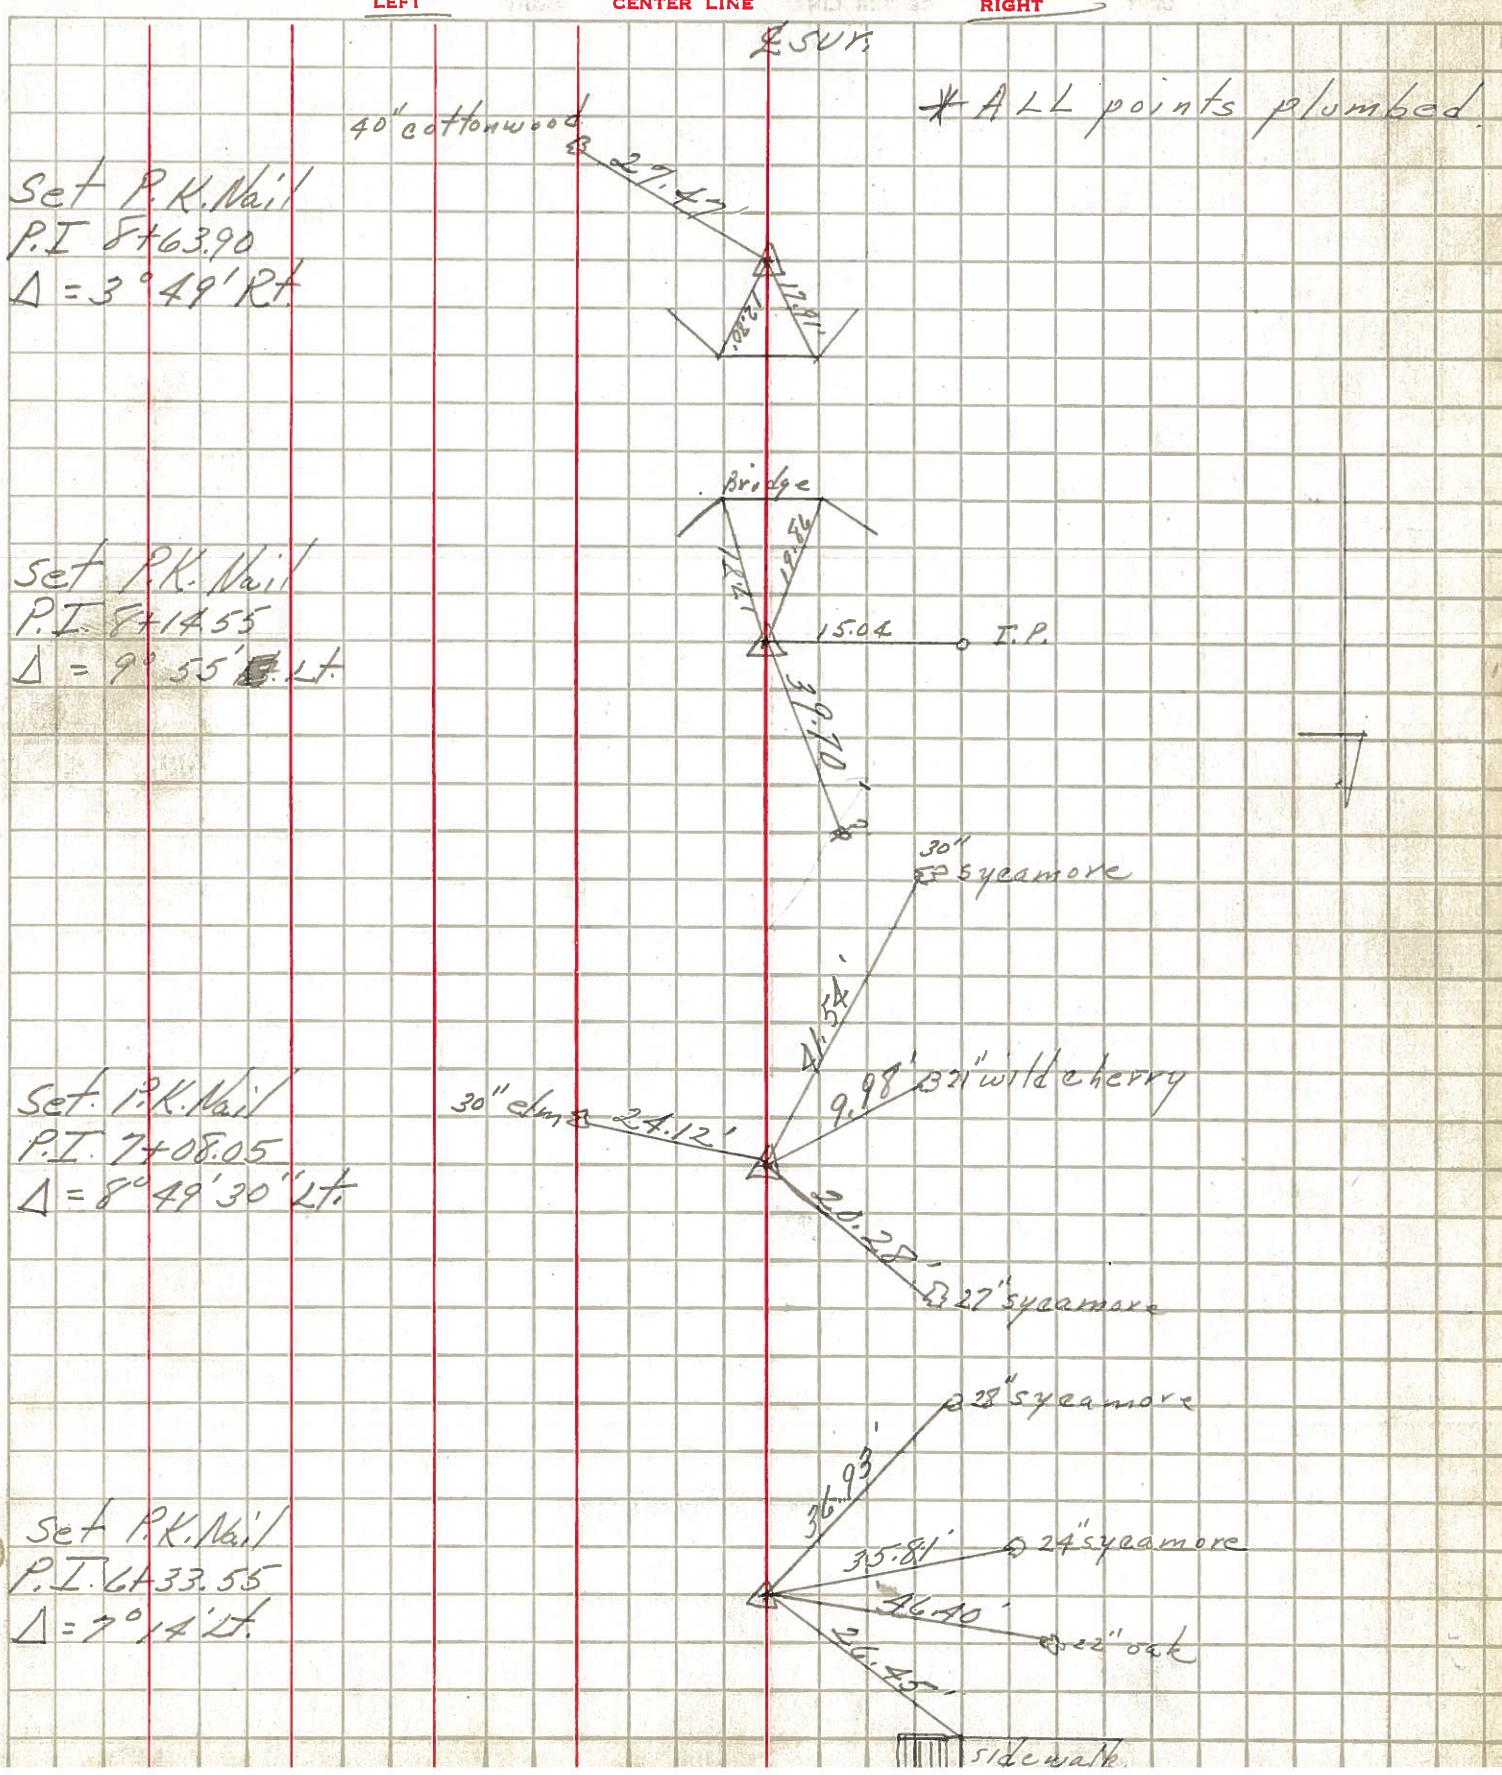

Set P.K. Nail
 P.I. 8+63.90
 $\Delta = 3^\circ 49' \text{ Rt.}$

Set P.K. Nail
 P.I. 8+14.55
 $\Delta = 9^\circ 55' \text{ Lt.}$

Set P.K. Nail
 P.I. 7+08.05
 $\Delta = 8^\circ 49' 30" \text{ Lt.}$

Set P.K. Nail
 P.I. 6+33.55
 $\Delta = 7^\circ 14' \text{ Lt.}$

PERSONNEL: Cronin TITLE: _____ PERSONNEL: Baumann TITLE: _____ COUNTY: _____ DATE: 7/24/61
Barbour _____ _____ _____ _____ _____
Pacehini _____ _____ _____ _____ _____
Depinet _____ _____ _____ _____ _____
 S. R. # 357 WEATHER sunny
 SEC Put-in-Bay O. TEMP. 75°
 DESCRIPTION: Control Points Ties JOB NO. _____

