

O.D.O.T. DISTRICT 2 SURVEY OFFICE (USE ONLY)

PERSONNEL

REFERENCE NO. CP 20

SHEET 1 OF 5

NOTES HOMAN

DATE 11/18/09

ROUTE SR 357

H.C. HOMAN

WEATHER CLOUDY

COUNTY OTTAWA

R.C. ROUSOS

TEMP. 45°

SOUTH BASS

HARBAUGH

ISLAND

DWG BY RHOADES PID 25525

TYPE MONUMENT 1/2" IPIN

~~ON SURFACE~~ - BELOW 4"

OFFSET Q PAVEMENT 3' LT : ~~RT~~

- TO - EDGE PAVEMENT


STATION: 10+32.22

HORIZ.DATUM: NAD 1983

GEOID: 2003

GRID: NORTHING: 725238.760

EASTING: 1879251.537

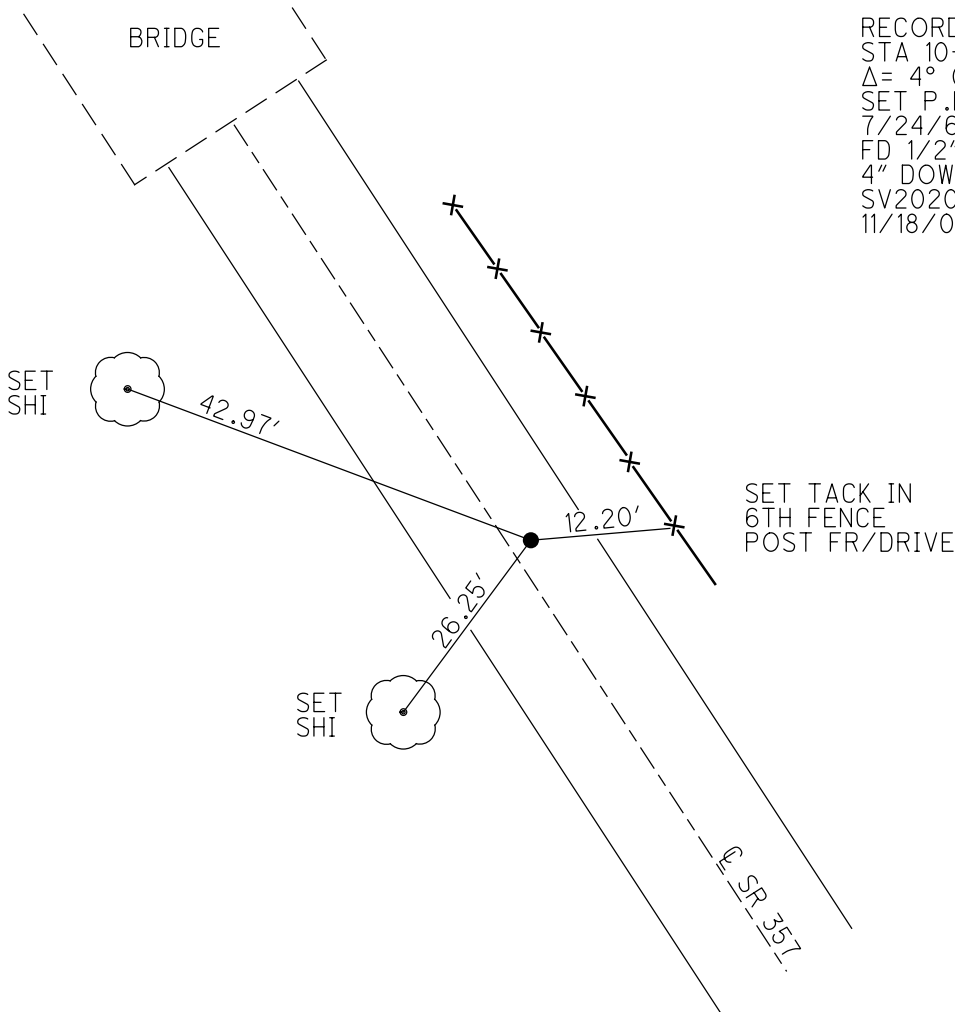

RECORD: P.I.  
STA 10+58.92  
 $\Delta = 4^{\circ} 06' RT$   
SET P.K.NAIL  
7/24/61, CRONIN  
FD 1/2" IPIN  
4" DOWN  
SV2020  
11/18/09, DCH

PERSONNEL	TITLE	PERSONNEL	TITLE	COUNTY	DATE
Homan	H.C. SA			OTT	11-18-09
Rousos	RC			S.R.	357
Harbaugh				SEC.	0
DESCRIPTION				WEATHER	TEMP.
Note Point Names are for file				Cloudy	45°
				JOB NO.	Pid 25525

LEFT CENTER LINE RIGHT

