

O.D.O.T. DISTRICT 2 SURVEY OFFICE (USE ONLY)


PERSONNEL _____ REFERENCE NO. CP 21 SHEET 2 OF 5
 NOTES HOMAN DATE 11/18/09 ROUTE SR 357
 H.C. HOMAN WEATHER CLOUDY COUNTY OTTAWA
 R.C. ROUSOS TEMP. 45° SOUTH BASS
HARBAUGH ISLAND
 DWG BY RHOADES PID 25525

TYPE MONUMENT P.K.NAIL
 ON SURFACE - ~~BELOW~~ ON
 OFFSET 6.77' RT
TO EDGE PAVEMENT
 STATION: 14+27.39

HORZ.DATUM: NAD 1983 GEOID: 2003
 GRID: NORTHING: 724881.546 EASTING: 1879255.504



RECORD: P.I.
 STA 13+59.51
 $\Delta = 14^\circ 01' \text{ LT}$
 SET P.K.NAIL
 7/24/61, CRONIN
 FD P.K.NAIL
 SV2021
 11/18/09, DCH

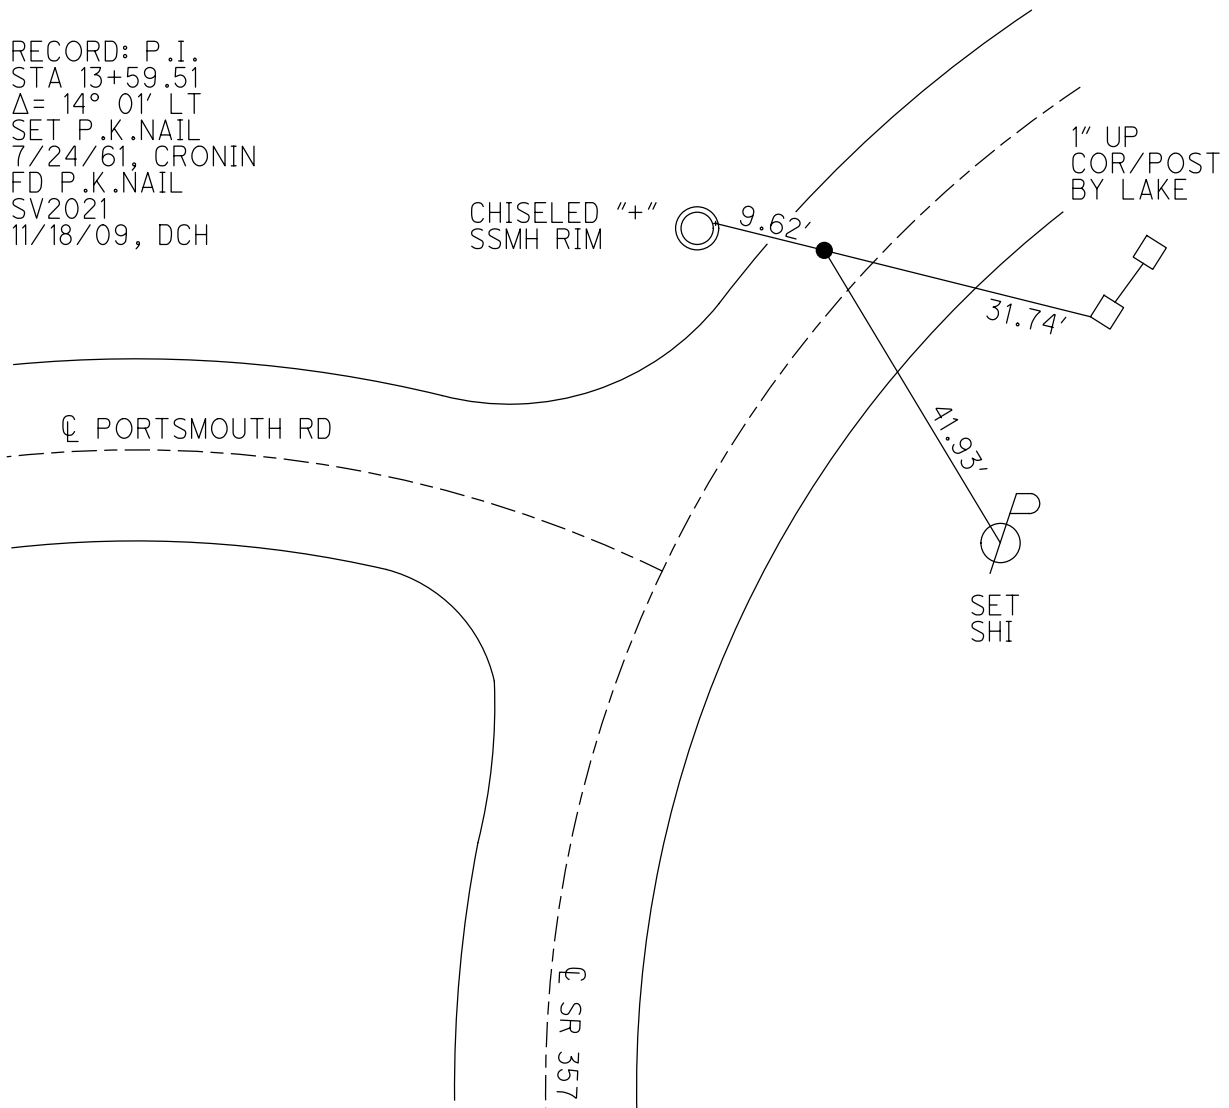

PERSONNEL	TITLE	PERSONNEL	TITLE	COUNTY	DATE
Homan	H.C. SA			OTT	11-18-09
Rousos	RC			S.R.	357
Harbaugh				SEC.	0
DESCRIPTION				WEATHER	TEMP.
Note Point Names are for file				Cloudy	45°
25625 Extra				JOB NO. P1025525	

LEFT CENTER LINE RIGHT

