

O.D.O.T. DISTRICT 2 SURVEY OFFICE (USE ONLY)


PERSONNEL \_\_\_\_\_ REFERENCE NO. CP 22 SHEET 3 OF 5  
 NOTES HOMAN DATE 11/18/09 ROUTE SR 357  
 H.C. HOMAN WEATHER CLOUDY COUNTY OTTAWA  
 R.C. ROUSOS TEMP. 45° SOUTH BASS  
HARBAUGH ISLAND  
 DWG BY RHOADES PID 25525

TYPE MONUMENT P.K.NAIL  
 ON SURFACE - ~~BELOW~~ ON \_\_\_\_\_  
 OFFSET  $\odot$  PAVEMENT ON \_\_\_\_\_ LT : RT  
 \_\_\_\_\_ TO \_\_\_\_\_ EDGE PAVEMENT  
 STATION: 25+69.03

HORIZ.DATUM: NAD 1983 GEOID: 2003  
 GRID: NORTHING: 724330.681 EASTING: 1879915.804



RECORD: P.I.  
 STA 25+68.76  
 $\Delta = 14^\circ 36' \text{ LT}$   
 7/24/61  
 FD P.K.NAIL  
 SV2022  
 11/18/09, DCH

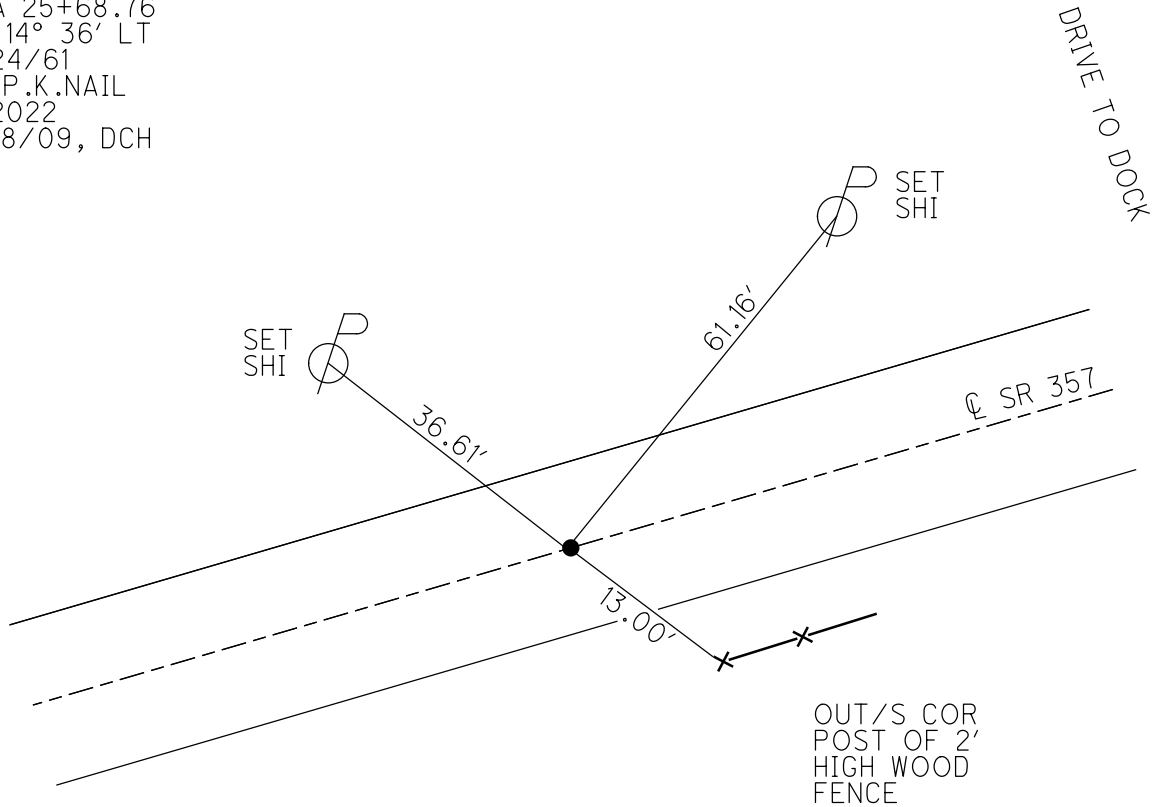

PERSONNEL	TITLE	PERSONNEL	TITLE	COUNTY	DATE
Homan	H.C. SA			OTT	11-18-09
Rousos	RC			S.R.	357
Harbaugh				SEC.	0
DESCRIPTION				WEATHER	TEMP.
Note Point Names are for file				Cloudy	45°
25625 Extra				JOB NO. P1025525	

LEFT CENTER LINE RIGHT

