

O.D.O.T. DISTRICT 2 SURVEY OFFICE (USE ONLY)


PERSONNEL _____ REFERENCE NO. CP 6 SHEET 4 OF 5
 NOTES HOMAN DATE 11/18/09 ROUTE SR 357
 H.C. HOMAN WEATHER CLOUDY COUNTY OTTAWA
 R.C. ROUSOS TEMP. 45° SOUTH BASS
 HARBAUGH ISLAND
 DWG BY RHOADES PID 25525

TYPE MONUMENT MAG NAIL
 ON SURFACE - ~~BELOW~~ ON
 OFFSET ☉ PAVEMENT ON LT : RT
- TO - EDGE PAVEMENT
 STATION: 37+03.13

HORIZ.DATUM: NAD 1983 GEOID: 2003
 GRID: NORTHING: 724017.507 EASTING: 1880898.452



RECORD: P.I.
 STA 36+85.68
 $\Delta = 7^\circ 34' RT$
 7/24/61
 FD MAG NAIL
 CP6
 11/18/09, DCH

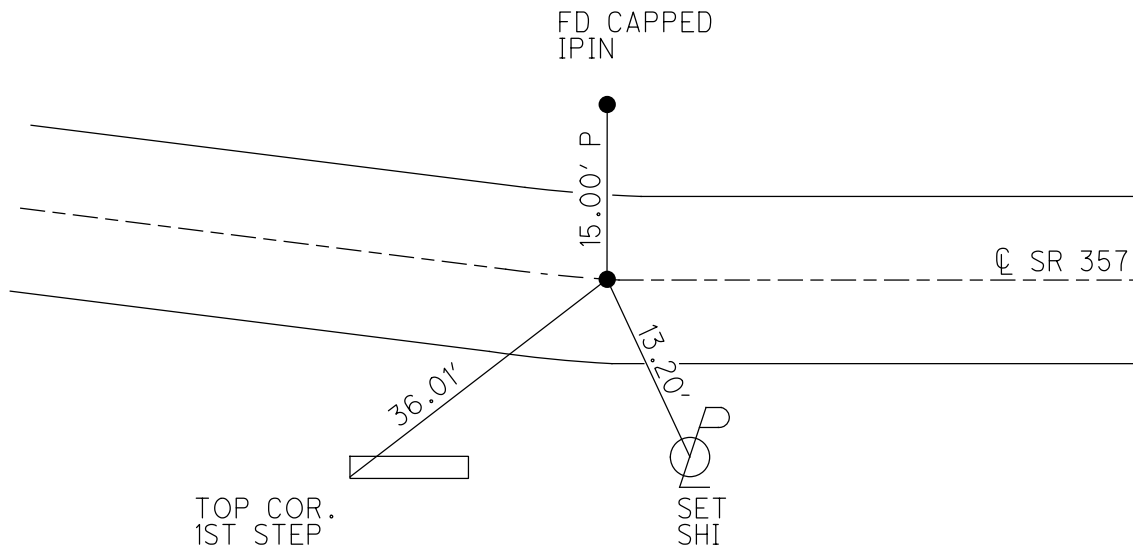

PERSONNEL	TITLE	PERSONNEL	TITLE	COUNTY	DATE
Homan	HC TR			OTT	11-18-09
Rousos	RC			S. R. 357	WEATHER Cloudy
Harbaugh				SEC. 0	TEMP. 45

DESCRIPTION _____ JOB NO. PID 25525

