

O.D.O.T. DISTRICT 2 SURVEY OFFICE (USE ONLY)

PERSONNEL

REFERENCE NO. CP 7

SHEET 1 OF 5

NOTES HOMAN

DATE 11/18/09

ROUTE SR 357

H.C. HOMAN

WEATHER CLOUDY

COUNTY OTTAWA

R.C. ROUSOS

TEMP. 45°

SOUTH BASS
ISLAND

DWG BY RHOADES

PID 25525

TYPE MONUMENT R.R.SPIKE

~~ON SURFACE~~ - BELOW 1 1/2"

OFFSET \varnothing PAVEMENT ON LT : ~~RT~~

- TO - EDGE PAVEMENT


STATION: 39+82.33

HORZ.DATUM: NAD 1983

GEOID: 2003

GRID: NORTHING: 724012.639

EASTING: 1881177.556

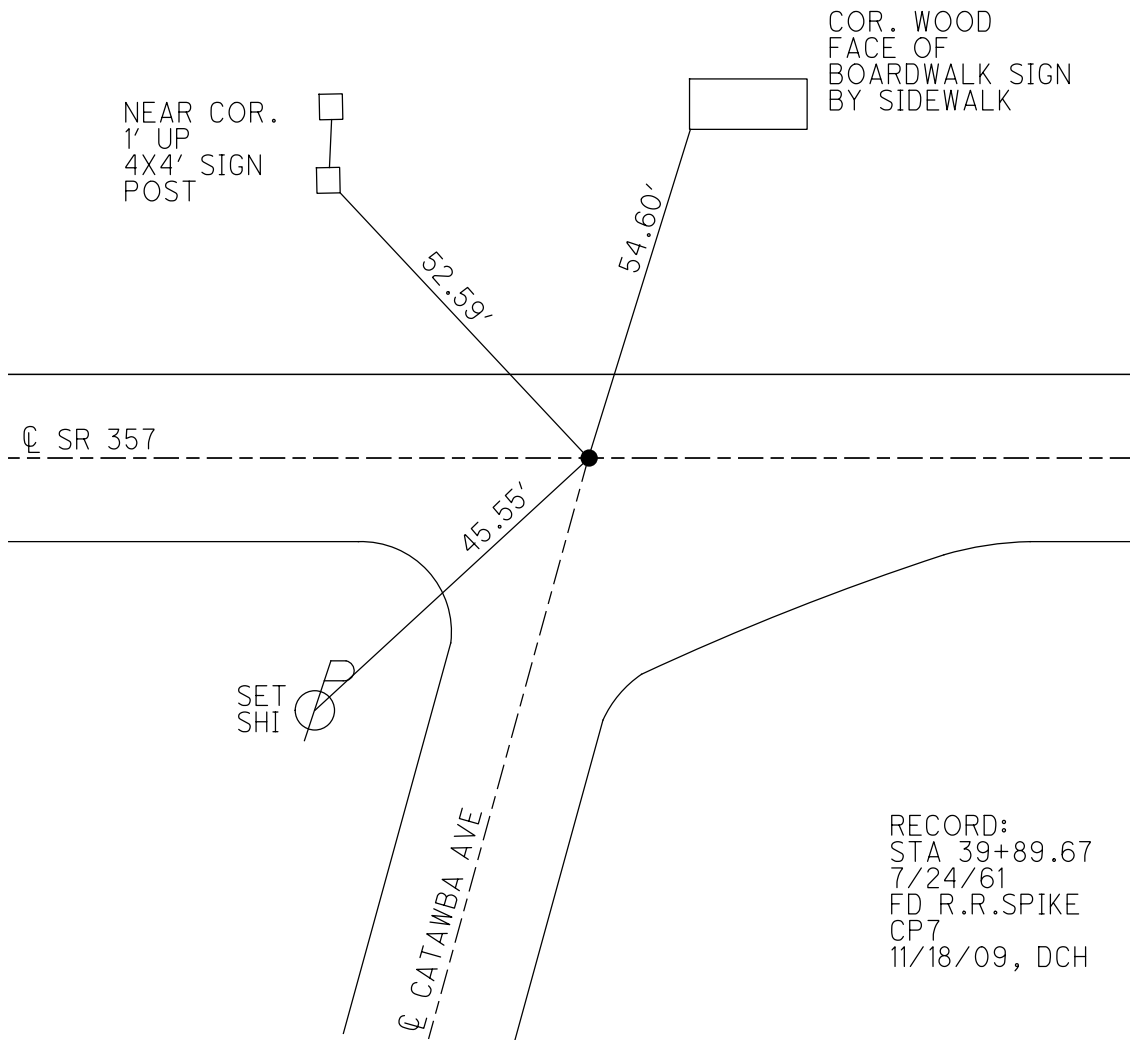

PERSONNEL	TITLE	PERSONNEL	TITLE	COUNTY	DATE
Homan	HC			OTT	11-18-09
Rousos	RC			S. R. 357	WEATHER Cloudy
Harbaugh				SEC. 0	TEMP. 45

DESCRIPTION _____ JOB NO. PID 25525

