

O.D.O.T. DISTRICT 2 SURVEY OFFICE (USE ONLY)

PERSONNEL _____ REFERENCE NO. 1 SHEET 1 OF 27
 NOTES HOMAN DATE 9/25/12 ROUTE SR 357
 H.C. HOMAN WEATHER PTLY CLOUDY COUNTY OTTAWA
 R.C. ROUSOS TEMP. 53° SOUTH BASS ISLAND


DWG BY RHOADES PID 25525

TYPE MONUMENT P.K.NAIL
 ON SURFACE - ~~BELOW~~ ON _____
 OFFSET \odot PAVEMENT - _____ LT : RT
 - _____ TO - _____ EDGE PAVEMENT
 STATION: 76+33.57

HORZ.DATUM: NAD 1983 GEOID: 2003
 GRID: NORTHING: 725224.759 EASTING: 1884020.802



RECORD: P.I.
 STA 75+45.84
 $\Delta = 68^{\circ}16' LT$
 7/24/61
 FD P.K.NAIL
 RSV133
 9/20/07, RGN
 FD P.K.NAIL
 RSV133
 11/18/09
 SET MAG/WASHER
 11/25/12, DCH

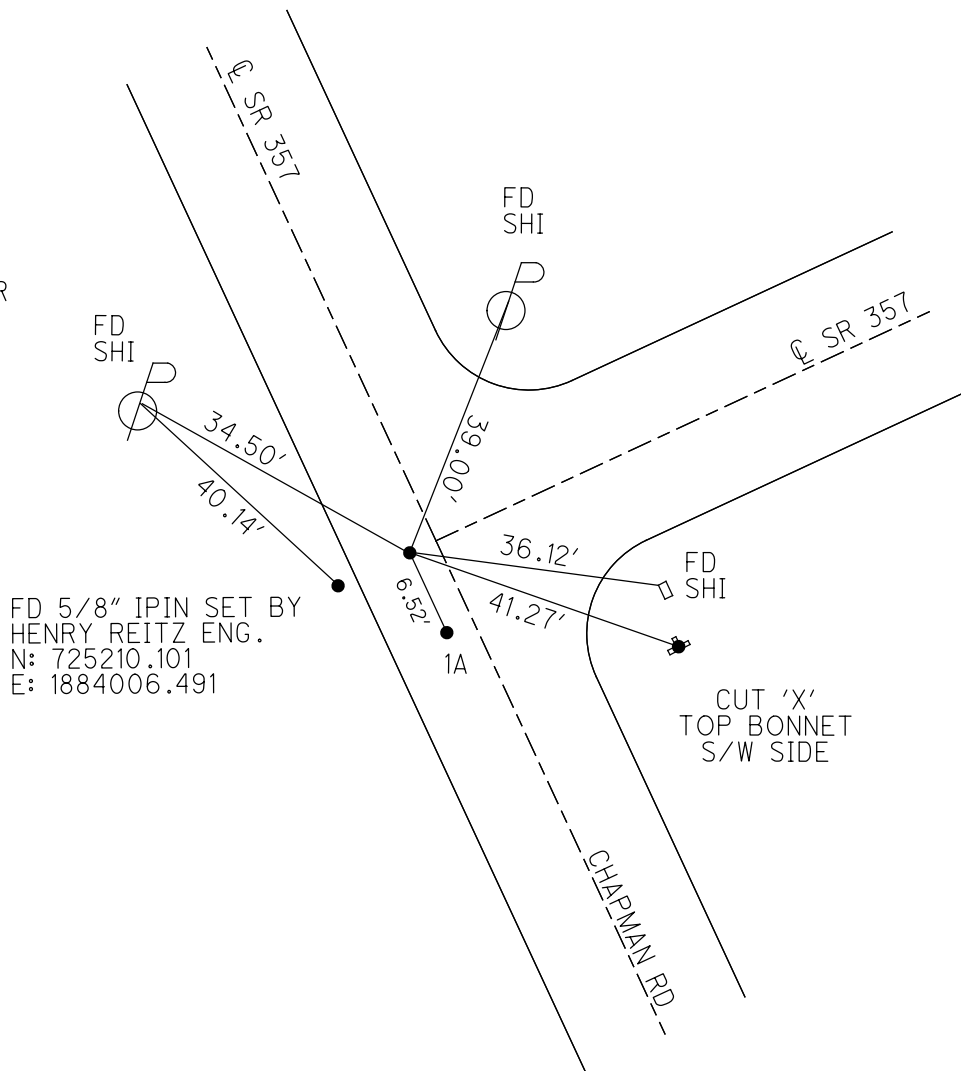

FD 5/8" IPIN SET BY
 HENRY REITZ ENG.
 N: 725210.101
 E: 1884006.491

CUT 'X'
 TOP BONNET
 S/W SIDE

O.D.O.T. DISTRICT 2 SURVEY OFFICE

PERSONNEL _____ REFERENCE NO. _____ SHEET _____ OF _____

NOTES Huss

H.C. R van DATE 9-20-07 ROUTE 357

R.C. Huss WEATHER Clean-Fair COUNTY OTT

TEMP. 78.1°F TOWNSHIP _____

SECTION _____

T _____ R _____

TYPE MONUMENT A = PK B = IPipe

ON SURFACE - BELOW A surf, B 0.3 below

LEFT - C PAV'T. - RIGHT _____

A - 9.0' TO RT. EDGE PAVEMENT

S.L.M. _____ B

