

O.D.O.T. DISTRICT 2 SURVEY OFFICE (USE ONLY)

PERSONNEL \_\_\_\_\_ REFERENCE NO. 1 A SHEET 2 OF 27  
NOTES HOMAN DATE 11/25/12 ROUTE SR 357  
H.C. HOMAN WEATHER PTLY CLOUDY COUNTY OTTAWA  
R.C. ROUSOS TEMP. 53° SOUTH BASS  
ISLAND

DWG BY RHOADES PID 25525

TYPE MONUMENT P.K.NAIL

~~ON SURFACE~~ - BELOW 0.3'

OFFSET  $\odot$  PAVEMENT - LT : RT

- TO - EDGE PAVEMENT


STATION: 76+33.57

HORIZ.DATUM: NAD 1983 GEOID: 2003

GRID: NORTHING: 725220.339 EASTING: 1884025.199



RECORD:  
FD IPIPE  
0.3' DOWN  
RSV139  
9/20/07, RGN  
POINT RECOVERED  
RSV139  
9/25/12, DCH

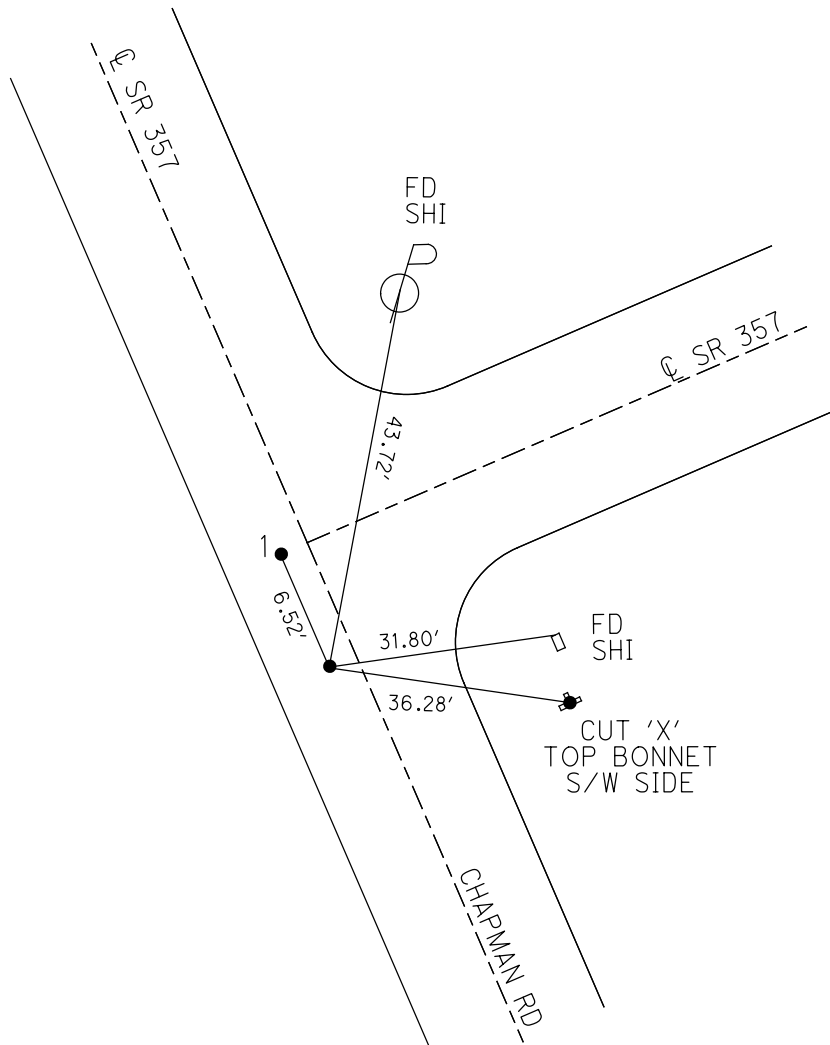

# O.D.O.T. DISTRICT 2 SURVEY OFFICE

PERSONNEL \_\_\_\_\_ REFERENCE NO. \_\_\_\_\_ SHEET \_\_\_\_\_ OF \_\_\_\_\_

NOTES Huss

H.C. R van DATE 9-20-07 ROUTE 357

R.C. Huss WEATHER Clean-Fair COUNTY OTT

TEMP. 81°F TOWNSHIP \_\_\_\_\_

SECTION \_\_\_\_\_

T \_\_\_\_\_ R \_\_\_\_\_


TYPE MONUMENT A = PK B = IPipe

ON SURFACE - BELOW A surf, B 0.3 below

LEFT - C PAV'T. - RIGHT \_\_\_\_\_

A - 9.0' TO RT. EDGE PAVEMENT

S.L.M. \_\_\_\_\_ B

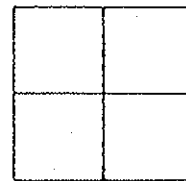

B = E of Survey

A - B - 6.52'

A = RSV 133

B = RSV 139

