

O.D.O.T. DISTRICT 2 SURVEY OFFICE (USE ONLY)

PERSONNEL _____ REFERENCE NO. 3 SHEET 4 OF 27
NOTES HOMAN DATE 11/25/12 ROUTE SR 357
H.C. HOMAN WEATHER PTLY CLOUDY COUNTY OTTAWA
R.C. ROUSOS TEMP. 53° SOUTH BASS
ISLAND

DWG BY RHOADES PID 25525

TYPE MONUMENT P.K.NAIL

ON SURFACE - ~~BELOW~~ ON _____

OFFSET ☉ PAVEMENT 4.0' ~~±~~ : RT

5.52' TO RT EDGE PAVEMENT


STATION: 79+36.90

HORZ.DATUM: NAD 1983 GEOID: 2003

GRID: NORTHING: 725339.428 EASTING: 1884283.794



RECORD:
FD P.K.NAIL
RSV141
9/20/07, RGN
POINT RECOVERED
RSV141
9/25/12
SET MAG/WASHER
11/25/12, DCH

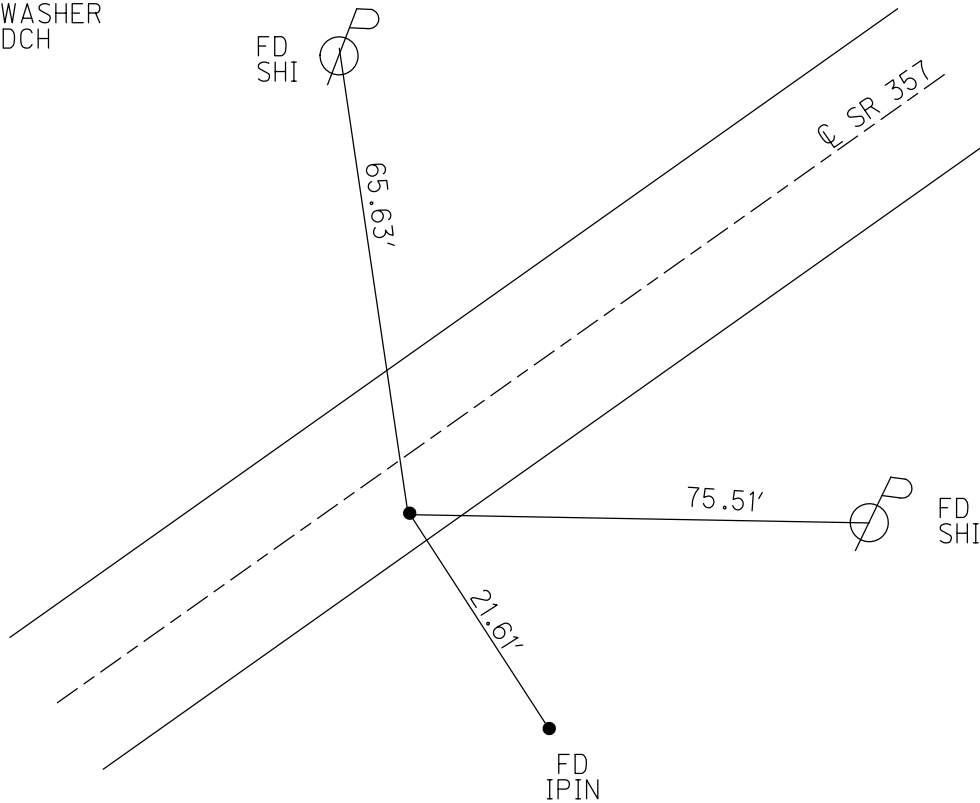

O.D.O.T. DISTRICT 2 SURVEY OFFICE

PERSONNEL _____

REFERENCE NO. _____

SHEET _____ OF _____

NOTES Huss

H.C. Ryan

R.C. Huss

DATE 9-20-07

WEATHER _____

TEMP. _____

ROUTE 757

COUNTY OH.

TOWNSHIP _____

SECTION _____

T. _____ R. _____


TYPE MONUMENT PK

ON SURFACE - BELOW Surf

LEFT - <math>E</math> PAV'T. - RIGHT 4.0' R.

5.52 TO RT. EDGE PAVEMENT

S.L.M. _____

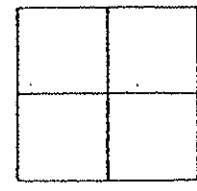

RSU-141

