

O.D.O.T. DISTRICT 2 SURVEY OFFICE (USE ONLY)

PERSONNEL \_\_\_\_\_ REFERENCE NO. 4 SHEET 5 OF 27  
NOTES HOMAN DATE 11/25/12 ROUTE SR 357  
H.C. HOMAN WEATHER PTLY CLOUDY COUNTY OTTAWA  
R.C. ROUSOS TEMP. 53° SOUTH BASS  
ISLAND


DWG BY RHOADES PID 25525

TYPE MONUMENT P.K.NAIL  
ON SURFACE - ~~BELOW~~ ON \_\_\_\_\_  
OFFSET  $\odot$  PAVEMENT 1.8' ~~LT~~ : RT  
7.6' TO RT EDGE PAVEMENT  
STATION: 82+69.16

HORZ.DATUM: NAD 1983 GEOID: 2003  
GRID: NORTHING: 725767.631 EASTING: 1885213.168



RECORD:  
FD P.K.NAIL  
RSV135  
9/20/07, RGN  
POINT RECOVERED  
RSV135  
9/25/12  
SET MAG/WASHER  
11/25/12, DCH

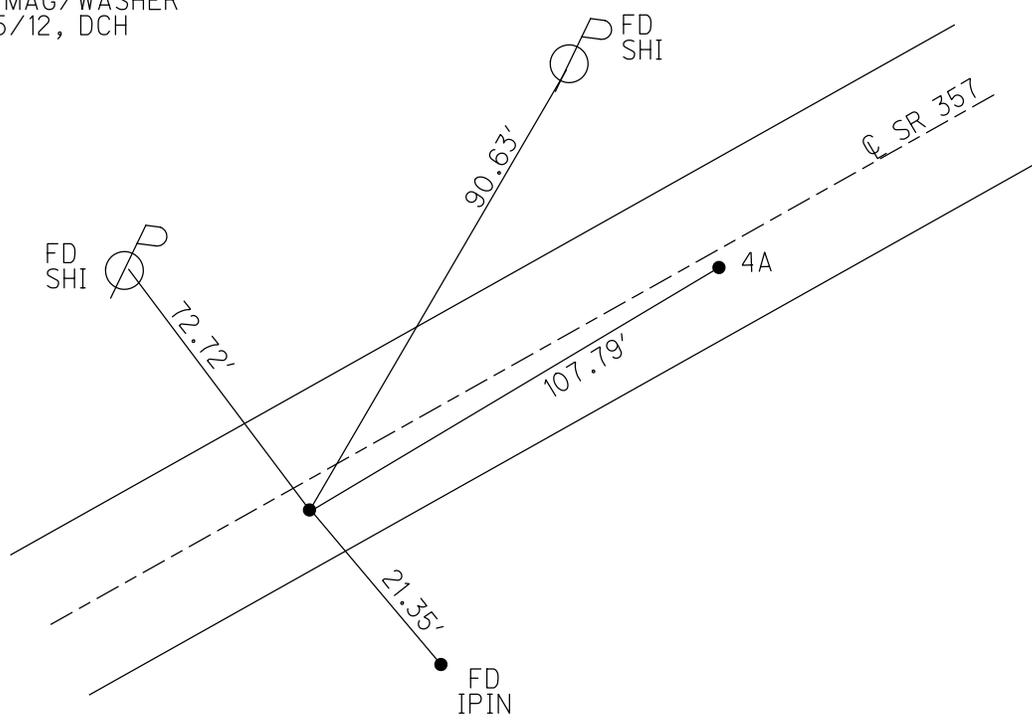

# O.D.O.T. DISTRICT 2 SURVEY OFFICE

PERSONNEL \_\_\_\_\_ REFERENCE NO. \_\_\_\_\_ SHEET \_\_\_\_\_ OF \_\_\_\_\_

NOTES Huss

H.C. Ryan DATE 9-20-07 ROUTE 357

R.C. Huss WEATHER \_\_\_\_\_ COUNTY OH

TEMP. \_\_\_\_\_ TOWNSHIP \_\_\_\_\_

SECTION \_\_\_\_\_

T. \_\_\_\_\_ R. \_\_\_\_\_

TYPE MONUMENT PK

ON SURFACE - BELOW Surf

LEFT - PAV'T. - RIGHT (A) 1.8' Rt. (B) 0.85' Rt

A 7.6 TO RT EDGE PAVEMENT B 8.0' to RT EDP

S.L.M. \_\_\_\_\_

