

O.D.O.T. DISTRICT 2 SURVEY OFFICE (USE ONLY)

PERSONNEL \_\_\_\_\_ REFERENCE NO. 4 A SHEET 6 OF 27  
 NOTES HOMAN DATE 11/25/12 ROUTE SR 357  
 H.C. HOMAN WEATHER PTLY CLOUDY COUNTY OTTAWA  
 R.C. ROUSOS TEMP. 53° SOUTH BASS ISLAND

DWG BY RHOADES PID 25525

TYPE MONUMENT P.K.NAIL

ON SURFACE - ~~BELOW~~ ON \_\_\_\_\_

OFFSET 0.85' ~~±~~ : RT

8.0' TO RT EDGE PAVEMENT


STATION: 83+76.95

HORZ.DATUM: NAD 1983 GEOID: 2003

GRID: NORTHING: 725523.95 EASTING: 1884683.183



RECORD:  
 FD P.K.NAIL  
 RSV142  
 9/20/07, RGN  
 POINT RECOVERED  
 RSV142  
 9/25/12  
 SET MAG/WASHER  
 11/25/12, DCH

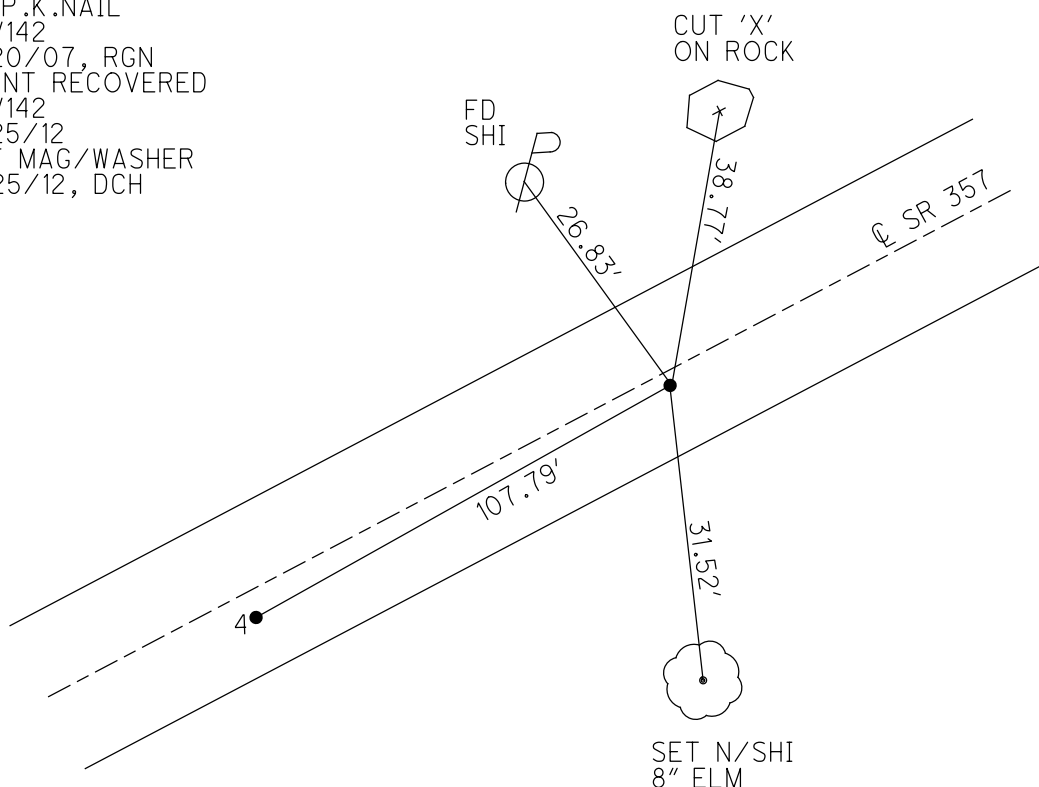

# O.D.O.T. DISTRICT 2 SURVEY OFFICE

PERSONNEL \_\_\_\_\_ REFERENCE NO. \_\_\_\_\_ SHEET \_\_\_\_\_ OF \_\_\_\_\_

NOTES Huss

H.C. Ryan DATE 9-20-07 ROUTE 357

R.C. Huss WEATHER \_\_\_\_\_ COUNTY OH

TEMP. \_\_\_\_\_ TOWNSHIP \_\_\_\_\_

SECTION \_\_\_\_\_

T. \_\_\_\_\_ R. \_\_\_\_\_

TYPE MONUMENT PK

ON SURFACE - BELOW Surf

LEFT - PAV'T. - RIGHT (A) 1.8' Rt. (B) 0.85' Rt

A 7.6 TO RT EDGE PAVEMENT B 8.0' to RT EDP

S.L.M. \_\_\_\_\_

