

O.D.O.T. DISTRICT 2 SURVEY OFFICE (USE ONLY)

PERSONNEL

REFERENCE NO. 6 A

SHEET 10 OF 27

NOTES HOMAN

DATE 11/25/12

ROUTE SR 357

H.C. HOMAN

WEATHER PTLY CLOUDY

COUNTY OTTAWA

R.C. ROUSOS

TEMP. 53°

SOUTH BASS
ISLAND

DWG BY RHOADES PID 25525

TYPE MONUMENT P.K.NAIL

ON SURFACE - ~~BELOW~~ ON _____

OFFSET \varnothing PAVEMENT 1.6' \pm : RT

8.5' TO RT EDGE PAVEMENT

STATION: 88+33.96

HORZ.DATUM: NAD 1983


GEOID: 2003

GRID: NORTHING: 725714.756

EASTING: 1885098.264



RECORD: P.I.
FD P.K.NAIL
RSV146
9/20/07, RGN
POINT RECOVERED
RSV146
9/25/12
SET MAG/WASHER
11/25/12, DCH

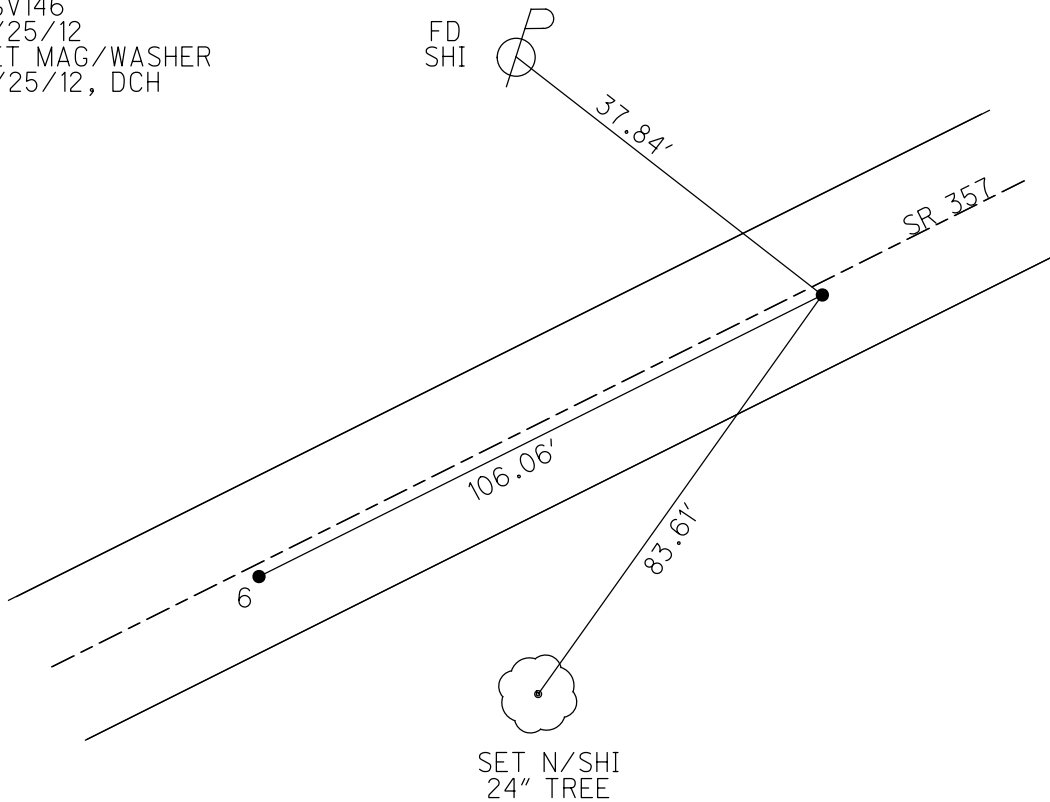

O.D.O.T. DISTRICT 2 SURVEY OFFICE

PERSONNEL

REFERENCE NO. _____

SHEET _____ OF _____

NOTES Huss

H.C. Ryan

R.C. Huss

DATE 9-20-07

WEATHER _____

TEMP. _____

ROUTE 357

COUNTY OH

TOWNSHIP _____

SECTION _____

T _____ R _____

A- PK

B- PK

TYPE MONUMENT _____

ON SURFACE - BELOW Surf

LEFT - PAV'T. - RIGHT A - 1.0 RT

B - 3.5 TO RT EDGE PAVEMENT

S.L.M. _____

