

O.D.O.T. DISTRICT 2 SURVEY OFFICE (USE ONLY)

PERSONNEL \_\_\_\_\_ REFERENCE NO. 7 SHEET 11 OF 27  
 NOTES HOMAN DATE 9/25/12 ROUTE SR 357  
 H.C. HOMAN WEATHER PTLY CLOUDY COUNTY OTTAWA  
 R.C. ROUSOS TEMP. 53° SOUTH BASS ISLAND

DWG BY RHOADES PID 25525

TYPE MONUMENT LG.R.R.SPIKE

~~ON SURFACE~~ - BELOW 0.65'


OFFSET  $\odot$  PAVEMENT 9.0'  $\pm$  : RT

0.7' TO RT EDGE PAVEMENT


STATION: 90+56.13

HORZ.DATUM: NAD 1983 GEOID: 2003

GRID: NORTHING: 725767.631 EASTING: 1885213.168

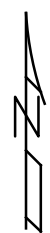

RECORD: P.I.  
 STA. 88+51  
 $\Delta=23^\circ 32'$   
 7/24/61  
 FD LG.R.R.SPIKE  
 0.65' DOWN  
 RSV101  
 9/18/07, RGN  
 POINT RECOVERED  
 RSV101  
 9/25/12  
 SET MAG/WASHER  
 11/25/12, DCH

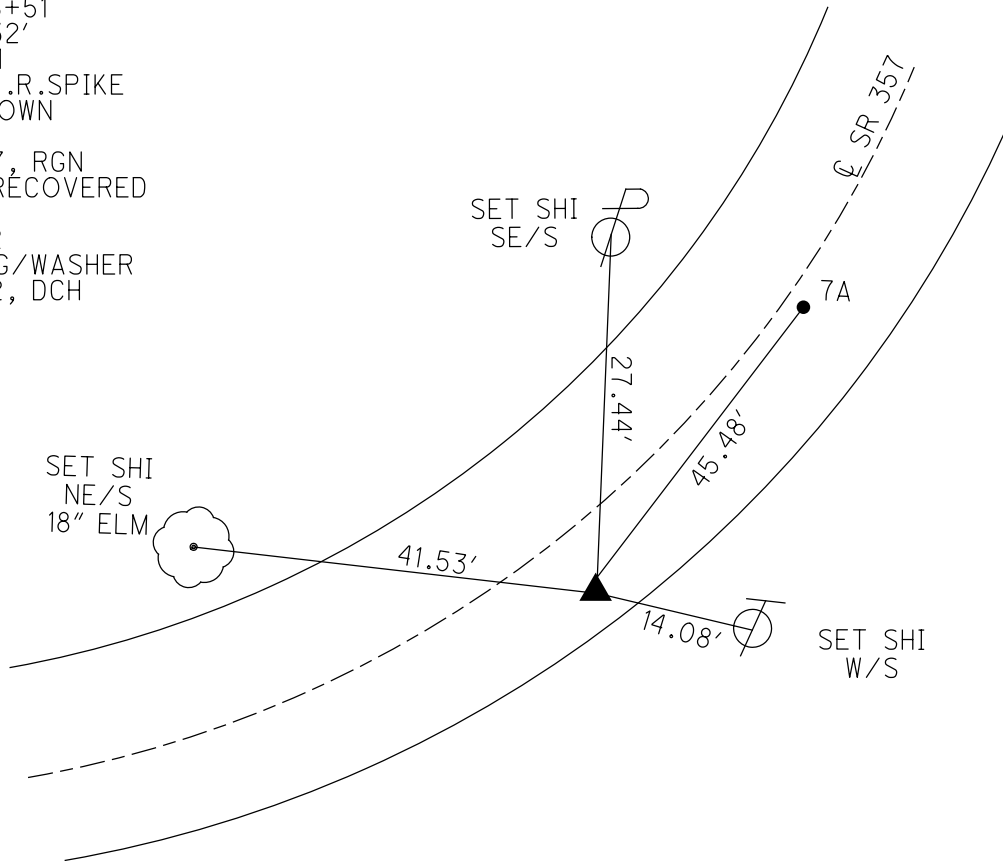

# O.D.O.T. DISTRICT 2 SURVEY OFFICE

PERSONNEL \_\_\_\_\_

REFERENCE NO. \_\_\_\_\_

SHEET \_\_\_\_\_ OF \_\_\_\_\_

NOTES CANTERBURY

H.C. HUSS

R.C. NUHFER

DATE 9/18/07

WEATHER SUN

TEMP. +80°

ROUTE 357

COUNTY OH

TOWNSHIP \_\_\_\_\_

SECTION \_\_\_\_\_

T. \_\_\_\_\_ R. \_\_\_\_\_

TYPE MONUMENT <sup>ⓑ</sup> Mag. Ⓐ L.G. R.R. SPK

ON SURFACE - BELOW 0.65" DOWN

~~LEFT-C PAV'T.~~ - RIGHT A 9.0' RT E <sup>ⓑ</sup> 2.0 RT.

<sup>Ⓐ</sup> 0.7 TO RT EDGE PAVEMENT <sup>ⓑ</sup> 7.7 + RT EOP

S.L.M. \_\_\_\_\_

