

O.D.O.T. DISTRICT 2 SURVEY OFFICE (USE ONLY)

PERSONNEL _____ REFERENCE NO. 7 A SHEET 12 OF 27
 NOTES HOMAN DATE 11/25/12 ROUTE SR 357
 H.C. HOMAN WEATHER PTLY CLOUDY COUNTY OTTAWA
 R.C. ROUSOS TEMP. 53° SOUTH BASS ISLAND

DWG BY RHOADES PID 25525

TYPE MONUMENT MAG NAIL

~~ON SURFACE~~ - BELOW 0.65

OFFSET \odot PAVEMENT 2.0' ~~LT~~ : RT

7.7' TO RT EDGE PAVEMENT


STATION: 91+01.61

HORIZ.DATUM: NAD 1983 GEOID: 2003

GRID: NORTHING: 725801.611 EASTING: 1885243.580



RECORD:
 FD MAG NAIL
 0.65' DOWN
 RSV102
 9/20/07, RGN
 POINT RECOVERED
 RSV102
 9/25/12
 SET MAG/WASHER
 11/25/12, DCH

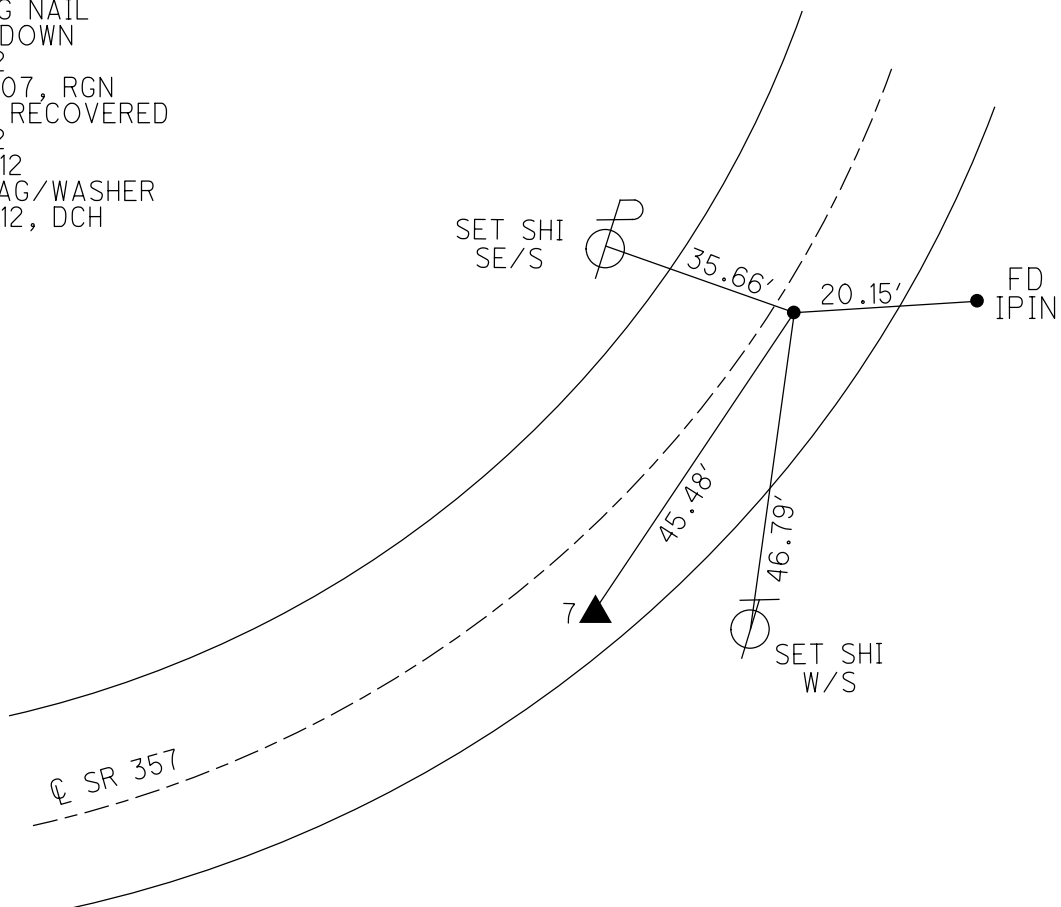

O.D.O.T. DISTRICT 2 SURVEY OFFICE

PERSONNEL _____

REFERENCE NO. _____

SHEET _____ OF _____

NOTES CANTERBURY

H.C. HUSS

R.C. NUHFER

DATE 9/18/07

WEATHER SUN

TEMP. +80°

ROUTE 357

COUNTY OH

TOWNSHIP _____

SECTION _____

T. _____ R. _____

TYPE MONUMENT [ⓑ] Mag. Ⓐ L.G. R.R. SPK

ON SURFACE - BELOW 0.65" DOWN

~~LEFT-C PAV'T.~~ - RIGHT A 9.0' RT E [ⓑ] 2.0 RT.

[Ⓐ] 0.7 TO RT EDGE PAVEMENT [ⓑ] 7.7 + RT EOP

S.L.M. _____

