

O.D.O.T. DISTRICT 2 SURVEY OFFICE (USE ONLY)


PERSONNEL _____ REFERENCE NO. 8 SHEET 13 OF 27
 NOTES HOMAN DATE 11/25/12 ROUTE SR 357
 H.C. HOMAN WEATHER PTLY CLOUDY COUNTY OTTAWA
 R.C. ROUSOS TEMP. 53° SOUTH BASS ISLAND
 DWG BY RHOADES PID 25525

TYPE MONUMENT P.K.NAIL
 ON SURFACE - ~~BELOW~~ ON _____
 OFFSET \varnothing PAVEMENT 0.6' ~~LT~~ : RT
8.2' TO RT EDGE PAVEMENT
 STATION: 97+34.57

HORZ.DATUM: NAD 1983 GEOID: 2003
 GRID: NORTHING: 726346.852 EASTING: 1885731.1612



RECORD: P.I.
 FD P.K.NAIL
 RSV1374
 9/20/07, RGN
 POINT RECOVERED
 RSV1374
 9/25/12
 SET MAG/WASHER
 11/25/12, DCH

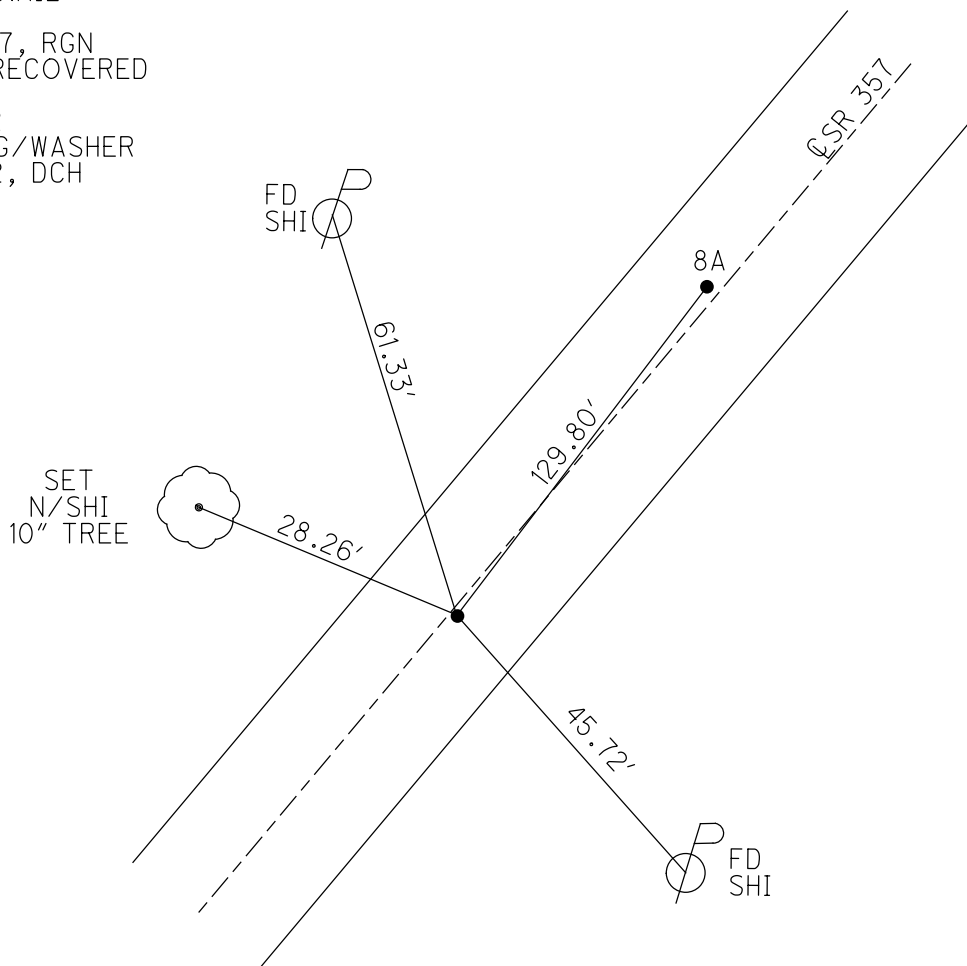

O.D.O.T. DISTRICT 2 SURVEY OFFICE

PERSONNEL

REFERENCE NO. _____

SHEET _____ OF _____

NOTES Huss

H.C. Ryan

R.C. Huss

DATE 9-20-07

WEATHER Pt Cldy - Fair

TEMP. _____

ROUTE 357

COUNTY OH

TOWNSHIP _____

SECTION _____

T _____ R _____


TYPE MONUMENT A - PK
B - ~~Mag~~ Mag C - ~~Mag~~ Mag

ON SURFACE - BELOW Surf

LEFT - & PAV'T. - RIGHT A = 0.6' Rt. B = 0.7' Lt. C = 1.2' Lt.

A = 8.2 TO Rt EDGE PAVEMENT B = 9.3' Rt. C = 9.5 Rt.

S.L.M. _____

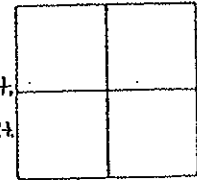


A R SU 1374

B R SU 103

C R SU 104

C-A-3103
and Not Shown

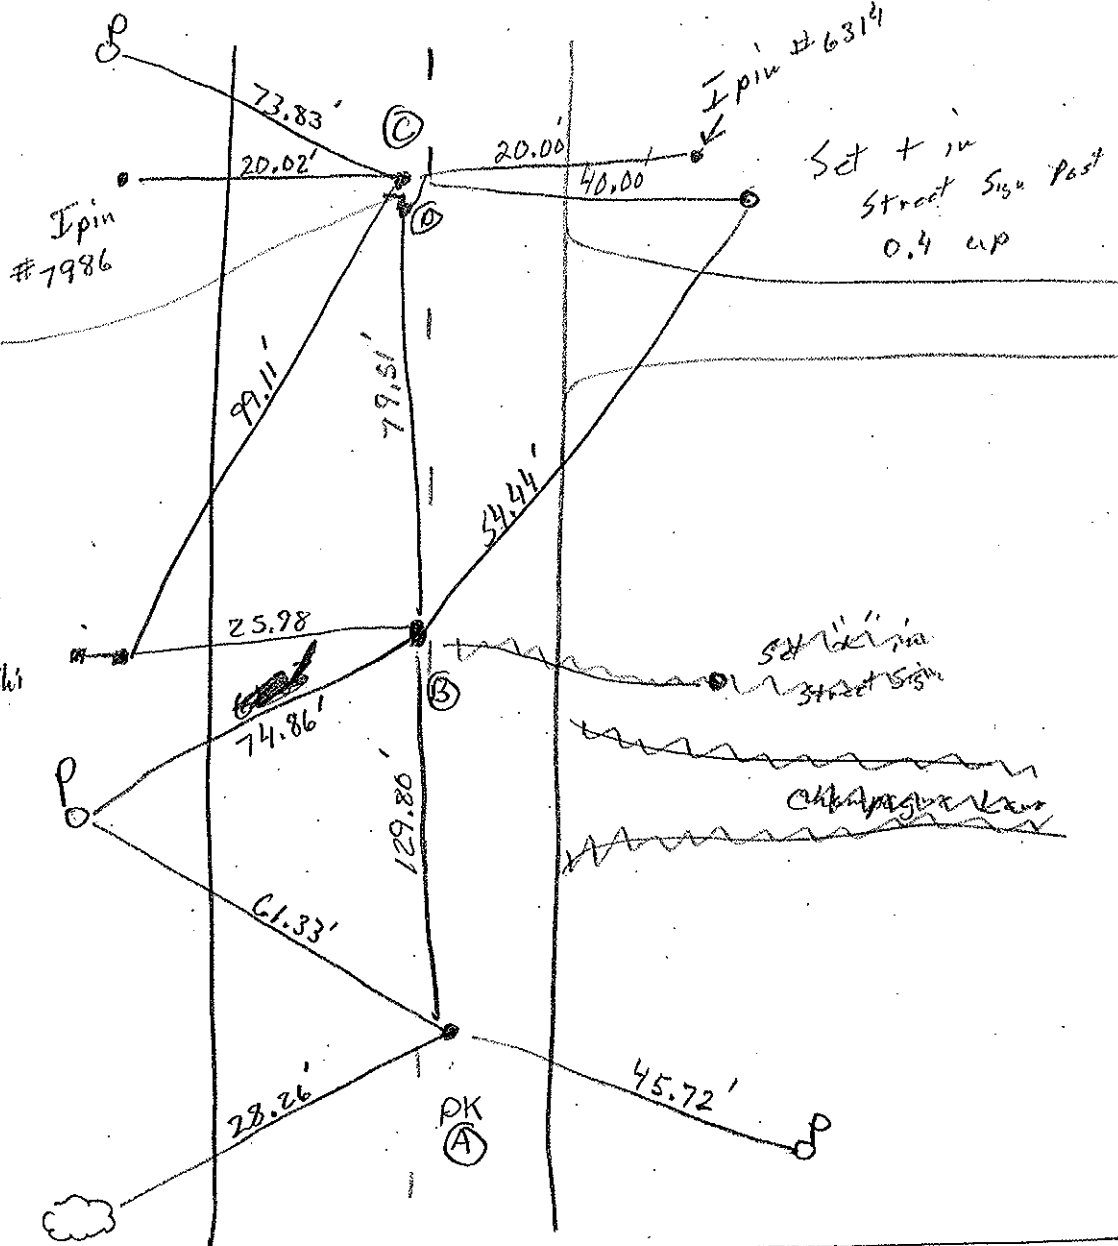

Put-In-Road
Cabins
Set N/S

Set in
Street Sign

Set in
10' tree