

O.D.O.T. DISTRICT 2 SURVEY OFFICE (USE ONLY)

PERSONNEL \_\_\_\_\_ REFERENCE NO. 8 A SHEET 14 OF 27  
 NOTES HOMAN DATE 11/25/12 ROUTE SR 357  
 H.C. HOMAN WEATHER PTLY CLOUDY COUNTY OTTAWA  
 R.C. ROUSOS TEMP. 53° SOUTH BASS  
 \_\_\_\_\_ ISLAND

DWG BY RHOADES PID 25525

TYPE MONUMENT MAG NAIL

ON SURFACE - ~~BELOW~~ ON \_\_\_\_\_

OFFSET  $\varnothing$  PAVEMENT 0.7' LT : ~~RT~~

9.3' TO RT EDGE PAVEMENT


STATION: 98+64.37

HORZ.DATUM: NAD 1983 GEOID: 2003

GRID: NORTHING: 726443.813 EASTING: 1885817.572



RECORD:  
 FD MAG NAIL  
 RSV103  
 9/20/07, RGN  
 POINT RECOVERED  
 RSV103  
 9/25/12  
 SET MAG/WASHER  
 11/25/12, DCH

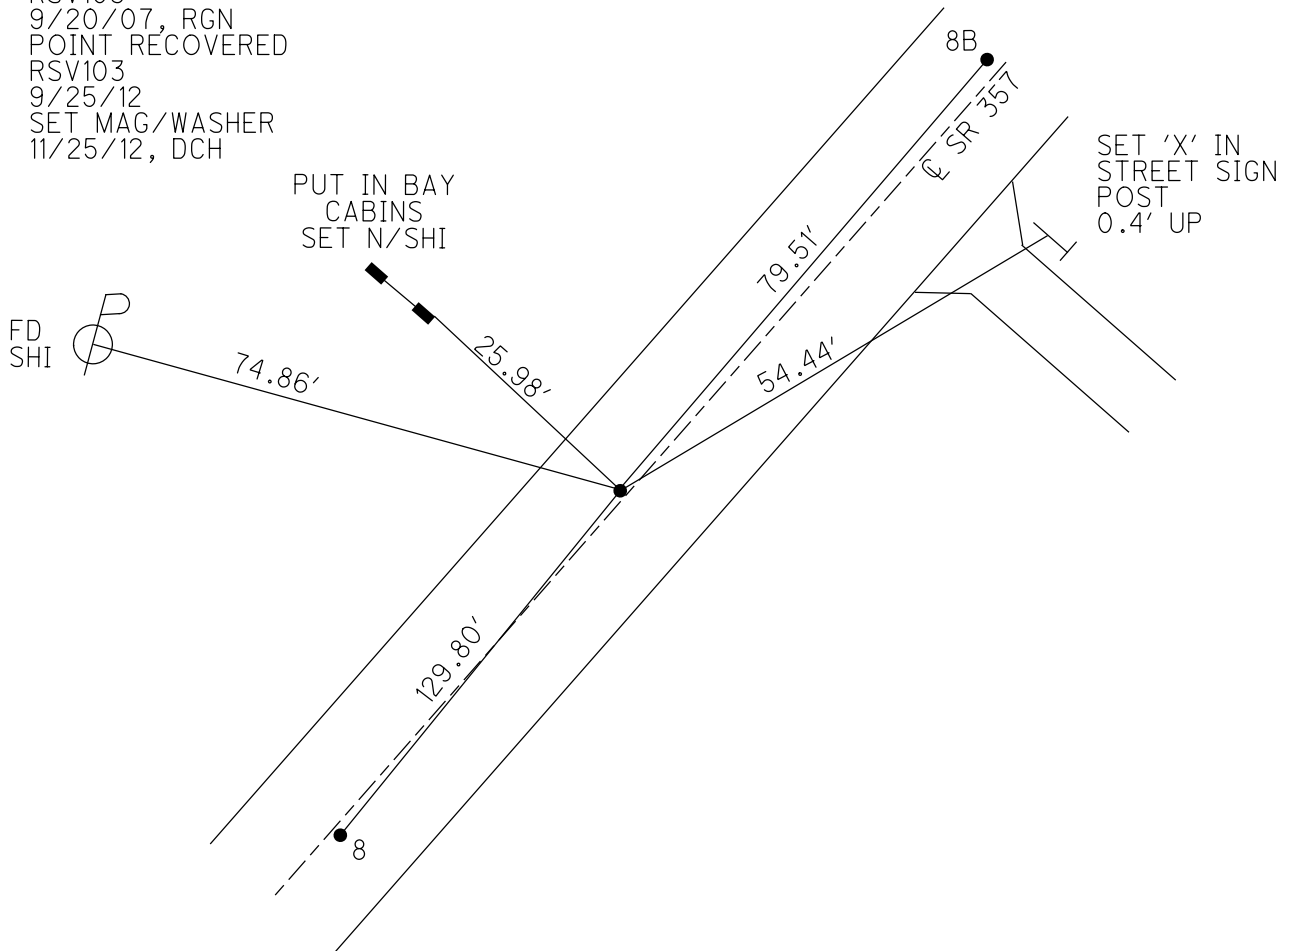

# O.D.O.T. DISTRICT 2 SURVEY OFFICE

PERSONNEL

REFERENCE NO. \_\_\_\_\_

SHEET \_\_\_\_\_ OF \_\_\_\_\_

NOTES Huss

H.C. Ryan

R.C. Huss

DATE 9-20-07

WEATHER Pt Cldy - Fair

TEMP. \_\_\_\_\_

ROUTE 357

COUNTY OH

TOWNSHIP \_\_\_\_\_

SECTION \_\_\_\_\_

T \_\_\_\_\_ R \_\_\_\_\_


TYPE MONUMENT A - PK  
B - ~~Mag~~ Mag C - ~~Mag~~ Mag

ON SURFACE - BELOW Surf

LEFT - & PAV'T. - RIGHT A = 0.6' Rt. B = 0.7' Lt. C = 1.2' Lt.

A = 8.2 TO Rt EDGE PAVEMENT B = 9.3' Rt. C = 9.5 Rt.

S.L.M. \_\_\_\_\_

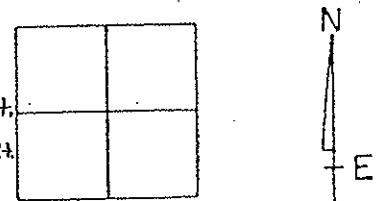


A R SU 1374

B R SU 103

C R SU 104

C-A-3.03'  
and Not Shoot

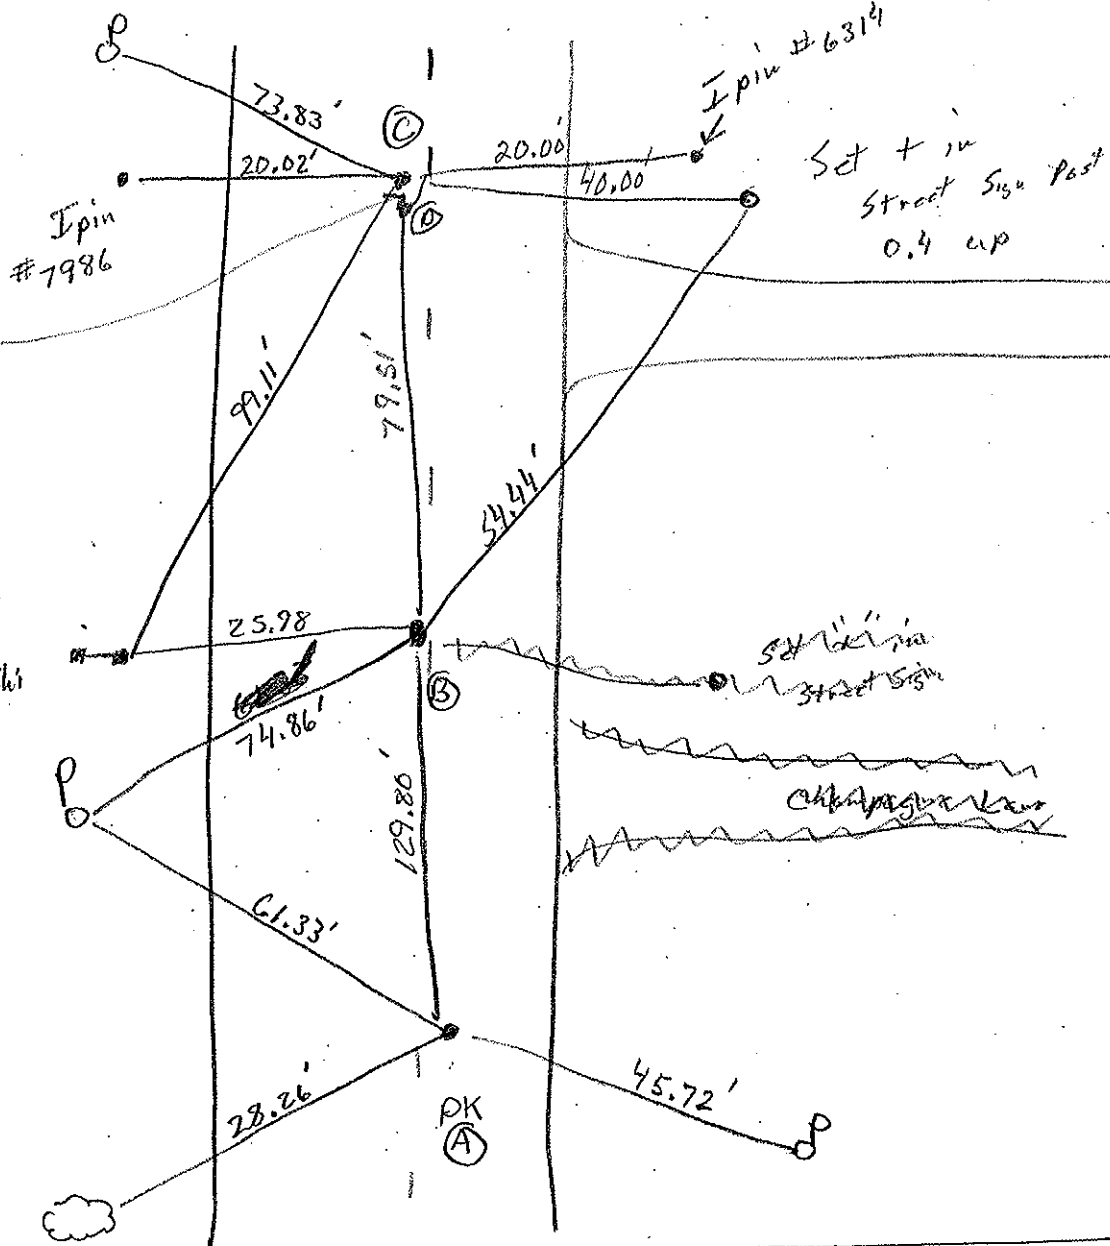

Put-In-Box  
Cabins  
Set N/S/E

Set + in  
Street Sign Post  
0.4 up

Set in  
Street Sign

Set  
N/S/E  
10" tree