

O.D.O.T. DISTRICT 2 SURVEY OFFICE (USE ONLY)

PERSONNEL _____ REFERENCE NO. 9 SHEET 16 OF 27
 NOTES HOMAN DATE 11/25/12 ROUTE SR 357
 H.C. HOMAN WEATHER PTLY CLOUDY COUNTY OTTAWA
 R.C. ROUSOS TEMP. 53° SOUTH BASS ISLAND


DWG BY RHOADES PID 25525

TYPE MONUMENT P.K.NAIL
 ON SURFACE - ~~BELOW~~ ON _____
 OFFSET Q PAVEMENT ON LT : RT
8.4' TO RT EDGE PAVEMENT
 STATION: 106+14.12

HORIZ.DATUM: NAD 1983 GEOID: 2003
727002.681 1886317.247
 GRID: NORTHING: _____ EASTING: _____



RECORD:
 FD P.K.NAIL
 RSV105
 9/20/07, RGN
 POINT RECOVERED
 RSV105
 9/25/12
 SET MAG/WASHER
 11/25/12, DCH

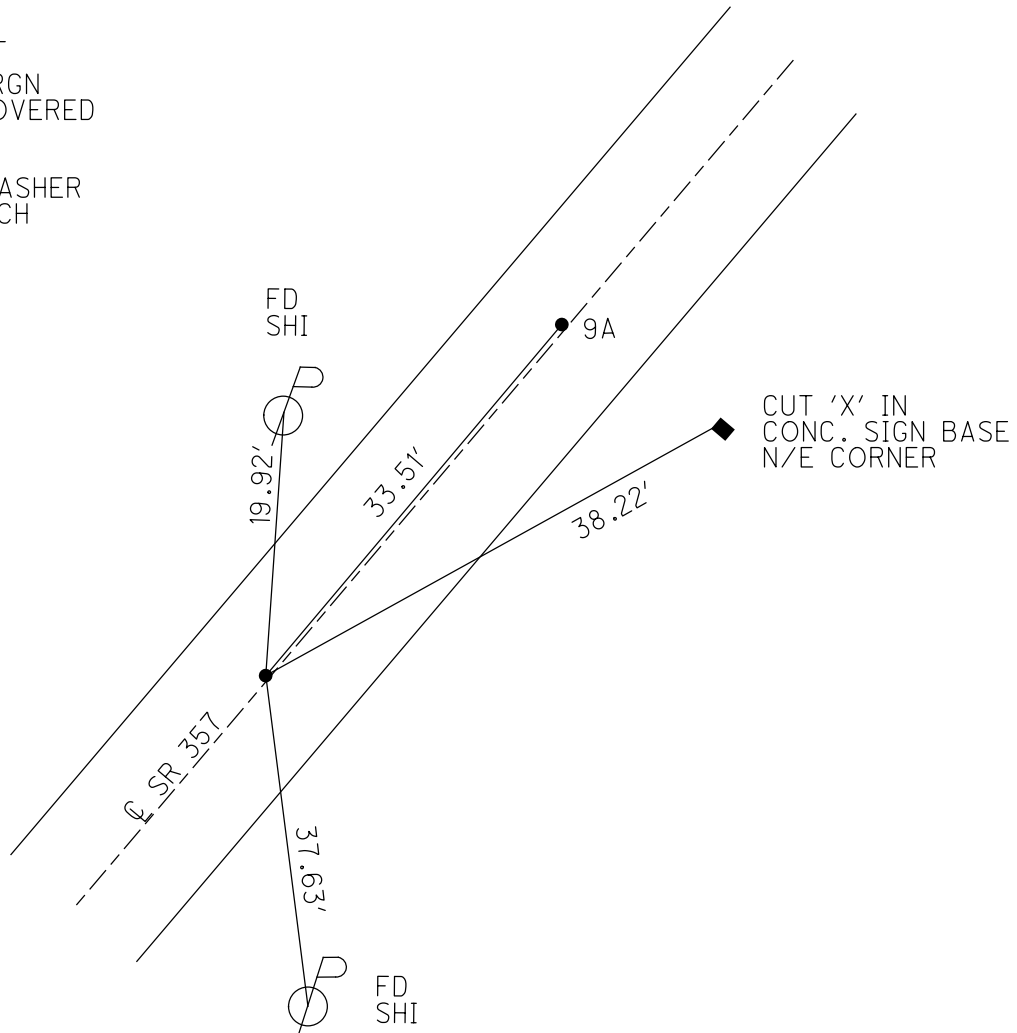

O.D.O.T. DISTRICT 2 SURVEY OFFICE

PERSONNEL _____

REFERENCE NO. _____

SHEET _____ OF _____

NOTES Huss

H.C. Ryan

R.C. Huss

DATE 9-20-07

WEATHER Clear-Fair

TEMP. +82°F

ROUTE 357

COUNTY OH

TOWNSHIP _____

SECTION _____

T _____ R _____

TYPE MONUMENT A = PK

B = PK

ON SURFACE - BELOW A = Surf.

B = 0.1 below



LEFT - ☉ PAV'T. - RIGHT A = on ☉

B = 0.4 Lt.

A = 8.4' TO R. EDGE PAVEMENT

B = 8.4' - Rt.

S.L.M. _____

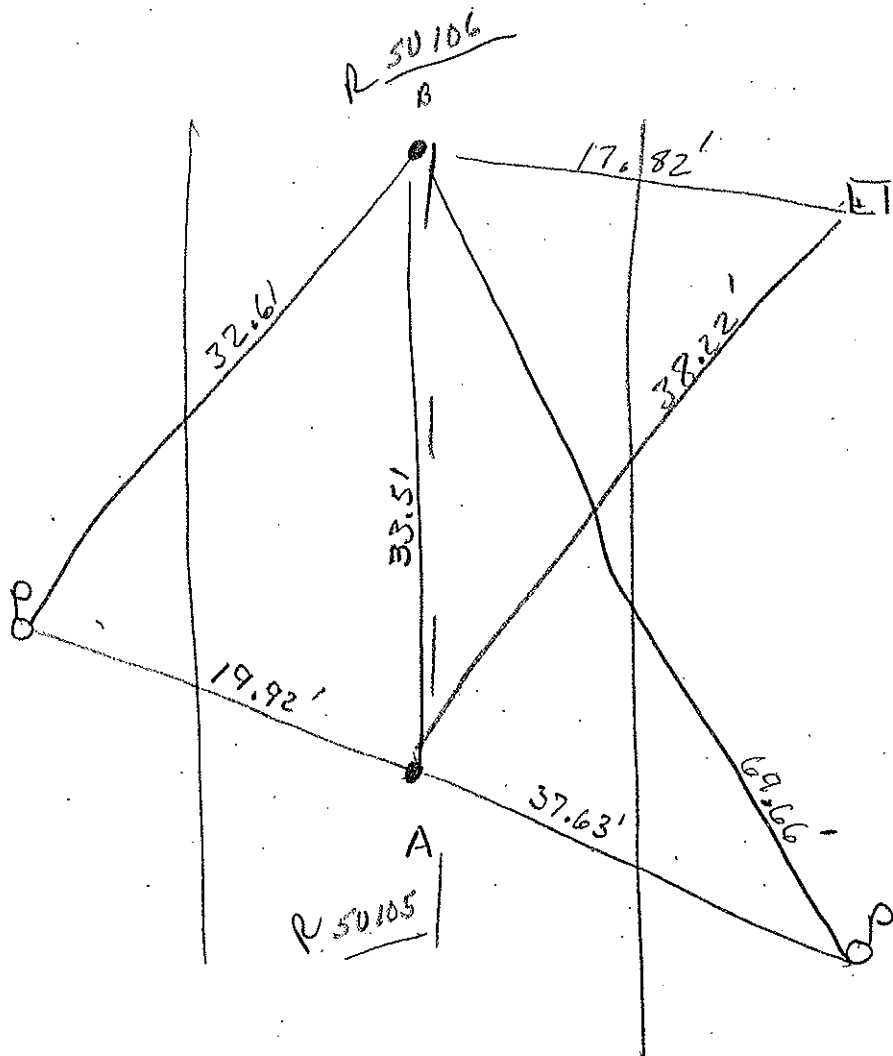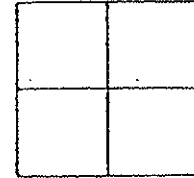

Cut "X" in
conc. sign
base
N/E Corner