

O.D.O.T. DISTRICT 2 SURVEY OFFICE (USE ONLY)

PERSONNEL

REFERENCE NO. 9 A

SHEET 17 OF 27

NOTES HOMAN
 H.C. HOMAN
 R.C. ROUSOS

DATE 11/25/12
 WEATHER PTLY CLOUDY
 TEMP. 53°

ROUTE SR 357
 COUNTY OTTAWA
SOUTH BASS
ISLAND

DWG BY RHOADES PID 25525

TYPE MONUMENT P.K.NAIL

~~ON SURFACE~~ - BELOW 0.1'

OFFSET 0.4' C PAVEMENT LT : ~~RT~~

8.4' TO RT EDGE PAVEMENT


STATION: 106+47.58

HORZ.DATUM: NAD 1983


GEOID: 2003

GRID: NORTHING: 727027.769

EASTING: 1886339.383

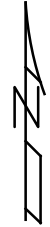

RECORD:
 FD P.K.NAIL
 RSV106
 9/20/07, RGN
 POINT RECOVERED
 RSV106
 9/25/12
 SET MAG/WASHER
 11/25/12, DCH

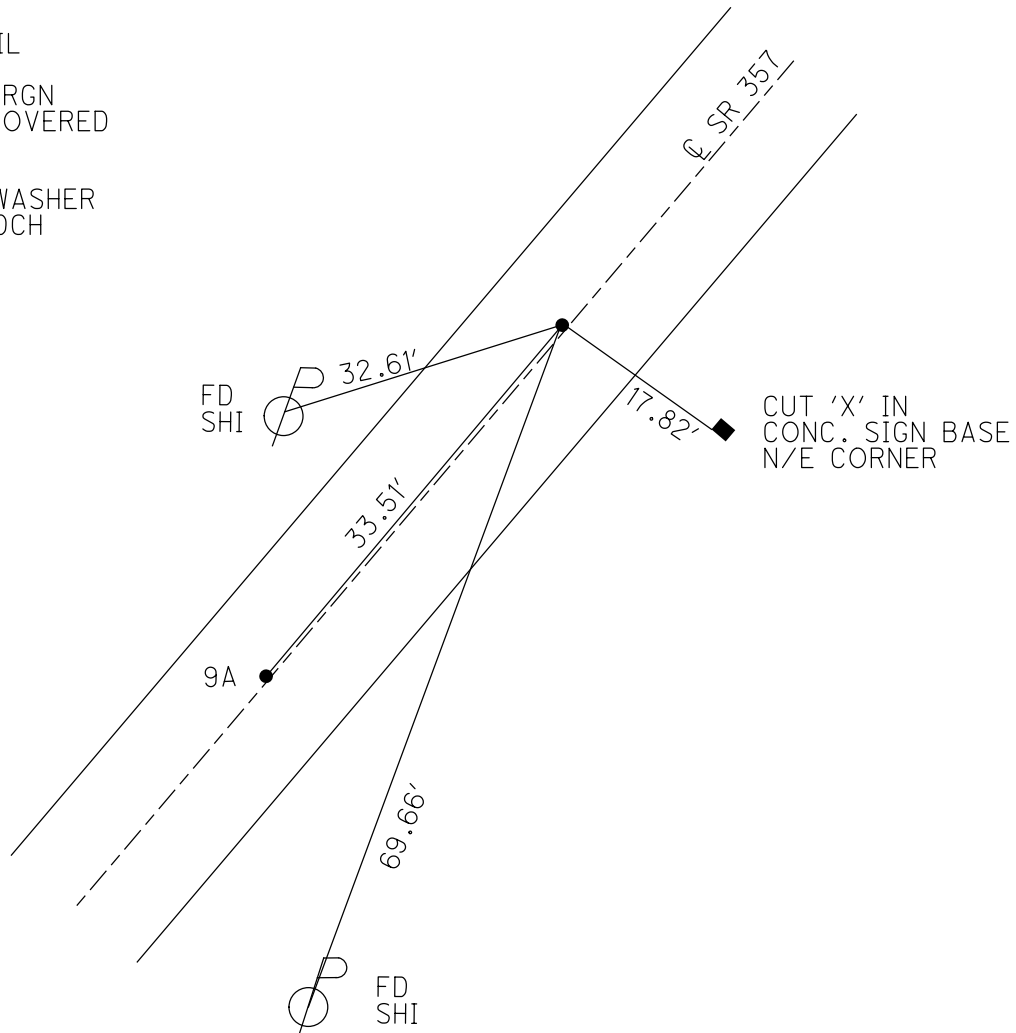

O.D.O.T. DISTRICT 2 SURVEY OFFICE

PERSONNEL _____ REFERENCE NO. _____ SHEET _____ OF _____

NOTES Huss

H.C. Ryan DATE 9-20-07 ROUTE 357

R.C. Huss WEATHER Clear-Fair COUNTY OH

TEMP. +82°F TOWNSHIP _____

SECTION _____

T _____ R _____

TYPE MONUMENT A = PK B = PK

ON SURFACE - BELOW A = Surf. B = 0.1 below

LEFT - \odot PAV'T. - RIGHT A = on \odot B = 0.4 Lt.

A = 8.4' TO R. EDGE PAVEMENT B = 8.4' - Rt.

S.L.M. _____

