

O.D.O.T. DISTRICT 2 SURVEY OFFICE (USE ONLY)

PERSONNEL _____ REFERENCE NO. 11 SHEET 19 OF 27
NOTES HOMAN DATE 11/25/12 ROUTE SR 357
H.C. HOMAN WEATHER PTLY CLOUDY COUNTY OTTAWA
R.C. ROUSOS TEMP. 53° SOUTH BASS
ISLAND

DWG BY RHOADES PID 25525

TYPE MONUMENT P.K.NAIL/SHI

~~ON SURFACE~~ - BELOW 0.15'

OFFSET Q PAVEMENT 0.3' ~~LT~~ : RT

8.2' TO RT EDGE PAVEMENT


STATION: 111+40.12

HORIZ.DATUM: NAD 1983 GEOID: 2003

GRID: NORTHING: 727395.439 EASTING: 1886666.955



RECORD:
FD P.K.NAIL/SHI
RSV1373
9/21/07, RGN
POINT RECOVERED
RSV1373
9/25/12
SET MAG/WASHER
11/25/12, DCH

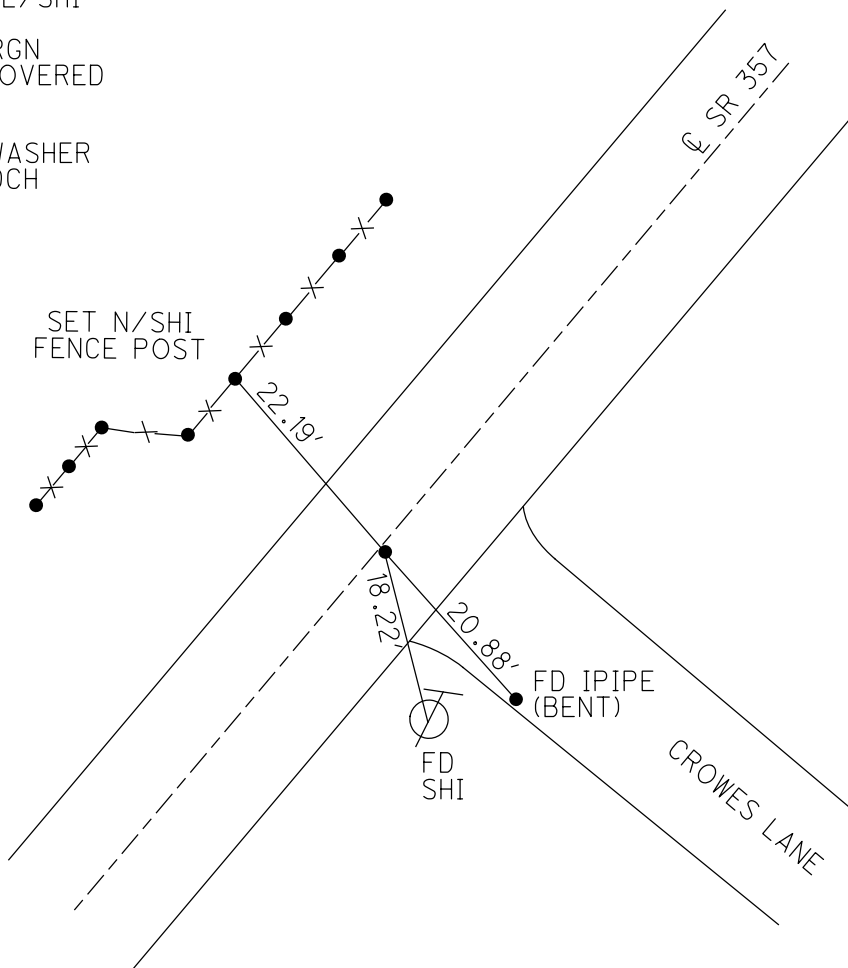

O.D.O.T. DISTRICT 2 SURVEY OFFICE

PERSONNEL

REFERENCE NO. _____

SHEET _____ OF _____

NOTES Huss

H.C. Ryan

R.C. Huss

DATE 9-21-07

WEATHER Clear-Fair

TEMP. + 80°F

ROUTE 357



COUNTY OH

TOWNSHIP _____

SECTION _____

T. _____ R. _____

TYPE MONUMENT N/shi
 ON SURFACE - BELOW 0.15 Below
 LEFT - PAV'T. RIGHT 0.3'
8.2' TO RT EDGE PAVEMENT
 S.L.M. _____

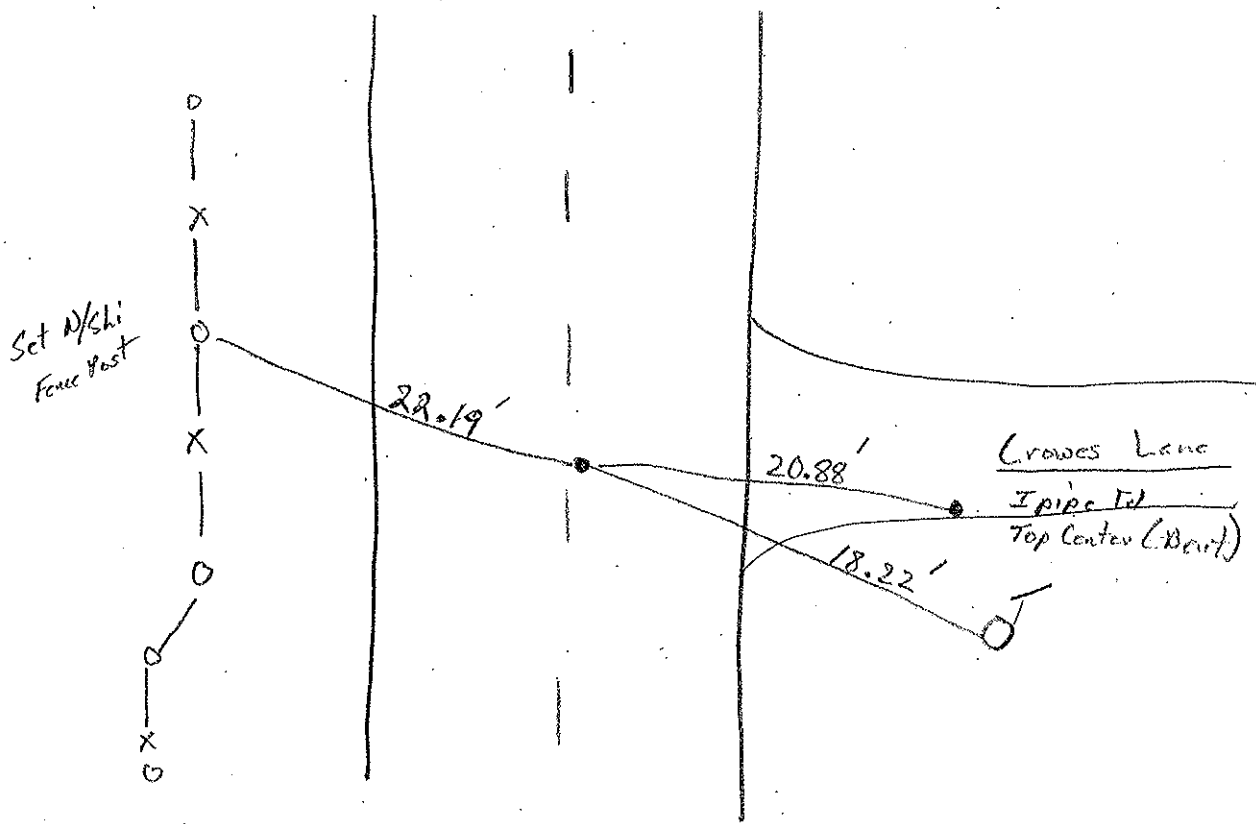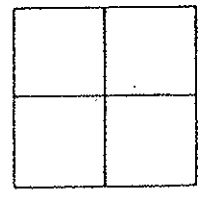

RSU 1373