

O.D.O.T. DISTRICT 2 SURVEY OFFICE (USE ONLY)

PERSONNEL _____

REFERENCE NO. 13

SHEET 21 OF 27

NOTES HOMAN

DATE 11/25/12

ROUTE SR 357

H.C. HOMAN

WEATHER PTLY CLOUDY

COUNTY OTTAWA

R.C. ROUSOS

TEMP. 53°

SOUTH BASS
ISLAND

DWG BY RHOADES PID 25525

TYPE MONUMENT P.K.NAIL

~~ON SURFACE~~ - BELOW 0.15'

OFFSET C PAVEMENT 0.3' ~~LT~~ : RT

7.4' TO RT EDGE PAVEMENT


STATION: 118+27.24

HORZ.DATUM: NAD 1983


GEOID: 2003

GRID: NORTHING: 727907.410

EASTING: 1887125.906

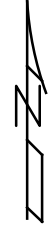

RECORD:
FD P.K.NAIL
0.15' DOWN
RSV109
9/21/07, RGN
POINT RECOVERED
RSV109
9/25/12
SET MAG/WASHER
11/25/12, DCH

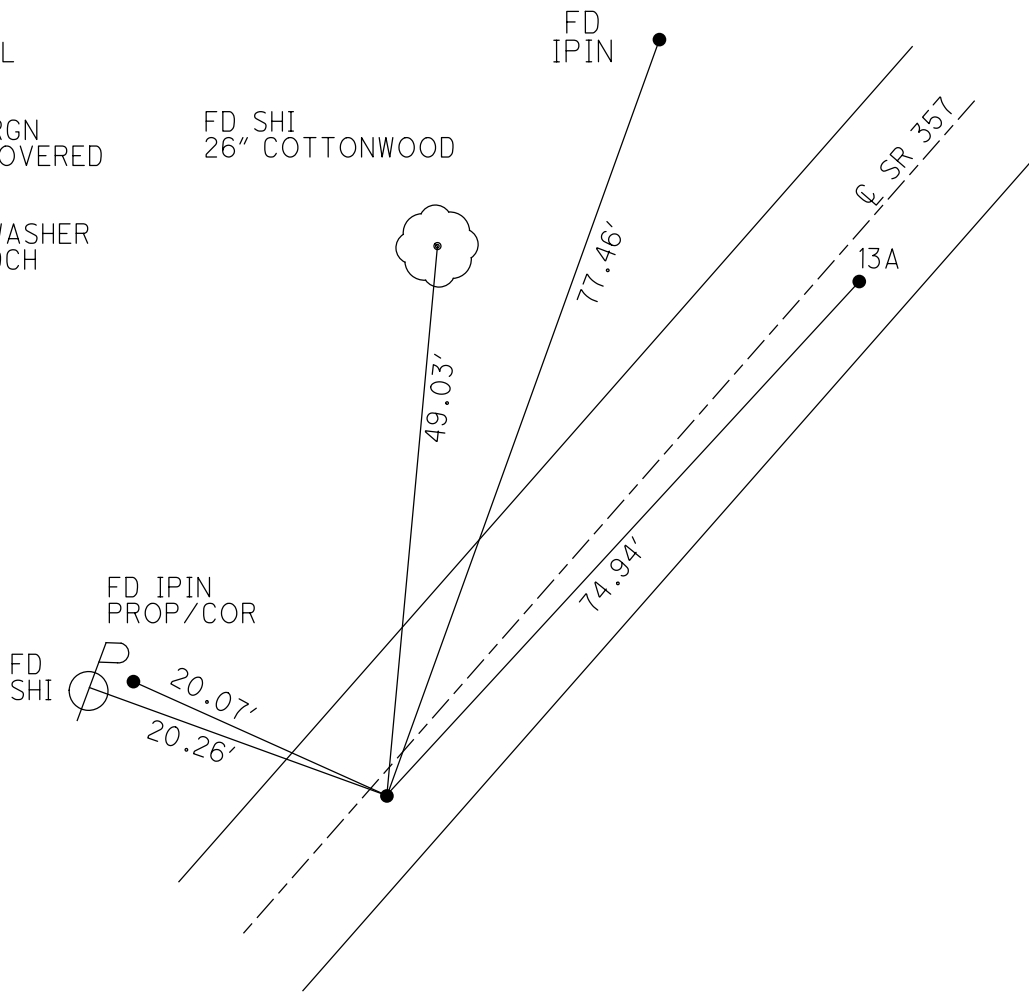

O.D.O.T. DISTRICT 2 SURVEY OFFICE

PERSONNEL _____

REFERENCE NO. _____

SHEET _____ OF _____

NOTES Huss

H.C. Ryan

R.C. Huss

DATE 9-21-07

WEATHER Clear-Fair

TEMP. +81°F

ROUTE 357

COUNTY OH

TOWNSHIP _____

SECTION _____

T. _____ R. _____

TYPE MONUMENT (A) ~~PK~~ PK (B)

ON SURFACE - BELOW (A) 0.15 below B

LEFT - & PAV'T. - RIGHT (A) 0.3' Rt.

(A) 74' TO RT EDGE PAVEMENT

S.L.M. _____

Mag
Swif.

(B) 0.8' Rt.

(B) 7.1' to Rt.

