

O.D.O.T. DISTRICT 2 SURVEY OFFICE (USE ONLY)

PERSONNEL

REFERENCE NO. 13 A

SHEET 22 OF 27

NOTES HOMAN

DATE 11/25/12

ROUTE SR 357

H.C. HOMAN

WEATHER PTLY CLOUDY

COUNTY OTTAWA

R.C. ROUSOS

TEMP. 53°

SOUTH BASS
ISLAND

DWG BY RHOADES PID 25525

TYPE MONUMENT MAG NAIL

ON SURFACE - ~~BELOW~~ ON

OFFSET ☉ PAVEMENT 0.8' ~~RT~~ : RT

7.1' TO RT EDGE PAVEMENT


STATION: 119+04.30

HORZ.DATUM: NAD 1983

GEOID: 2003

GRID: NORTHING: 727963.225

EASTING: 1887175.856

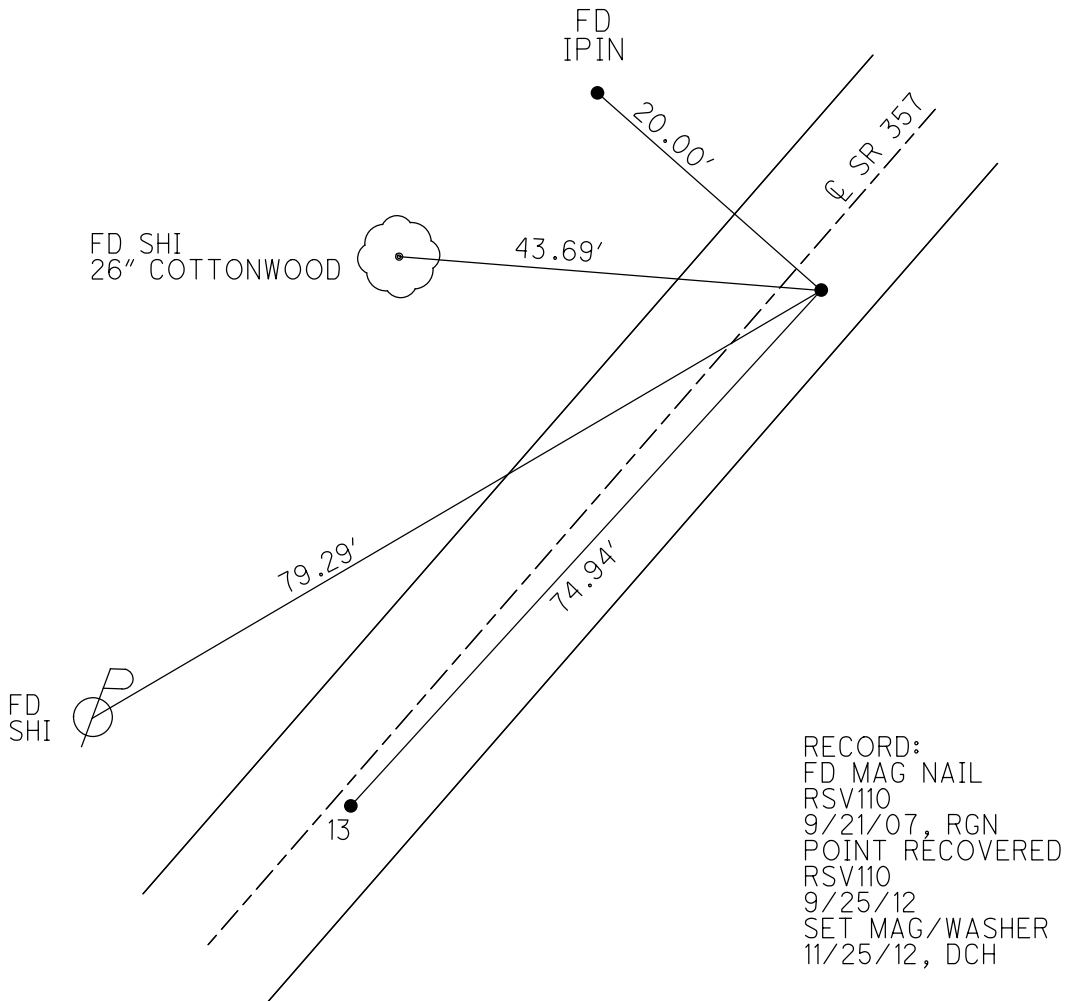

O.D.O.T. DISTRICT 2 SURVEY OFFICE

PERSONNEL _____

REFERENCE NO. _____

SHEET _____ OF _____

NOTES Huss

H.C. Ryan

R.C. Huss

DATE 9-21-07

WEATHER Clear-Fair

TEMP. +81°F

ROUTE 357

COUNTY OH

TOWNSHIP _____

SECTION _____

T. _____ R. _____

TYPE MONUMENT (A) ~~PK~~ PK (B)

ON SURFACE - BELOW (A) 0.15 below B

LEFT - & PAV'T. - RIGHT (A) 0.3' Rt.

(A) 74' TO RT EDGE PAVEMENT

S.L.M. _____

Mag
Swif.

(B) 0.8' Rt.

(B) 7.1' to Rt.

