

O.D.O.T. DISTRICT 2 SURVEY OFFICE (USE ONLY)

PERSONNEL _____ REFERENCE NO. 15 SHEET 25 OF 27
 NOTES HOMAN DATE 11/25/12 ROUTE SR 357
 H.C. HOMAN WEATHER PTLY CLOUDY COUNTY OTTAWA
 R.C. ROUSOS TEMP. 53° SOUTH BASS
 _____ ISLAND

DWG BY RHOADES PID 25525

TYPE MONUMENT R.R.SPIKE

ON SURFACE - ~~BELOW~~ ON _____


OFFSET \odot PAVEMENT 0.5' ~~LT~~ : RT

7.0' TO RT EDGE PAVEMENT


STATION: 122+45.37

HORZ.DATUM: NAD 1983 GEOID: 2003

GRID: NORTHING: 728218.928 EASTING: 1887404.110

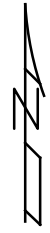

RECORD:
 FD R.R.SPIKE
 RSV121
 9/21/07, RGN
 POINT RECOVERED
 RSV121
 9/25/12
 SET MAG/WASHER
 11/25/12, DCH

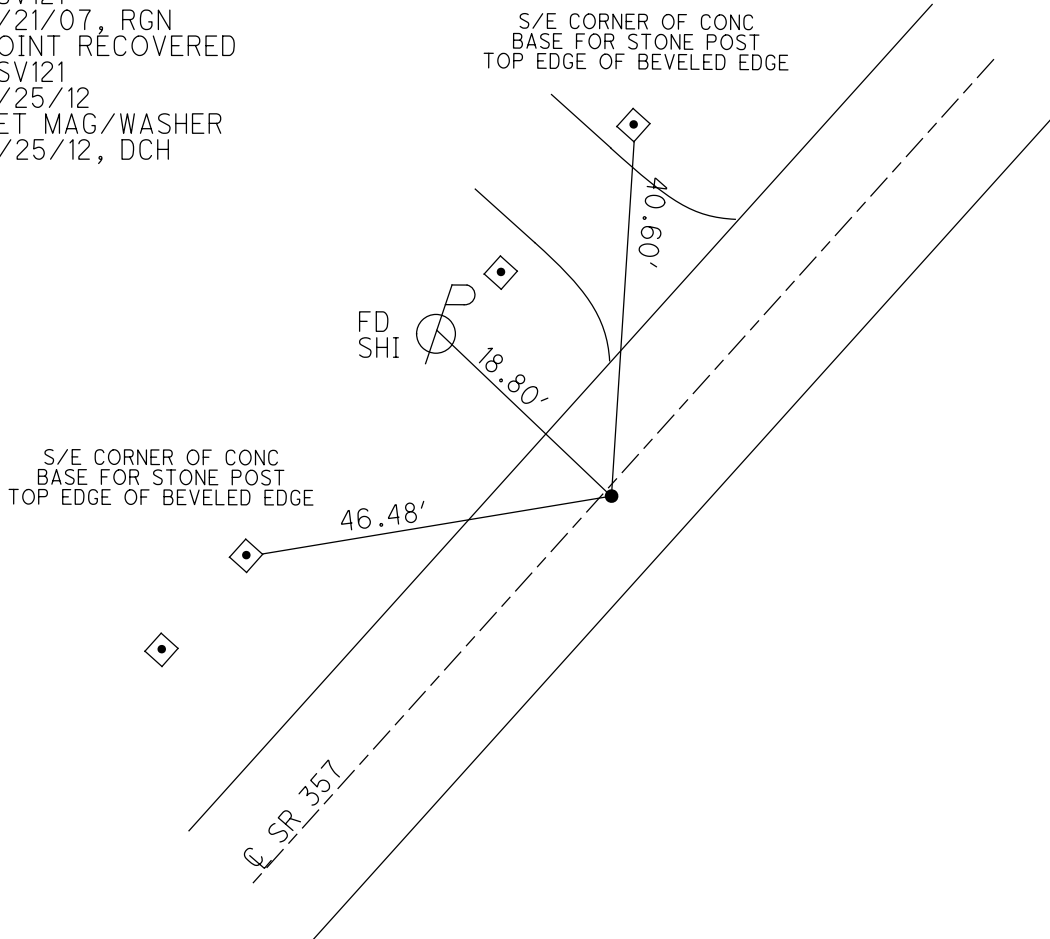

O.D.O.T. DISTRICT 2 SURVEY OFFICE

PERSONNEL _____ REFERENCE NO. _____ SHEET _____ OF _____

NOTES Huss

H.C. Ryan DATE 9-21-07 ROUTE 357

R.C. Huss WEATHER Clear-Fair COUNTY OH

TEMP. +84° F TOWNSHIP _____

SECTION _____

T. _____ R. _____

TYPE MONUMENT RR SPK

ON SURFACE - BELOW Surf.

LEFT - PAV'T. (RIGHT) 0.5'

7.0' TO R+ EDGE PAVEMENT

S.L.M. _____

