

O.D.O.T. DISTRICT 2 SURVEY OFFICE (USE ONLY)

PERSONNEL

REFERENCE NO. 16

SHEET 26 OF 27

NOTES HOMAN

DATE 11/25/12

ROUTE SR 357

H.C. HOMAN

WEATHER PTLY CLOUDY

COUNTY OTTAWA

R.C. ROUSOS

TEMP. 53°

SOUTH BASS  
ISLAND

DWG BY RHOADES PID 25525

TYPE MONUMENT R.R.SPIKE

ON SURFACE - ~~BELOW~~ ON

OFFSET  $\varnothing$  PAVEMENT 0.4' LT : ~~RT~~

15' TO RT EDGE PAVEMENT

STATION: 123+73.68

HORZ.DATUM: NAD 1983


GEOID: 2003

GRID: NORTHING: 728314.560

EASTING: 1887489.866



RECORD:  
FD R.R.SPIKE  
RSV119  
9/21/07, RGN  
POINT RECOVERED  
RSV119  
9/25/12  
SET MAG/WASHER  
11/25/12, DCH

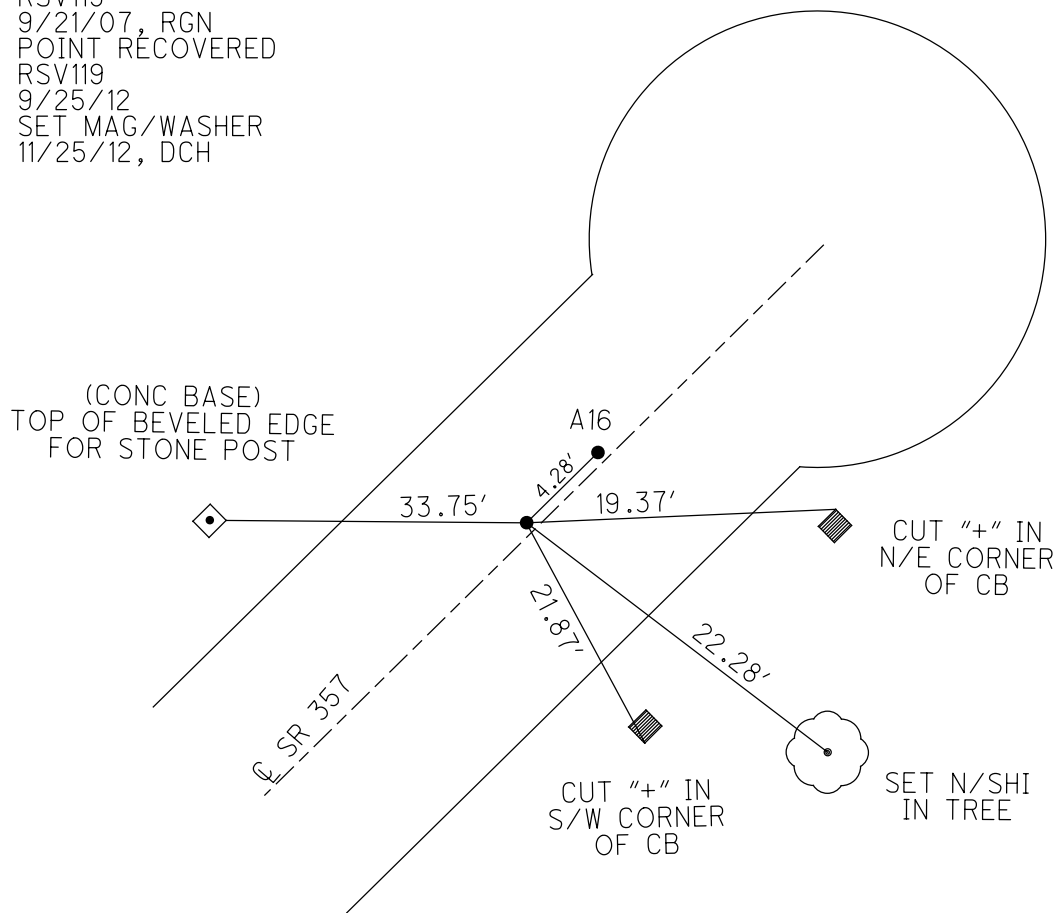

O.D.O.T. DISTRICT 2 SURVEY OFFICE

PERSONNEL

REFERENCE NO. \_\_\_\_\_

SHEET \_\_\_\_\_ OF \_\_\_\_\_

NOTES Huss

H.C. Ryan

R.C. Huss

DATE 9-21-07

WEATHER Clear-Fair

TEMP. + 85° F

ROUTE 357

COUNTY OH.

TOWNSHIP \_\_\_\_\_

SECTION \_\_\_\_\_

T. \_\_\_\_\_ R. \_\_\_\_\_

TYPE MONUMENT (A) RRSPK (B)



ON SURFACE - BELOW (A) Surf (B)

LEFT - &lt;math>0.4</math>' Lt. (A) 0.4' Lt. (B)

(A) 15' TO RT EDGE PAVEMENT (B) 13.7' Rt.

S.L.M. \_\_\_\_\_

RRSPK  
0.3' Below  
0.4 Lt.

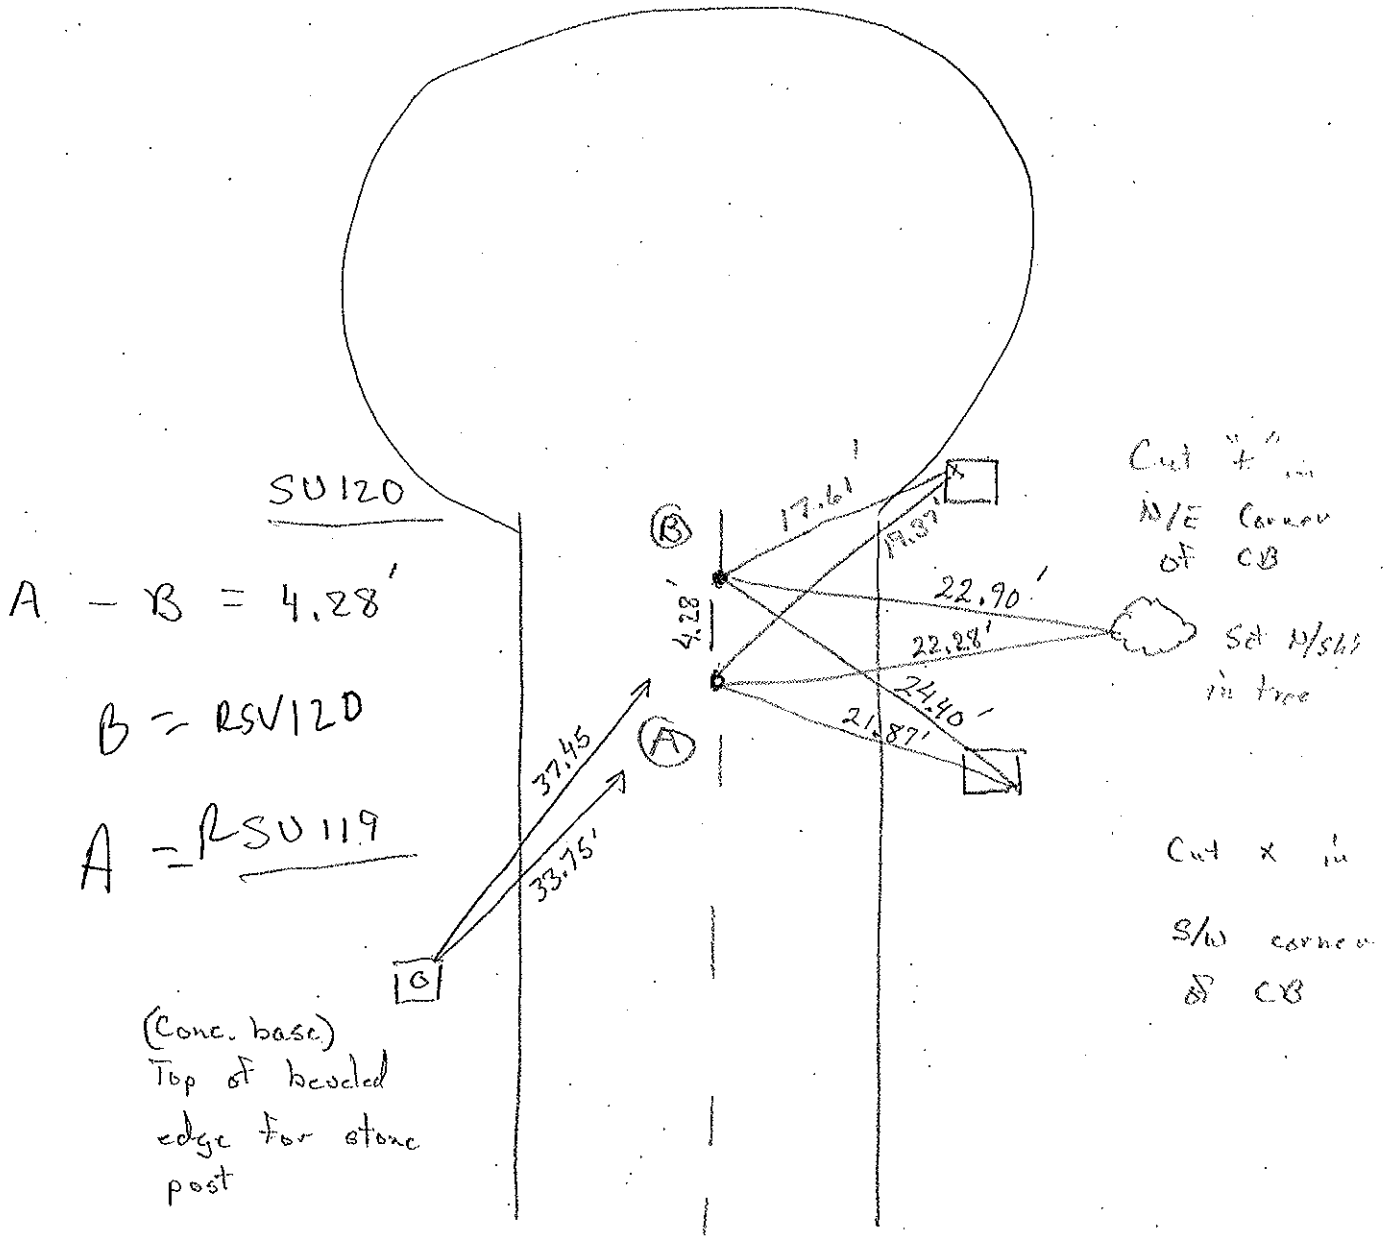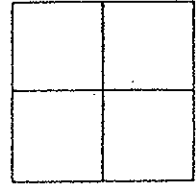

$A - B = 4.28'$

$B = RSV 120$

$A = RSV 119$

(Conc. base)  
Top of beveled  
edge for stone  
post

Cut 4" in  
N/E corner  
of CB  
Set N/Sht  
in tree

Cut x in  
S/W corner  
of CB