

O.D.O.T. DISTRICT 2 SURVEY OFFICE (USE ONLY)

PERSONNEL

REFERENCE NO. 16 A

SHEET 27 OF 27

NOTES HOMAN

DATE 11/25/12

ROUTE SR 357

H.C. HOMAN

WEATHER PTLY CLOUDY

COUNTY OTTAWA

R.C. ROUSOS

TEMP. 53°

SOUTH BASS

ISLAND

DWG BY RHOADES

PID 25525

TYPE MONUMENT R.R.SPIKE

~~ON SURFACE~~ - BELOW 0.3'

OFFSET C PAVEMENT 0.4' LT : ~~RT~~

13.7' TO RT EDGE PAVEMENT

STATION: 123+77.96

HORZ.DATUM: NAD 1983


GEOID: 2003

GRID: NORTHING: 728317.753

EASTING: 1887492.690



RECORD:
FD R.R.SPIKE
0.3' DOWN
RSV120
9/21/07, RGN
POINT RECOVERED
RSV120
9/25/12
SET MAG/WASHER
11/25/12, DCH

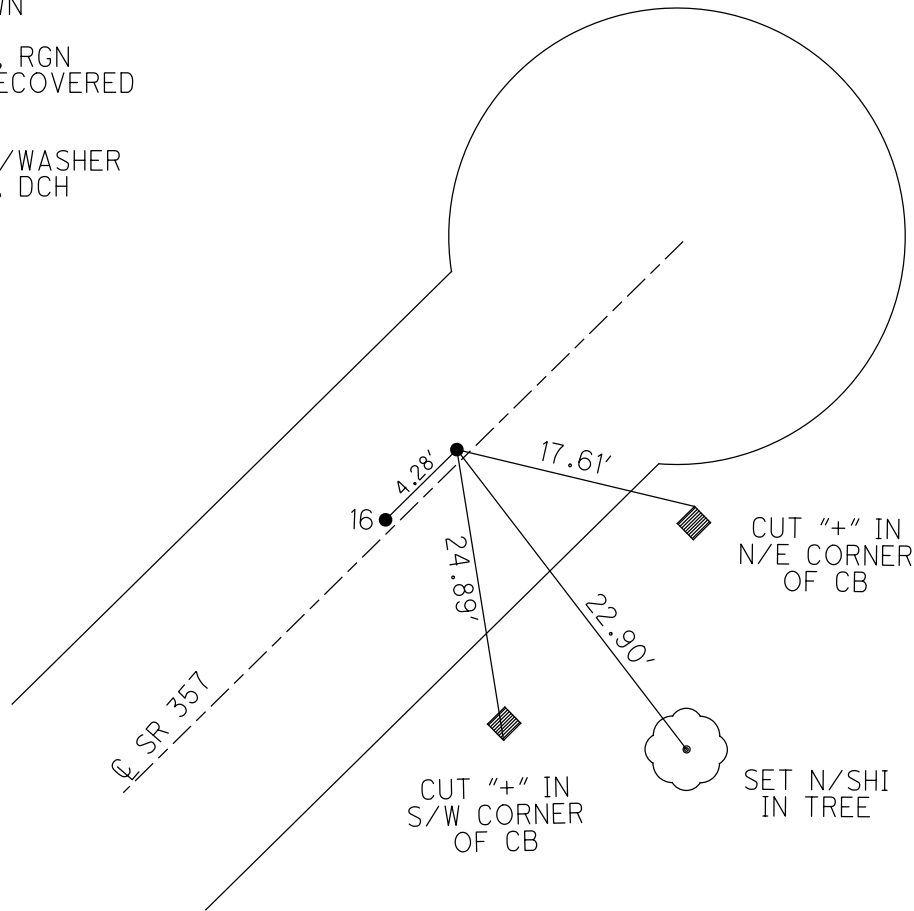

O.D.O.T. DISTRICT 2 SURVEY OFFICE

PERSONNEL

REFERENCE NO. _____

SHEET _____ OF _____

NOTES Huss

H.C. Ryan

R.C. Huss

DATE 9-21-07

WEATHER Clear-Fair

TEMP. + 85° F

ROUTE 357

COUNTY OH.

TOWNSHIP _____

SECTION _____

T. _____ R. _____

TYPE MONUMENT (A) RRSPK (B)



ON SURFACE - BELOW (A) Surf (B)

LEFT - <math>0.4</math>' Lt. (B) 0.4 Lt.

(A) 15' TO RT EDGE PAVEMENT (B) 13.7' Rt.

S.L.M. _____

RRSPK
0.3' Below
0.4 Lt.

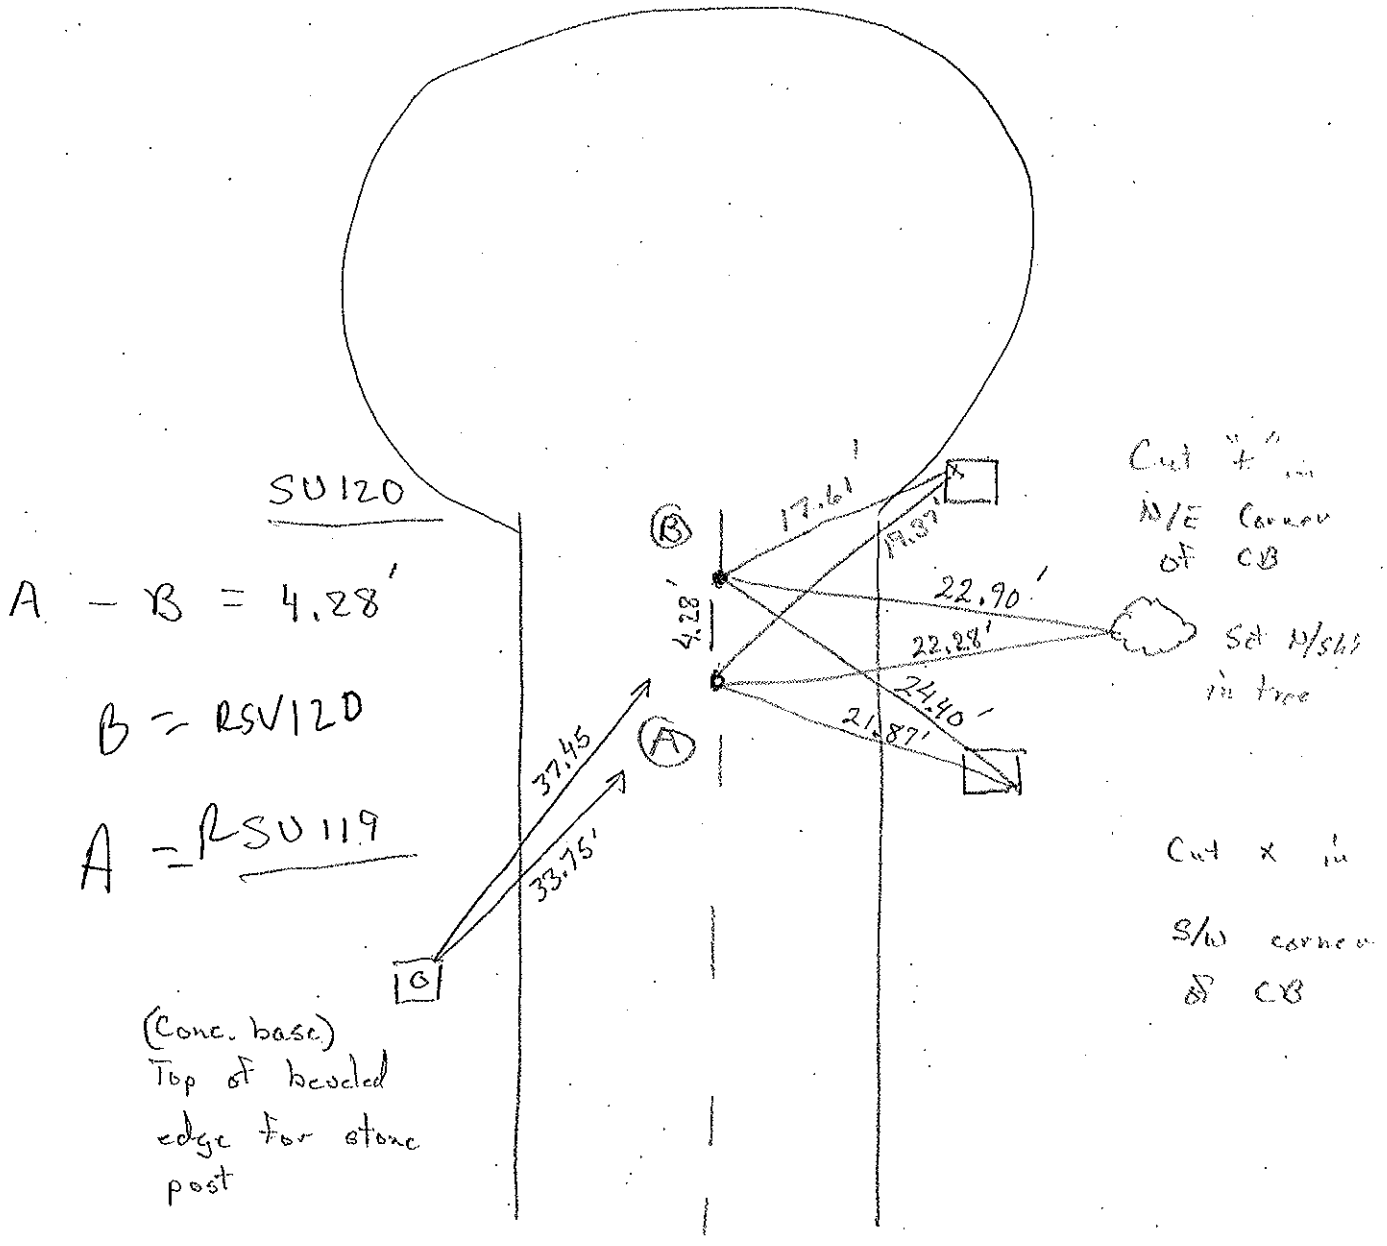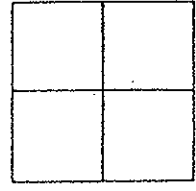

SU120

A - B = 4.28'

B = RSV120

A = RSV119

(Conc. base)
Top of beveled
edge for stone
post

Cut 4" in
N/E corner
of CB

Set N/sht
in tree

Cut x in
S/W corner
of CB