




Scanned
July 1987

For detail of intersection see Sheet #3

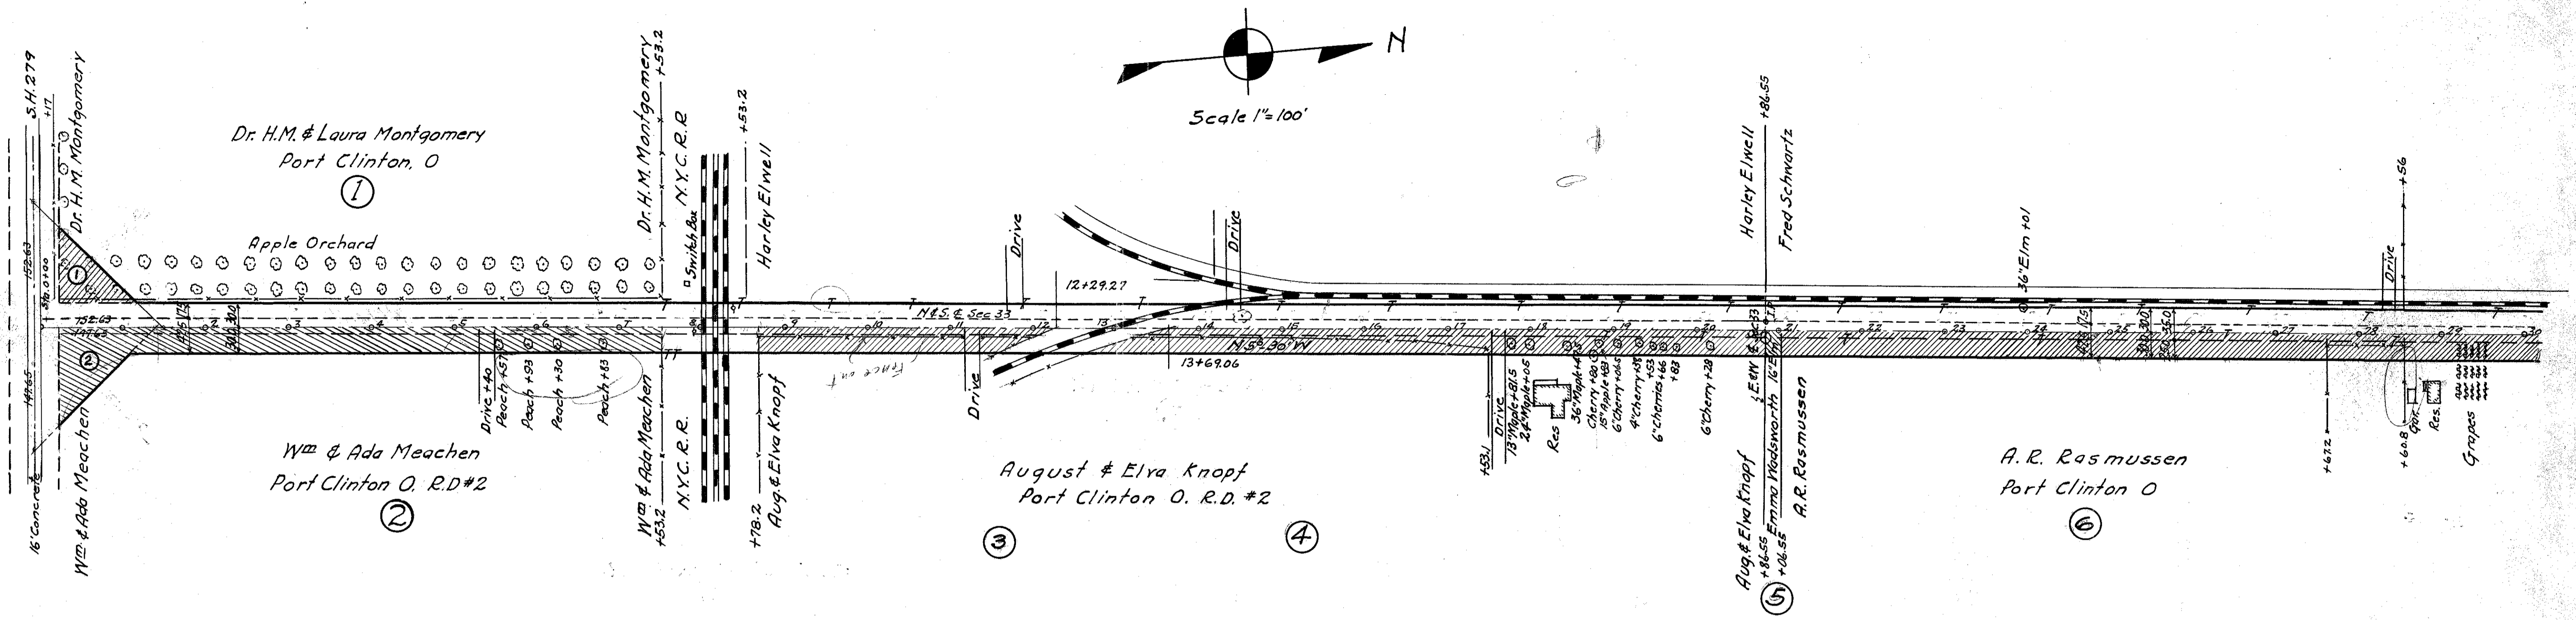


R-4357
E-24

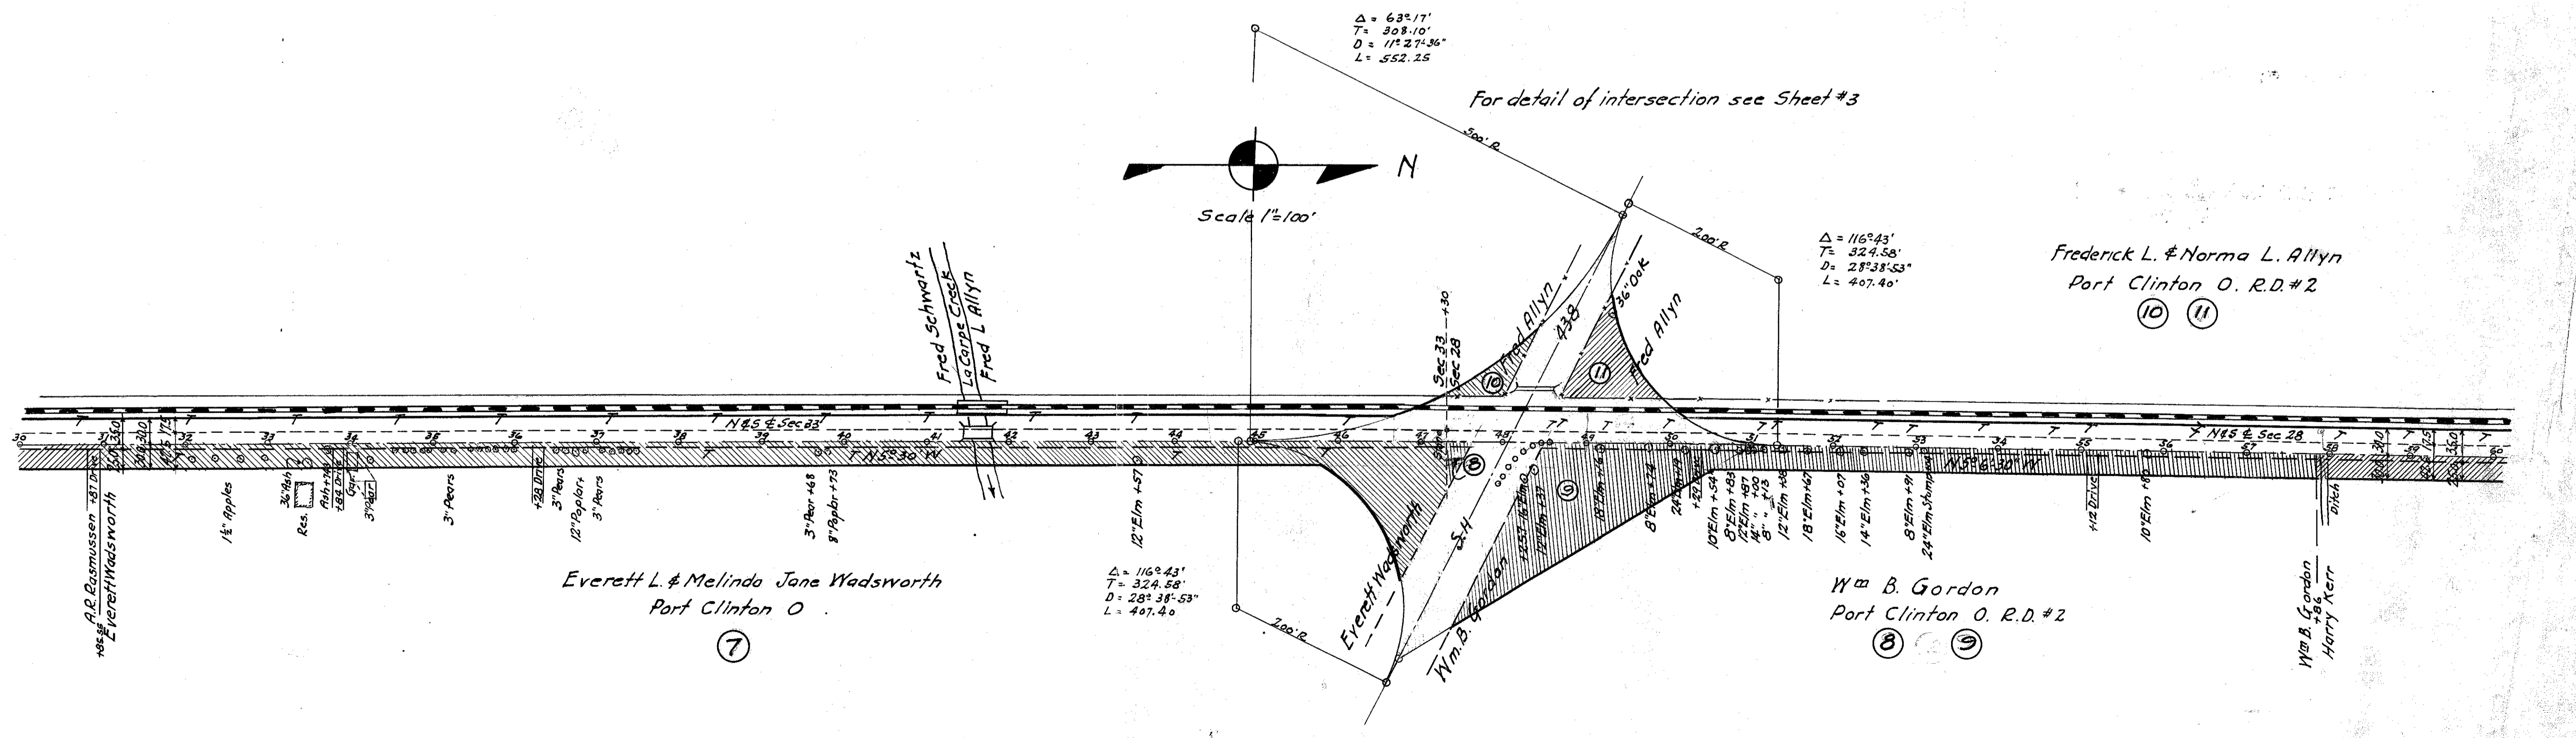

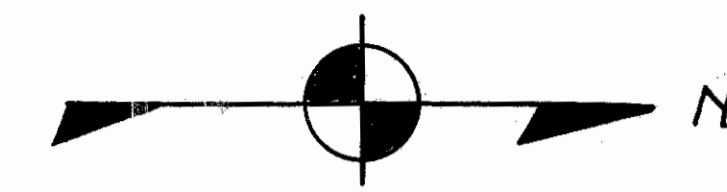




Scale - 1" = 100'

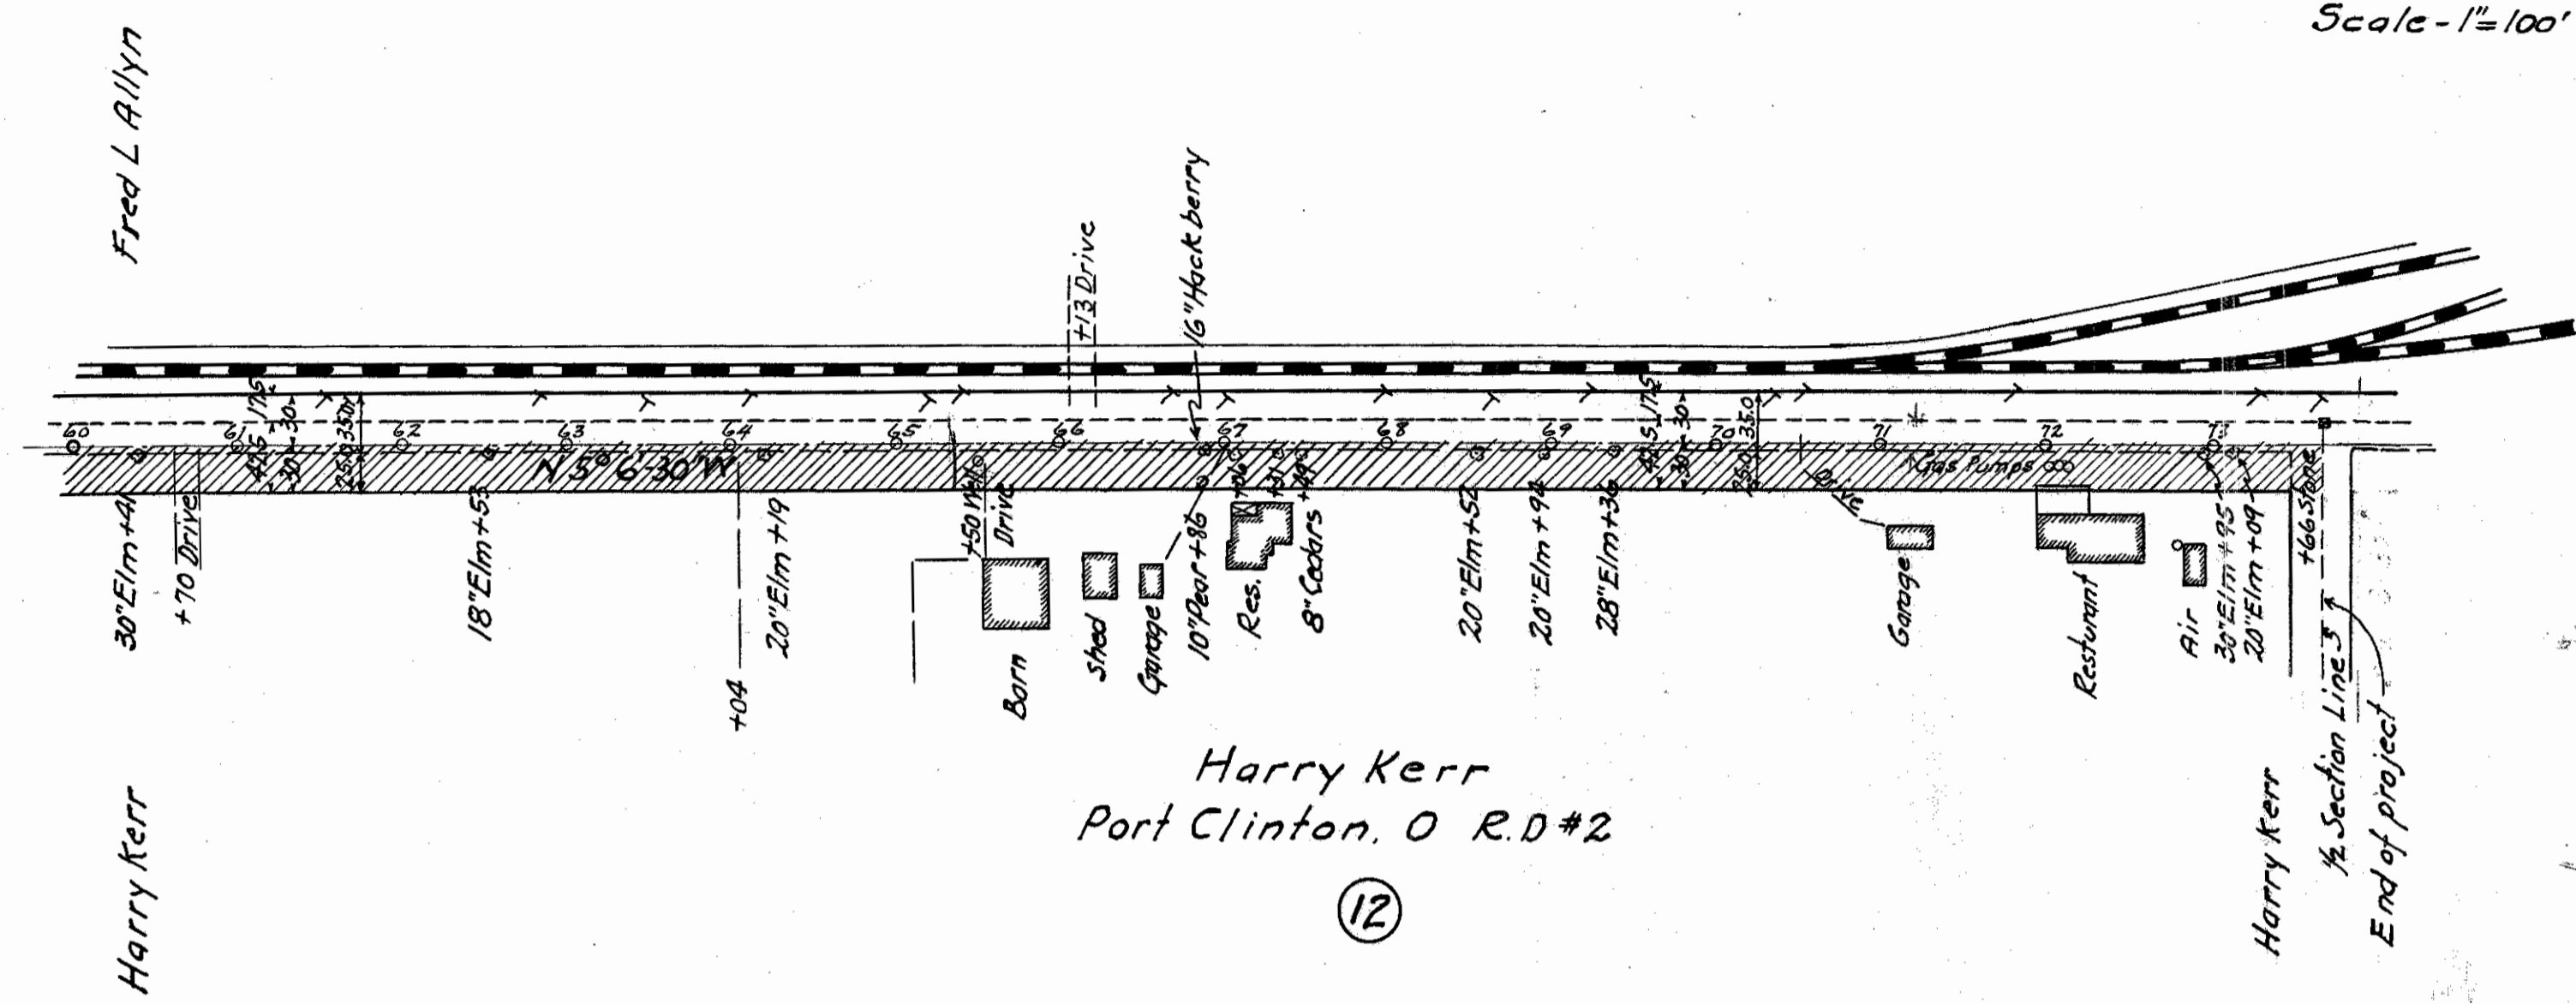

Scanned July 1997

15

Scanned
July 16/77

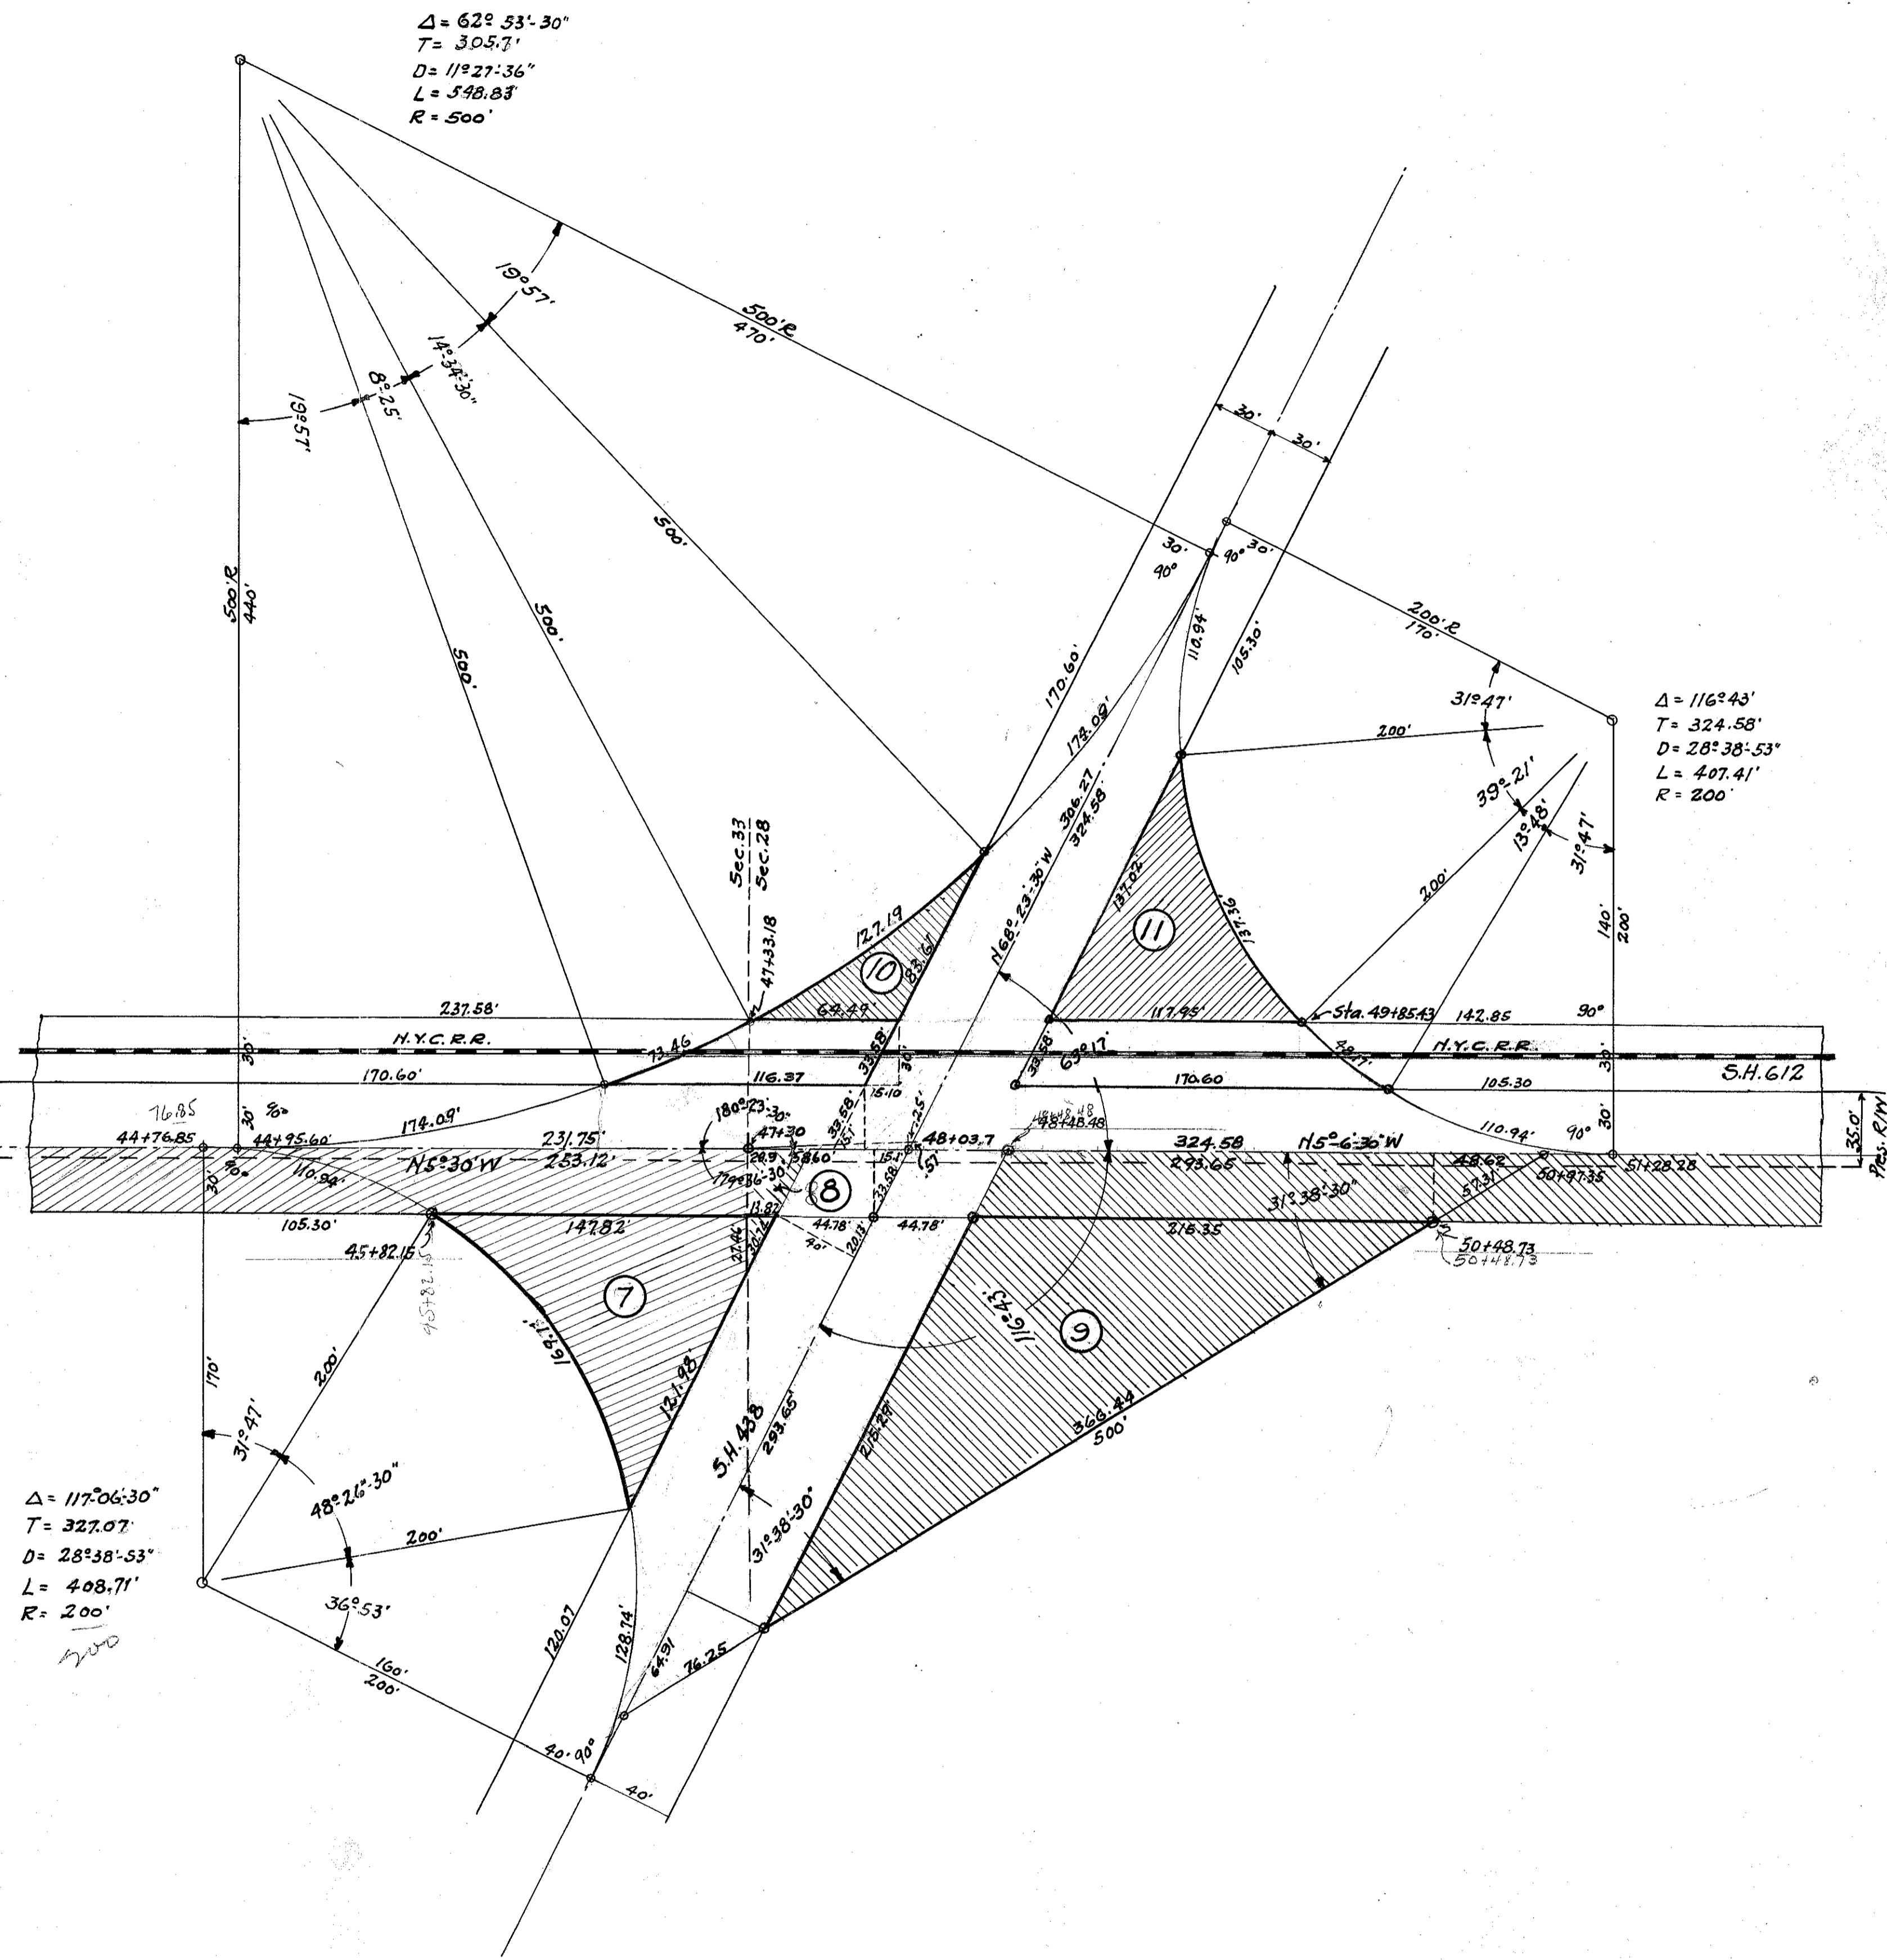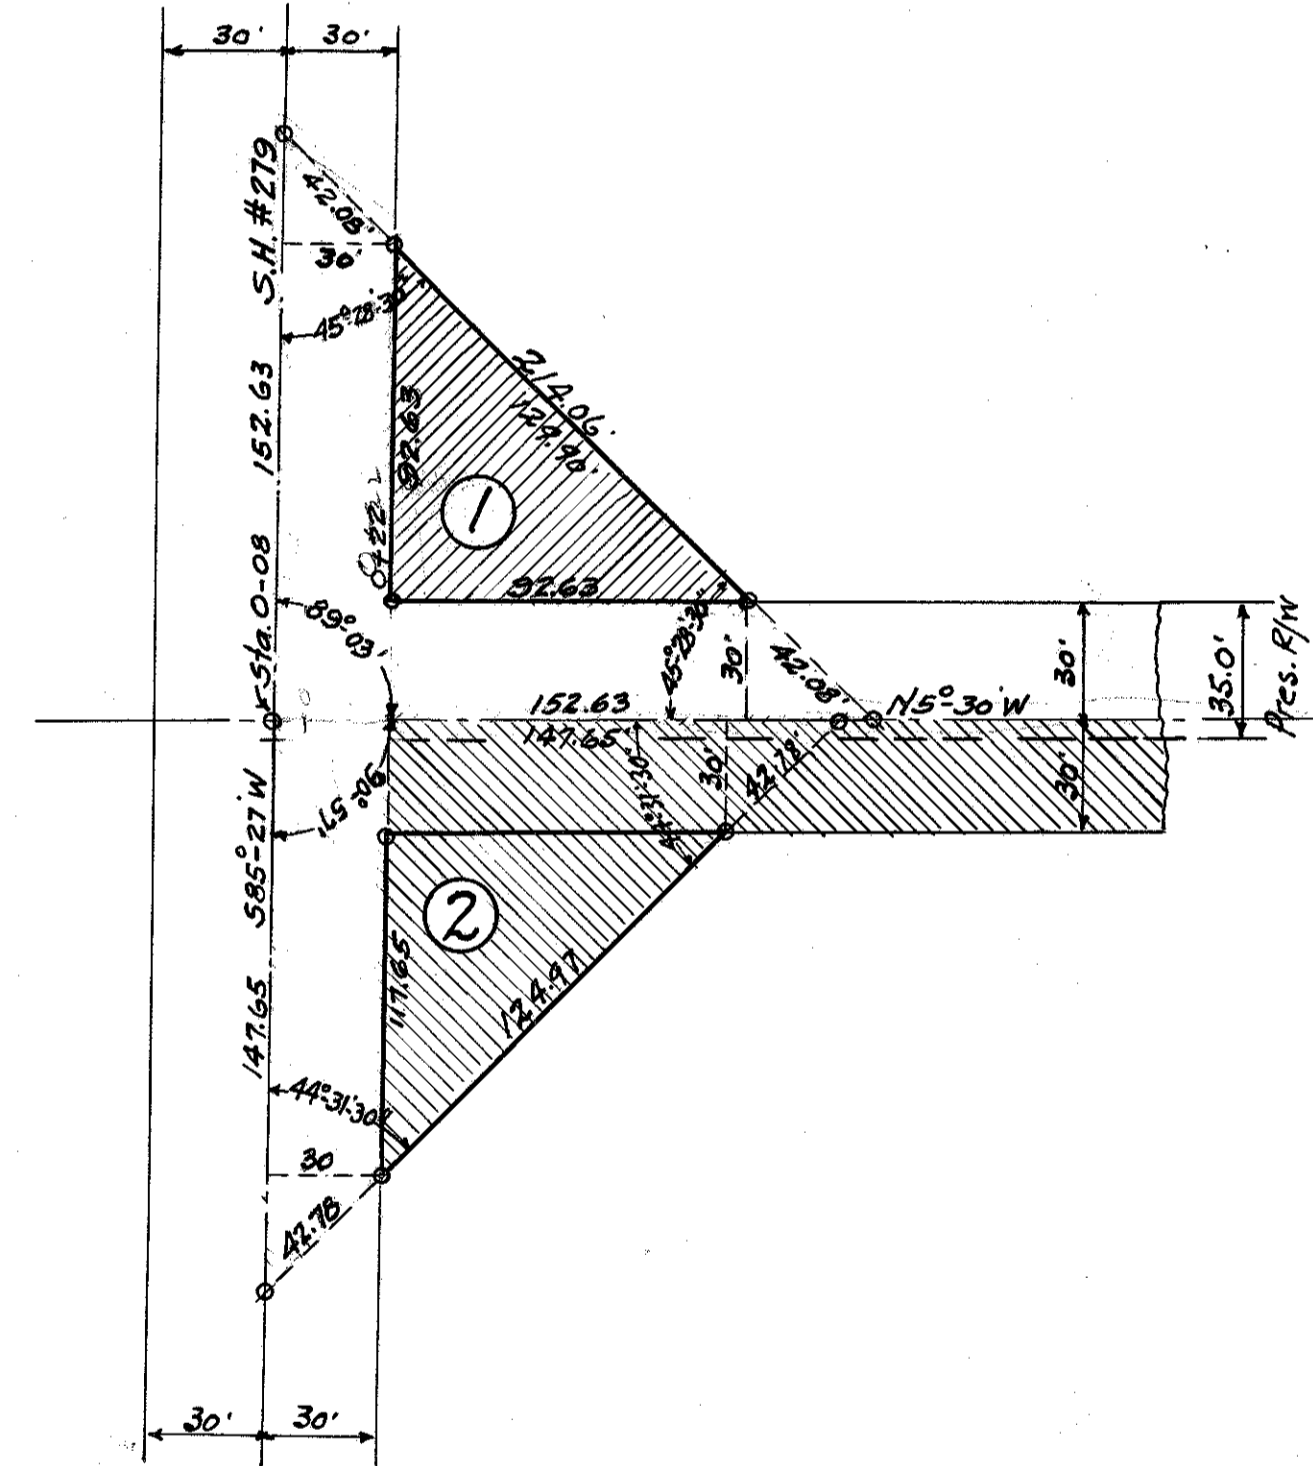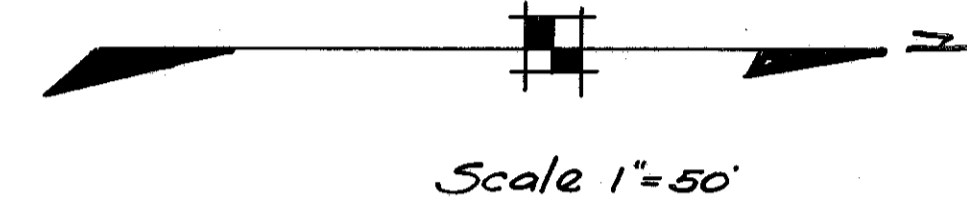

$\Delta = 62^{\circ} 53' 30''$
 $T = 305.7'$
 $D = 11927' 36''$
 $L = 548.83'$
 $R = 500'$

$\Delta = 116^{\circ} 43'$
 $T = 324.58'$
 $D = 28^{\circ} 38' 53''$
 $L = 407.41'$
 $R = 200'$

$\Delta = 117^{\circ} 06' 30''$
 $T = 327.07'$
 $D = 28^{\circ} 38' 53''$
 $L = 408.71'$
 $R = 200'$

CADD DRAWN 25.5.99
GOTO FROM 25.10.99

Scanned
July 1947

OTTAWA COUNTY
S.H. 612 SEC. A (PT)
R/W PLANS

*R/W checked
assumptions obtained
as shown
J.P.
3/8/44*

