

O.D.O.T. DISTRICT 2 SURVEY OFFICE (USE ONLY)

PERSONNEL

REFERENCE NO. A

SHEET 1 OF 36

NOTES RHOADES

DATE 10/5/20

ROUTE SR 579

H.C. AUBLE

WEATHER SUNNY

COUNTY OTTAWA

R.C. O'DONNELL

TEMP. 44°

TOWNSHIP ALLEN

SECTION 6

DWG BY RHOADES

PID 95759

T 7 N R 13 E


TYPE MONUMENT MAG/WASHER

ON SURFACE - ~~BELOW~~ ON

OFFSET CL PAVEMENT 1.0' ~~LT~~ : RT

- TO - EDGE PAVEMENT

STATION: 0+00

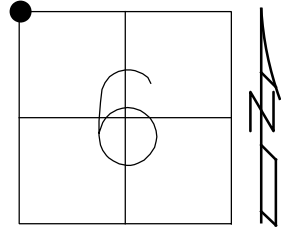

HORZ. DATUM: NAD83 2011


GEOID: NAVD88 2012A

GRID: NORTHING: 706368.354

EASTING: 1718038.576

RECORD: P.I.
 STA. 0+00
 $\Delta = 0^\circ 55' 30''$ LT
 FD R.R. SPIKE
 3" DOWN
 8/30/02, MB
 SET MAG/WASHER
 11/27/02, MB
 FD MAG/WASHER
 REFAA1
 10/29/18, JFO

NOTE: REF 6 WOO 579

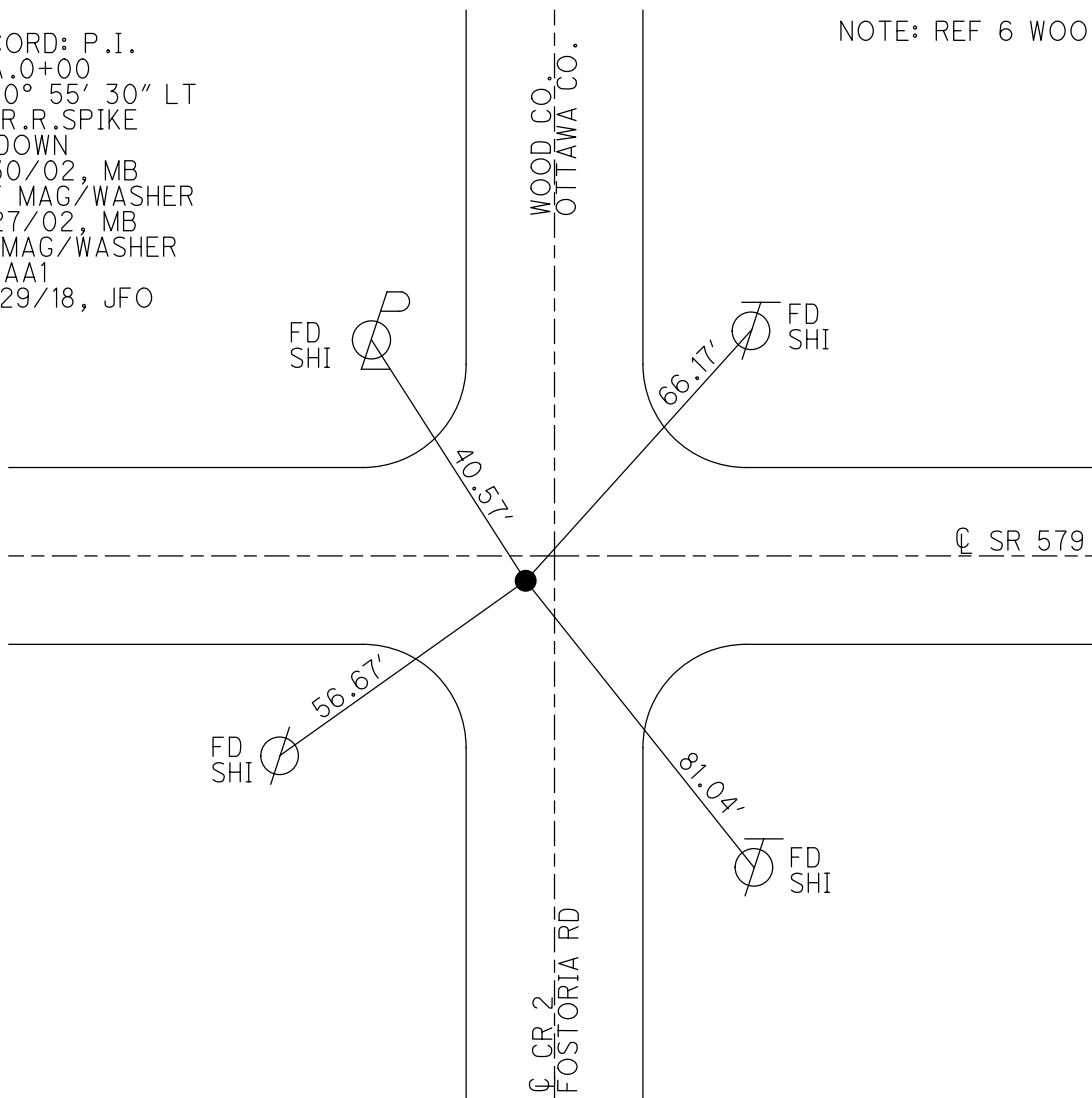

O.D.O.T. DISTRICT 2 SURVEY OFFICE

PERSONNEL

NOTES BARNHISEL
 H.C. CANTERBURY
 R.C. BARNHISEL


REFERENCE NO. "A" OTTAWA SHEET 1 OF 34
"Co" 1000

DATE 8-30-02
 WEATHER SUN
 TEMP. +75°

ROUTE S.R. 579
 COUNTY OTTAWA
 TOWNSHIP ALLEN
 SECTION 6
 T. 7 N R. 13 E


TYPE MONUMENT R.R. SPIKE
~~ON SURFACE - BELOW~~ 3" DOWN
~~LEFT - & PAV'T. - RIGHT~~ 1.0' RT
— TO — EDGE PAVEMENT

S.L.M. 0+00 (127461 Rec. v100) 7' W. OF & NORTH

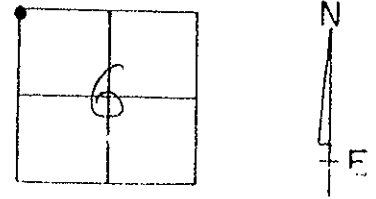

RECORD. P.I. 0+00
A = 0° 55' 30" LT

RESET MAG NAIL/WASHER
 11-27-02
 MB

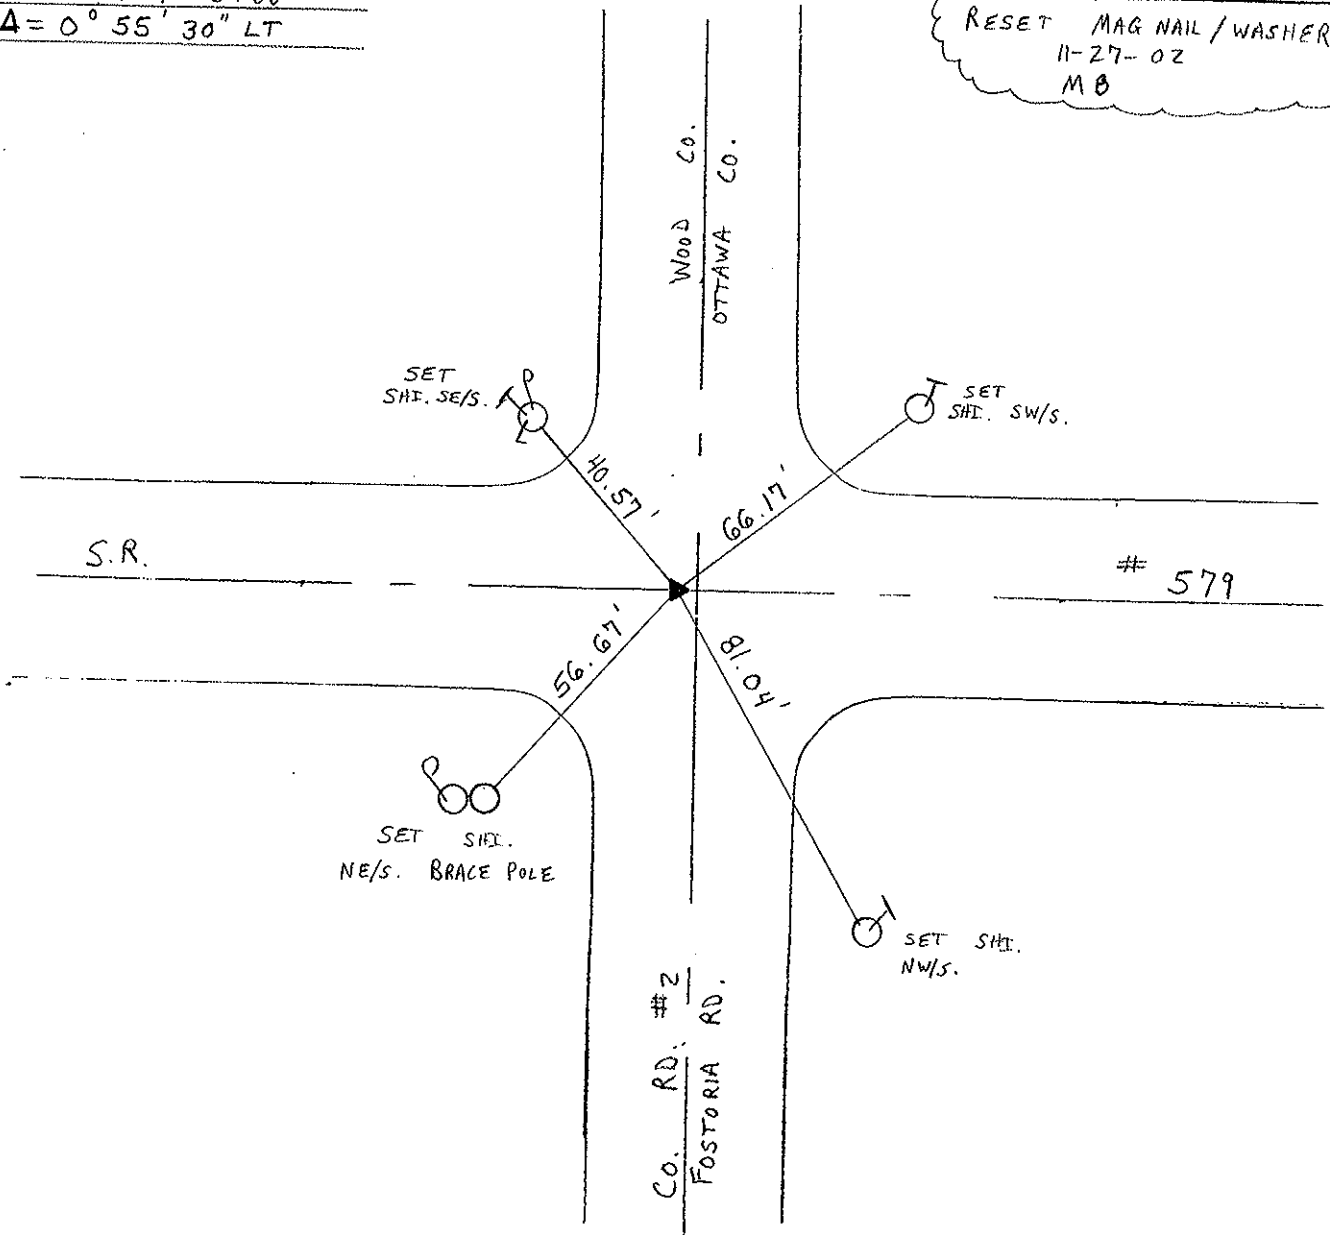

O.D.O.T. DISTRICT 2 SURVEY OFFICE

PERSONNEL


NOTES BARNHISEL
 H.C. CANTERBURY
 R.C. BARNHISEL

REFERENCE NO. "A" OTTAWA SHEET / OF
"CR" Wood

DATE 8-30-02
 WEATHER SUN
 TEMP. +75°


ROUTE S.R. 579
 COUNTY OTTAWA
 TOWNSHIP ALLEN
 SECTION 6
T 7 N R 13 E

TYPE MONUMENT R.R. SPIKE
~~ON SURFACE~~ - BELOW 3" DOWN
~~LEFT - E PAV'T.~~ - RIGHT 1.0' RT
TO EDGE PAVEMENT
 S.L.M. 0+00 (127+61 Rec. Wood) 7' W. OF E NORTH

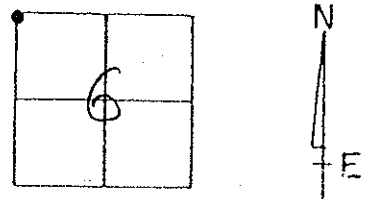

RECORD P.I. 0+00
 $\Delta = 0^\circ 55' 30''$ LT

RESET MAG NAIL/WASHER
 11-27-02
 MB

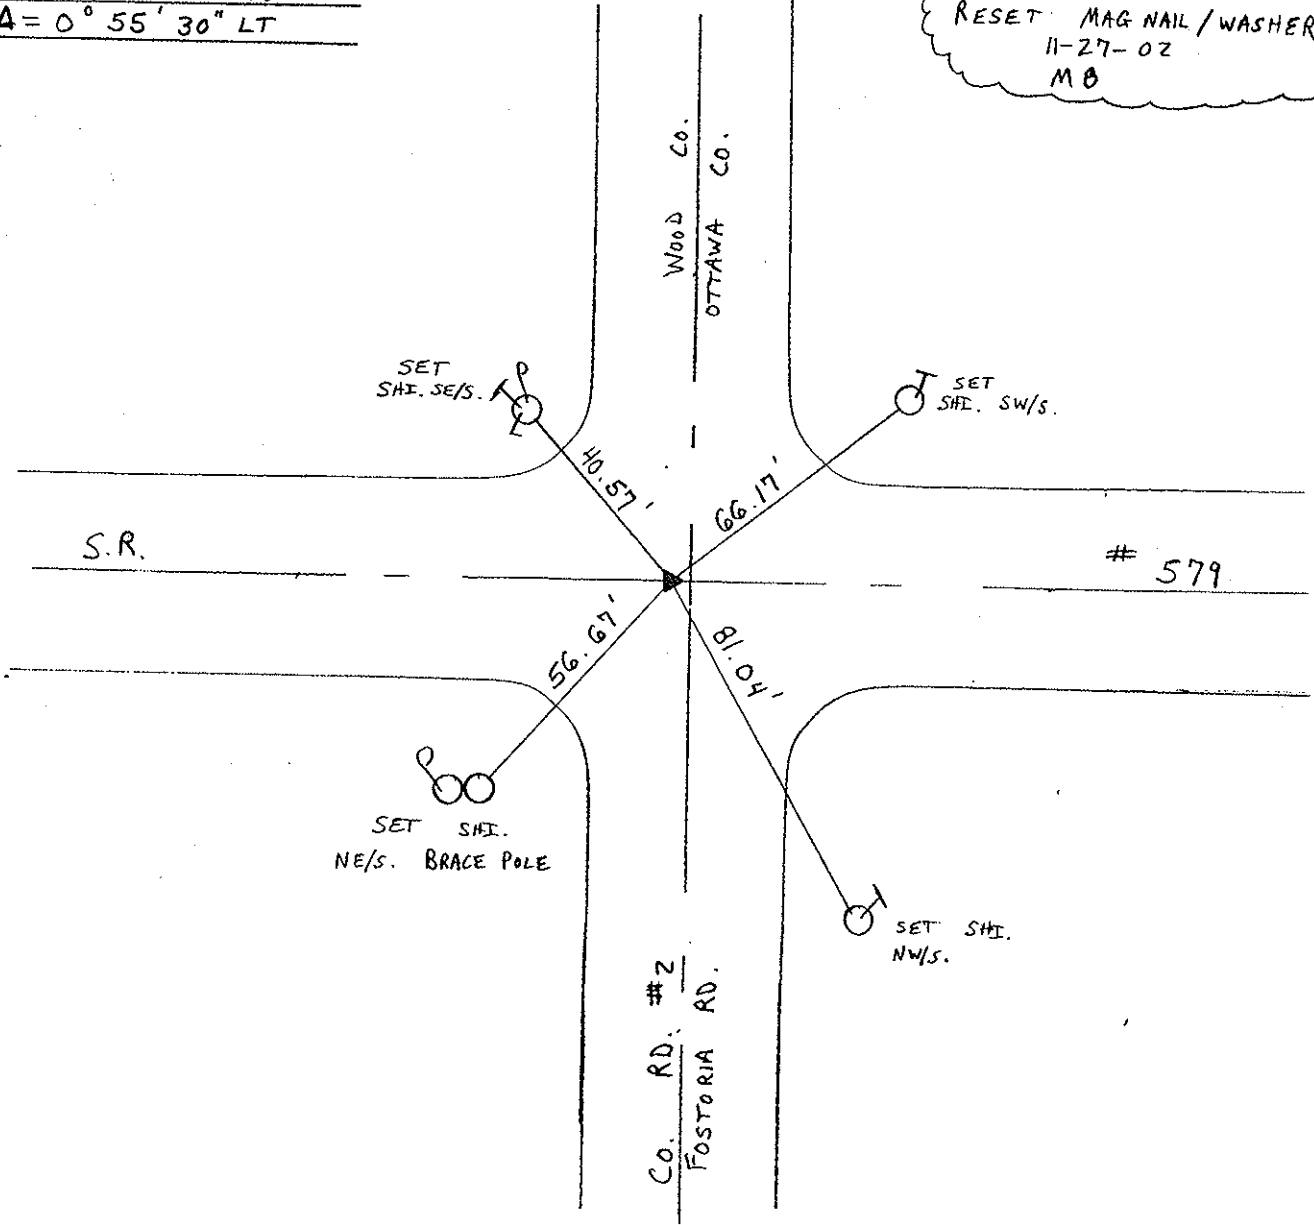

RESURFACED 2002

O.D.O.T. DISTRICT 2 SURVEY OFFICE

PERSONNEL _____ REFERENCE NO. 0 SHEET 1 OF _____

NOTES CRONIN

H.C. _____

R.C. _____

DATE 9-20-77

WEATHER _____

TEMP. _____

ROUTE SR-579

COUNTY OTTAWA

TOWNSHIP ALLEN

SECTION 6

T7 N R 13 E


TYPE MONUMENT R.R SPIKE

ON SURFACE - BELOW _____


LEFT- & PAV'T. - RIGHT _____

_____ TO _____ EDGE PAVEMENT

S.L.M. 0.00

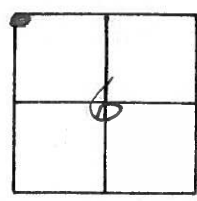


RESET P.K. NAIL
 $\Delta = 0^{\circ} 55' 30''$ LT.
 0+00

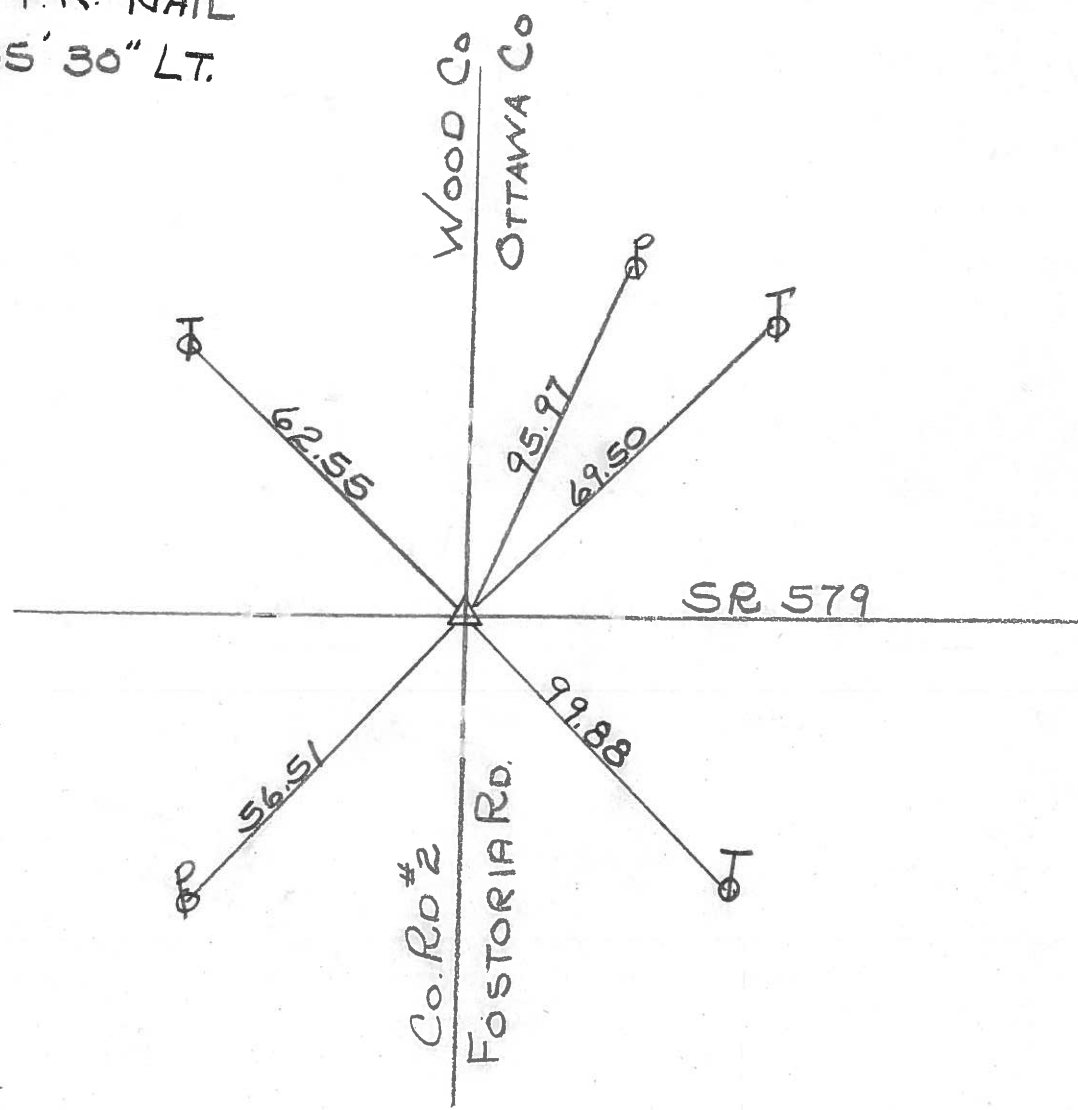


DRAWN BY
 WM. LUCE
 5-7-85

PERSONNEL	TITLE	PERSONNEL	TITLE	COUNTY	DATE
<u>Schneider</u>		<u>Vinson</u>		<u>Ottawa</u>	<u>9-17-71</u>
<u>Mosser</u>				S. R. <u>579</u>	WEATHER <u>Fair</u>
<u>Barbour</u>				SEC. <u>6 & 31</u>	TEMP. <u>60°</u>
<u>Geyman</u>					


DESCRIPTION Allen Twp. JOB NO. _____

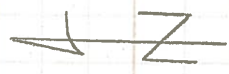


P.I. 2
 51+65.40
 R.R. spk. on top
 $\Delta = 0^{\circ}09'20''$ Rt.

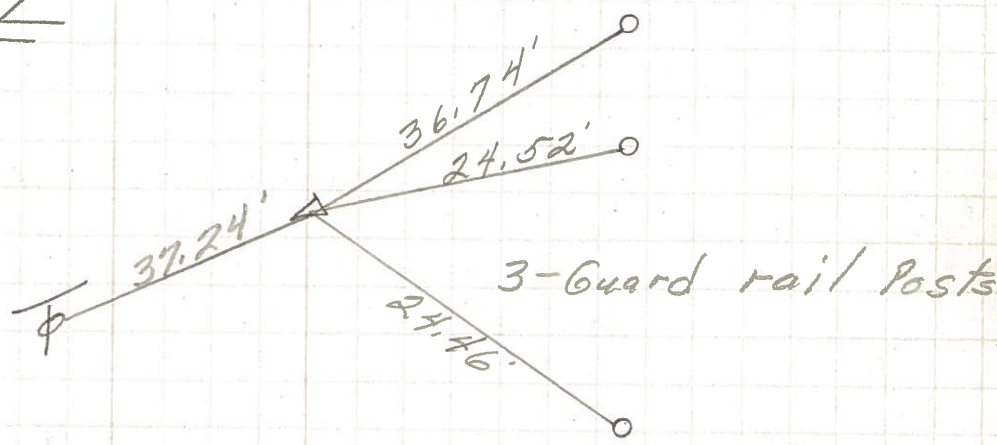

2 "X" on concrete tile
 P.I. 1
 25+25.31
 R.R. spk. on top
 $\Delta = 0^{\circ}16'$ Lt.

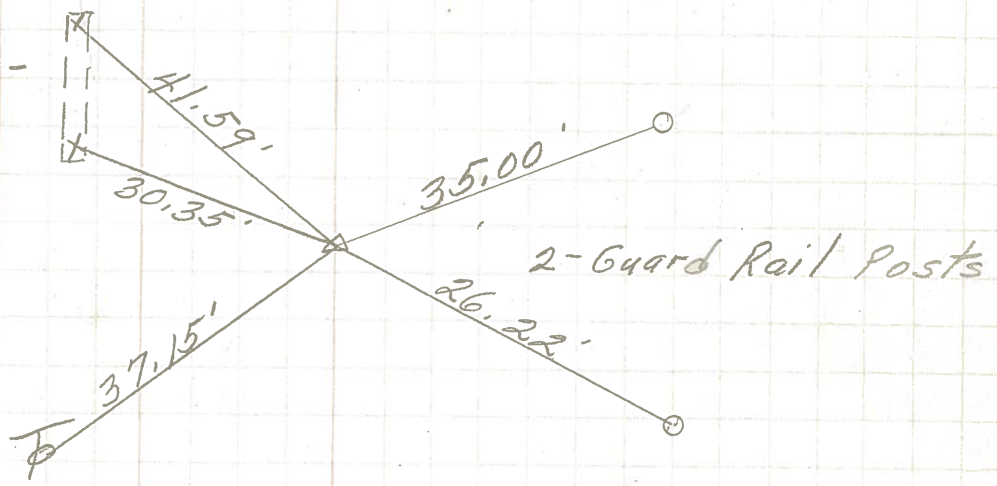

1
 P.I. ϕ
 131+2240 BK. =
 0+00
 R.R. spk. on top
 $\Delta = 0^{\circ}55'30''$ Lt.

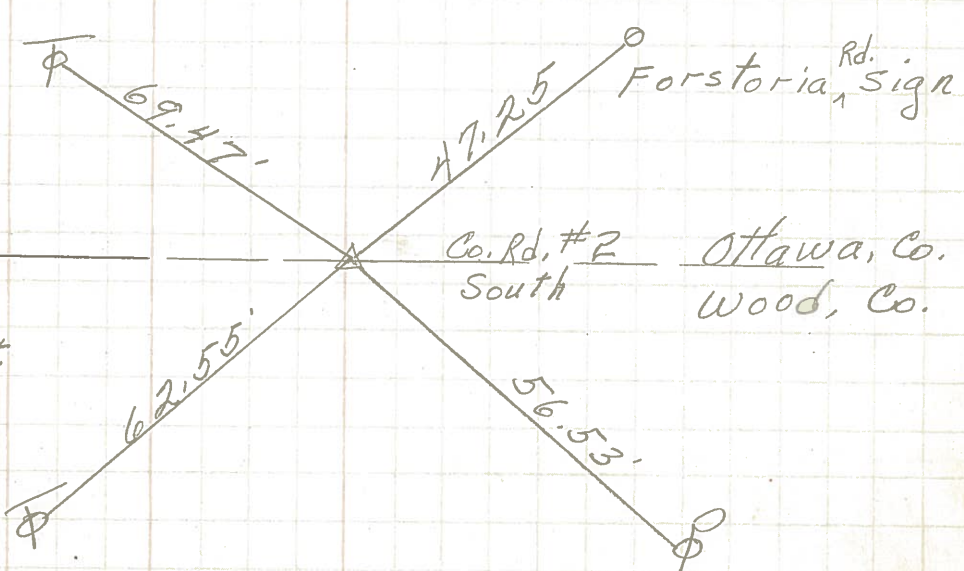

PERSONNEL	TITLE	PERSONNEL	TITLE
Schneider		Pot's	
Masser			
Barbour			
Reardon			

COUNTY Ottawa DATE 9-16-68
 S. R. 579 WEATHER Fair
 SEC. Woodbine - East TEMP. 80°

DESCRIPTION Ties for Center Points LEFT CENTER LINE RIGHT JOB NO.

