

O.D.O.T. DISTRICT 2 SURVEY OFFICE (USE ONLY)

PERSONNEL

REFERENCE NO. 3 B

SHEET 6 OF 36

NOTES RHOADES DATE 8/24/21
 H.C. O'DONNELL WEATHER SUNNY
 R.C. NIESE TEMP. 80°

ROUTE SR 579
 COUNTY OTTAWA
 TOWNSHIP ALLEN
 SECTION 5
 T 7 N R 13 E

DWG BY RHOADES PID 95759

TYPE MONUMENT MAG/WASHER

ON SURFACE - ~~BELOW~~ ON

OFFSET CL PAVEMENT 5.7' LT : RT

17.4' TO LT EDGE PAVEMENT


STATION: 52+05.2

HORZ. DATUM: NAD83 2011


GEOID: NAVD88 2012A

GRID: NORTHING: 706463.379

EASTING: 1723242.008

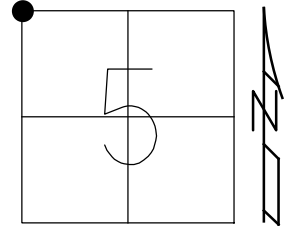

RECORD:
 SET MAG/WASHER
 11/26/02, MB
 FD MAG/WASHER
 579REFC3
 6/21/11, TMR
 FD MAG/WASHER
 REFB3
 10/29/18, JFO
 SET MAG/WASHER
 8/24/21, JFO

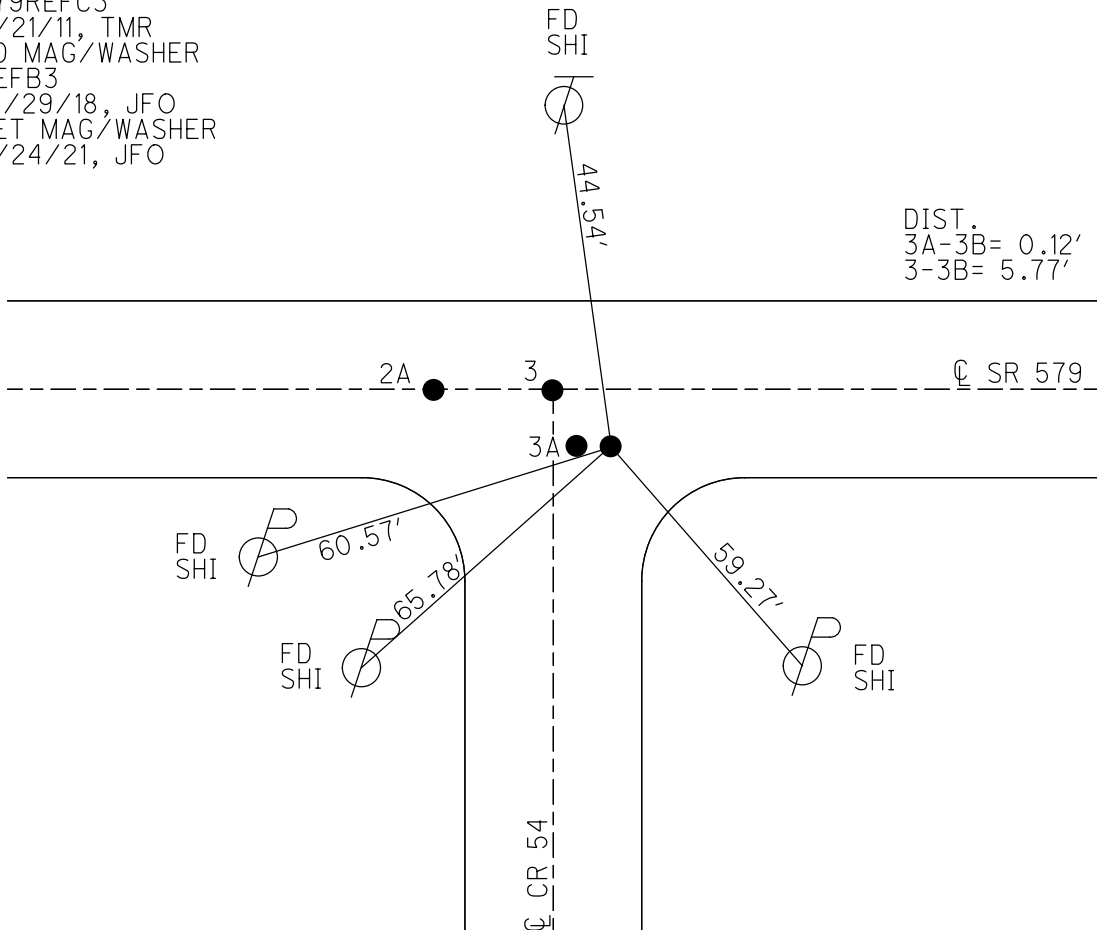


DIST.
 3A-3B= 0.12'
 3-3B= 5.77'

O.D.O.T. DISTRICT 2 SURVEY OFFICE (USE ONLY)

PERSONNEL	REFERENCE NO.	<u>3 B</u>	SHEET	<u>4</u>	OF	<u>12</u>
NOTES	FINGER	DATE	<u>6/21/11</u>	ROUTE	<u>SR 579</u>	
H.C.	<u>ROUSOS</u>	WEATHER	<u>SUNNY</u>	COUNTY	<u>OTTAWA</u>	
R.C.	<u>FINGER</u>	TEMP.	<u>91°</u>	TOWNSHIP	<u>ALLEN</u>	
				SECTION	<u>5</u>	
				T	<u>7</u>	N
				R	<u>13</u>	E


TYPE MONUMENT MAG/WASHER
 ON SURFACE - ~~BELOW~~ ON
~~LEFT~~ - ☉ PAV'T - RIGHT 5.7'
17.4' TO LT EDGE PAVEMENT
 S.L.M. 52+06.2

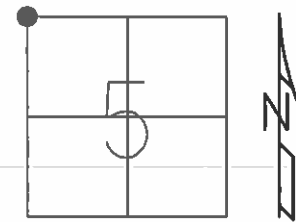

GRID: NORTHING: 706463.333 EASTING: 1723241.815

RECORD:
 SET MAG/WASHER
 11/26/02, MB
 FD MAG/WASHER
 579REFC3
 6/21/11, TMR

DIST:
 3B TO 3 = 5.77'
 3A TO 3 = 5.74'
 3 TO 2A = 39.33'
 2A TO 3B = 39.48'
 2A TO 3A = 39.96'

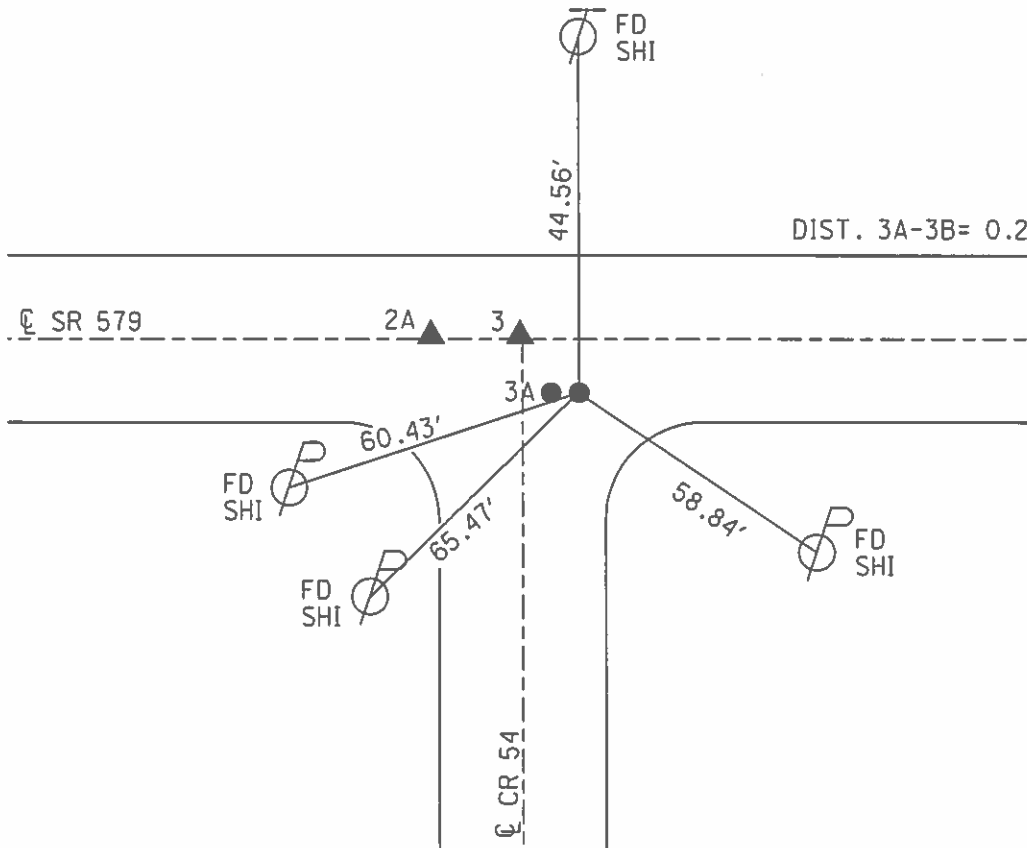

O.D.O.T. DISTRICT 2 SURVEY OFFICE

PERSONNEL _____

REFERENCE NO. 3A

SHEET 4 OF 34

NOTES BARNHISEL

H.C. CANTERBURY

R.C. BARNHISEL

DATE 8-30-02

WEATHER SUNNY

TEMP. +72°


ROUTE S.R. 579

COUNTY OTTAWA

TOWNSHIP ALLEN

SECTION 6-31

T 9 N R 13 E

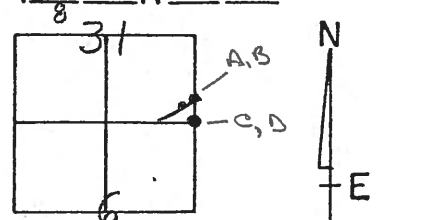

TYPE MONUMENT P.K. NAILS

ON SURFACE - ~~BELOW~~ SURFACE

~~LEFT - & PAV'T.~~ - RIGHT 5.7' RT &


~~Both~~ 17.4 TO LT EDGE PAVEMENT

S.L.M. STA 52+06

POINT "C" ✓ **FD** RESET MAG NAIL ONLY
 STA 52+06
 5.7' RT &
 17.4' LT E.O.P.
 "UNKNOWN ORIGIN"

POINT "D" ✓ **FD** RESET MAG NAIL + WASHER
 STA 52+06
 5.7' RT &
 17.4' TO LT E.O.P.

11-26-02 M.B.

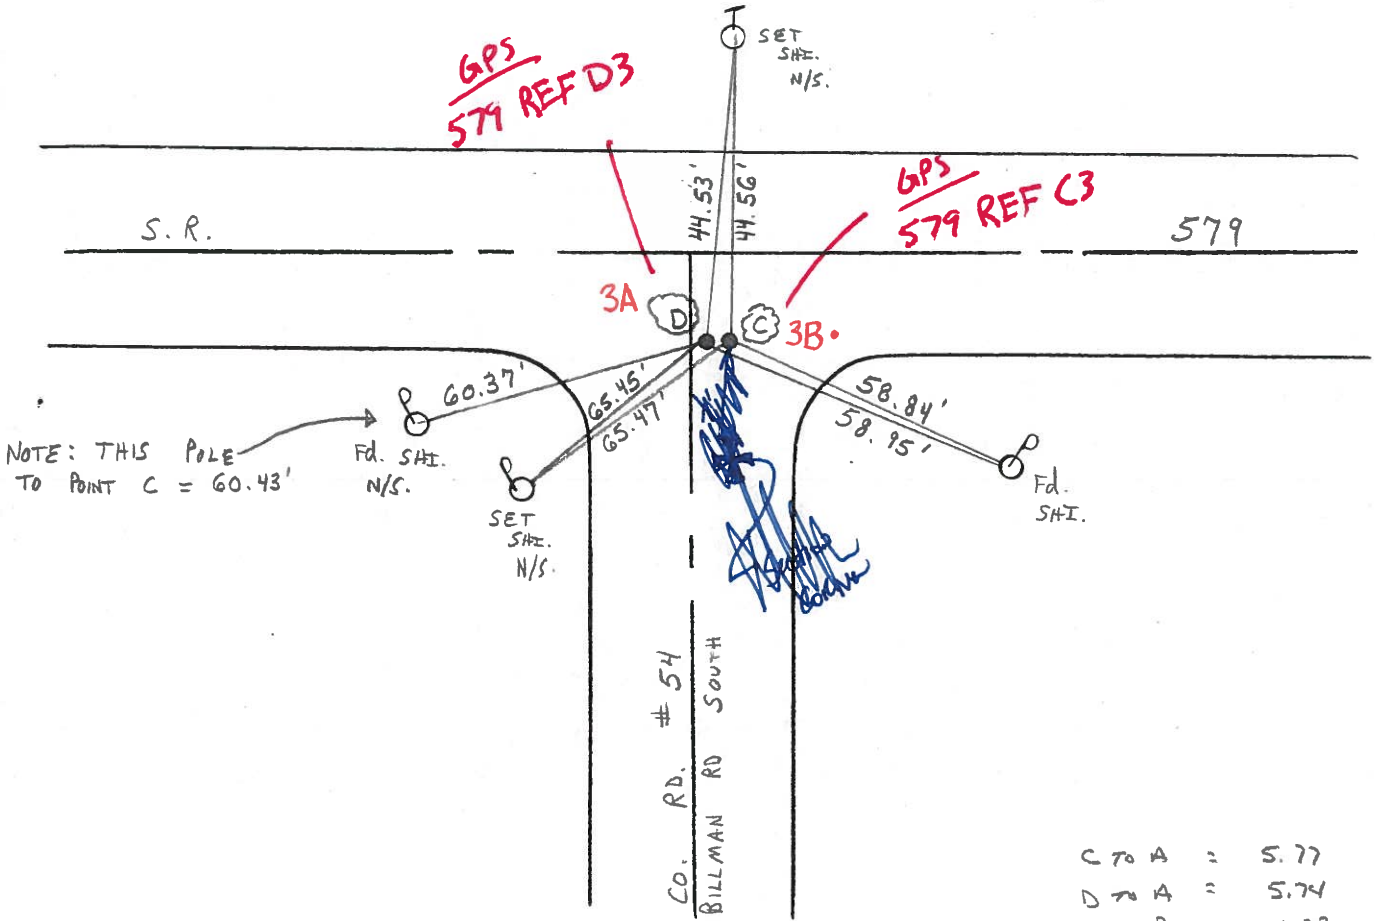

C TO A	=	5.77
D TO A	=	5.74
A TO B	=	39.33
B TO C	=	39.48
B TO D	=	39.96

O.D.O.T. DISTRICT 2 SURVEY OFFICE

PERSONNEL _____

REFERENCE NO. 3A

SHEET 4 OF 34

NOTES BARNHISEL

H.C. CANTERBURY

R.C. BARNHISEL

DATE 8-30-02

WEATHER SUNNY

TEMP. +72°


ROUTE S.R. 579

COUNTY OTTAWA

TOWNSHIP ALLEN

SECTION 6-31

T 9 N R 13 E

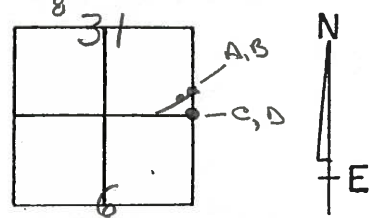

TYPE MONUMENT P.K. NAILS

ON SURFACE - ~~BELOW~~ SURFACE


~~LEFT- & PAV'T.~~ - RIGHT 5.7' RT &

~~Both~~ 17.4 TO LT EDGE PAVEMENT

S.L.M. STA 52+06

POINT "C"
 RESET MAG NAIL ONLY
 STA 52+06
 5.7' RT &
 17.4' LT E.O.P.
 "UNKNOWN ORIGIN"

POINT "D"
 RESET MAG NAIL + WASHER
 STA 52+06
 5.7' RT &
 17.4' TO LT E.O.P.
 Section Corner
 11-26-02 M.B.

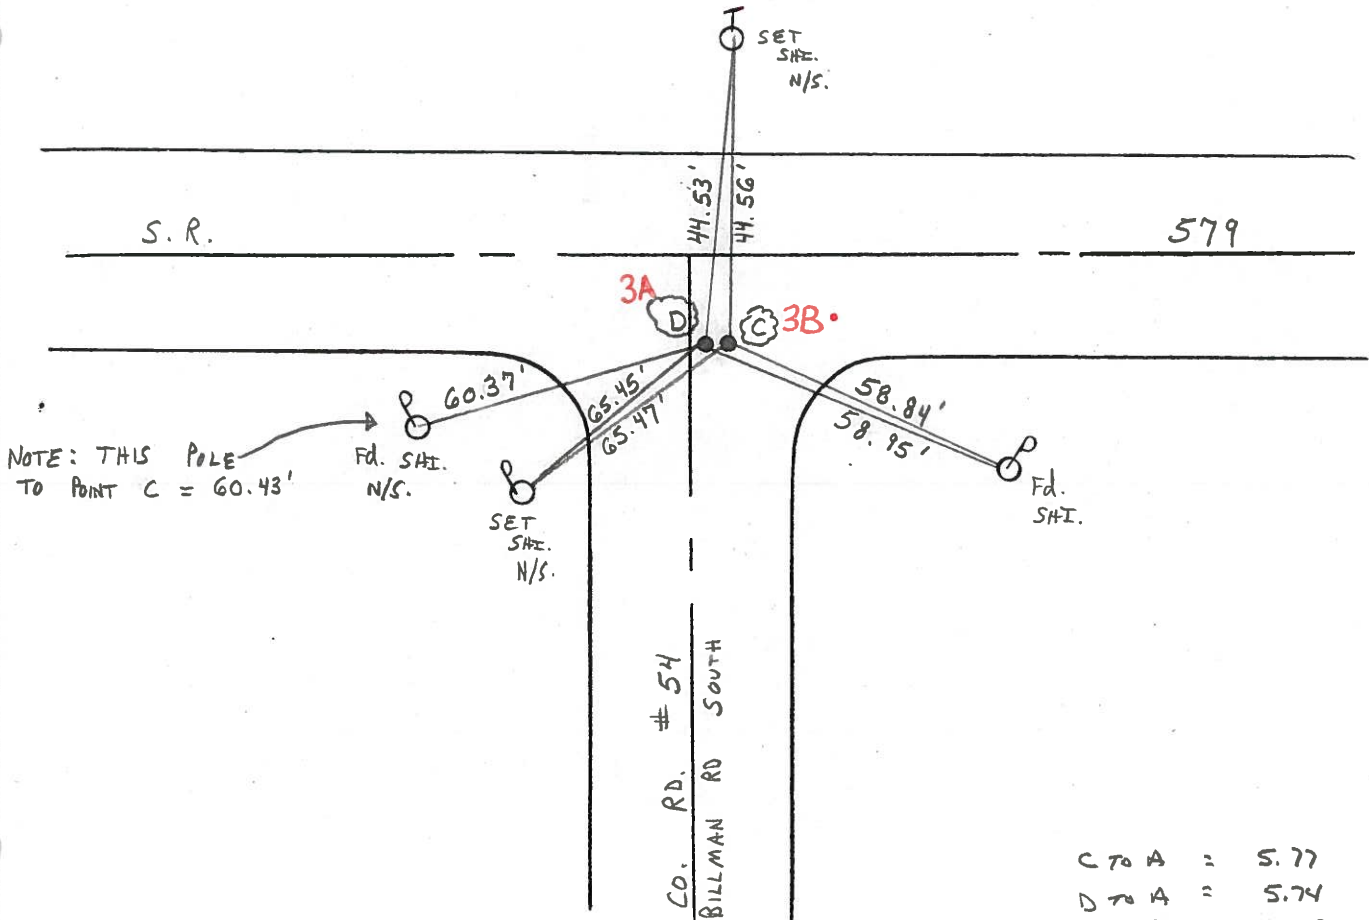

C TO A	=	5.77
D TO A	=	5.74
A TO B	=	39.33
B TO C	=	39.48
B TO D	=	39.96